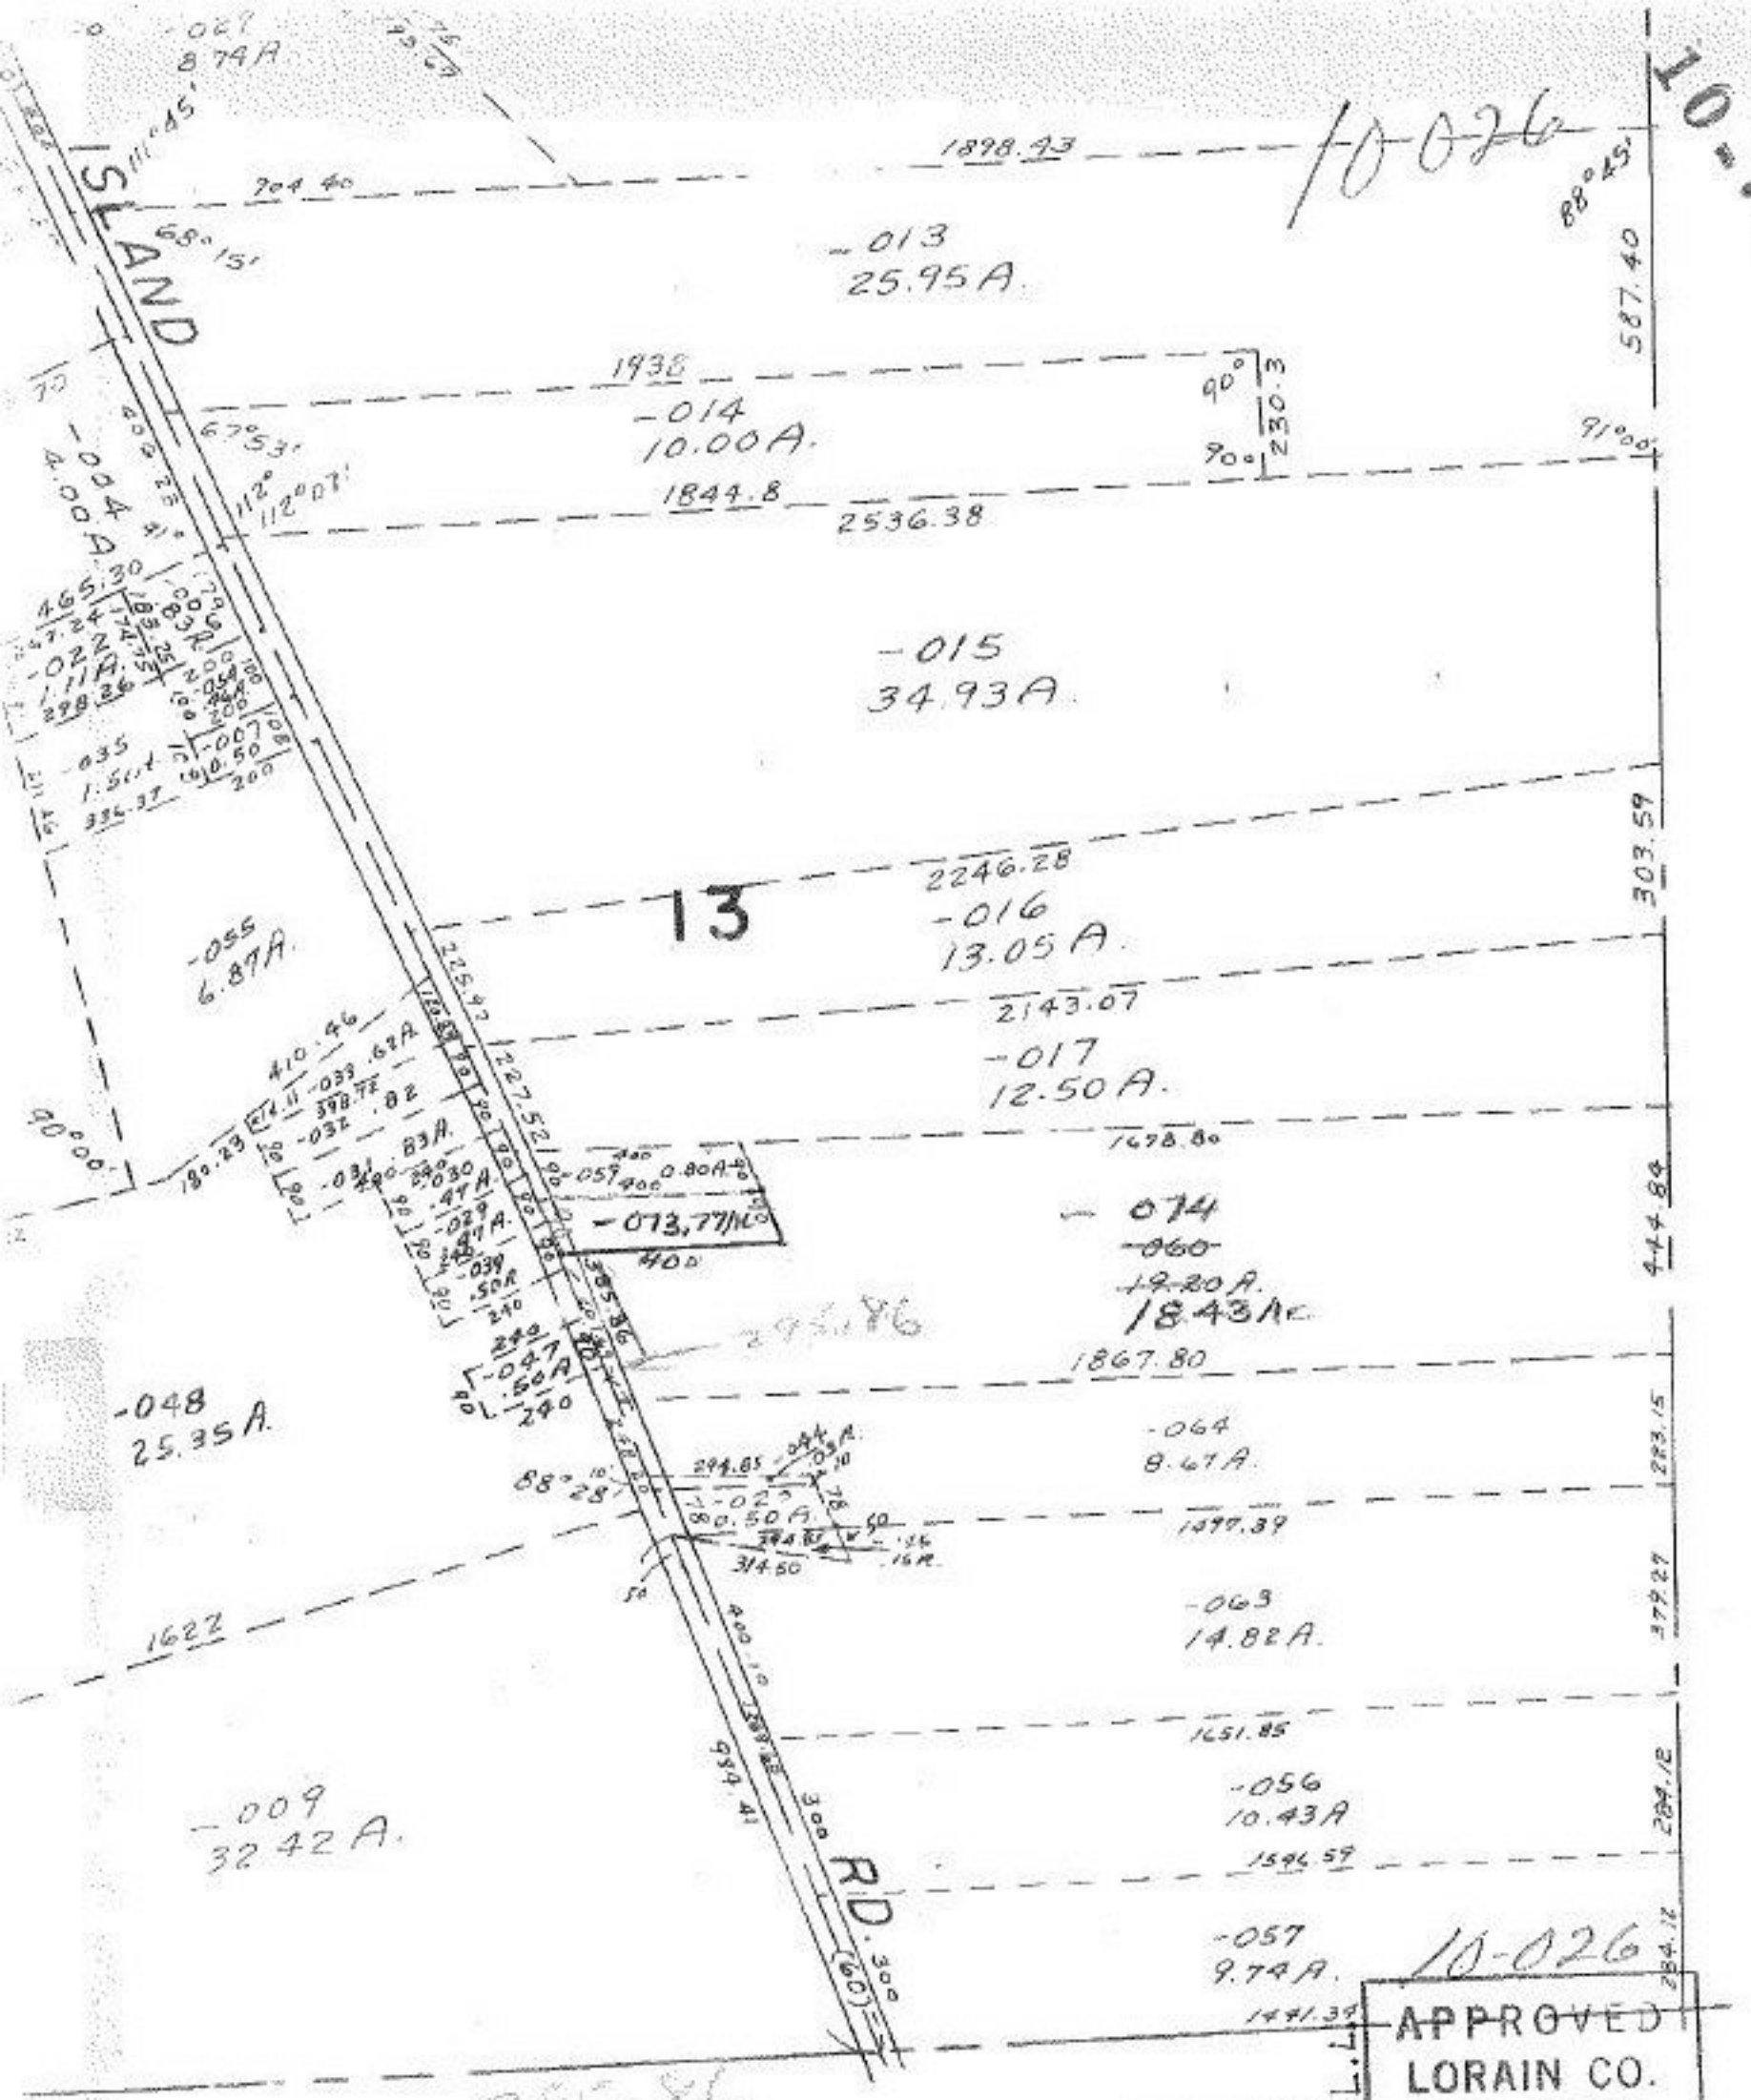
10-026
10-78
ISLAND
13
-013
25.95 A.
-014
10.00 A.
-015
34.93 A.
-016
13.05 A.
-017
12.50 A.
-074
18.43 Ac.
-064
8.67 A.
-063
14.82 A.
-056
10.43 A
-057
9.74 A.
-055
6.87 A.
-048
25.35 A.
-009
32.42 A.
-073,77 Ac
RD.
1898.43
1938
1844.8
2536.38
2246.28
2143.07
1678.80
1867.80
1497.39
1651.85
1546.59
1441.39
1622
587.40
303.59
444.84
283.15
379.27
284.12
284.12
1-C
385.86
90
295.86
OCT 13 1976
JAN 18 1977
APPROVED
LORAIN CO.
MAP DEPT.
DATE 10/13/76
PAGE 76
BY LWHall
VOID AFTER 1:30 PM