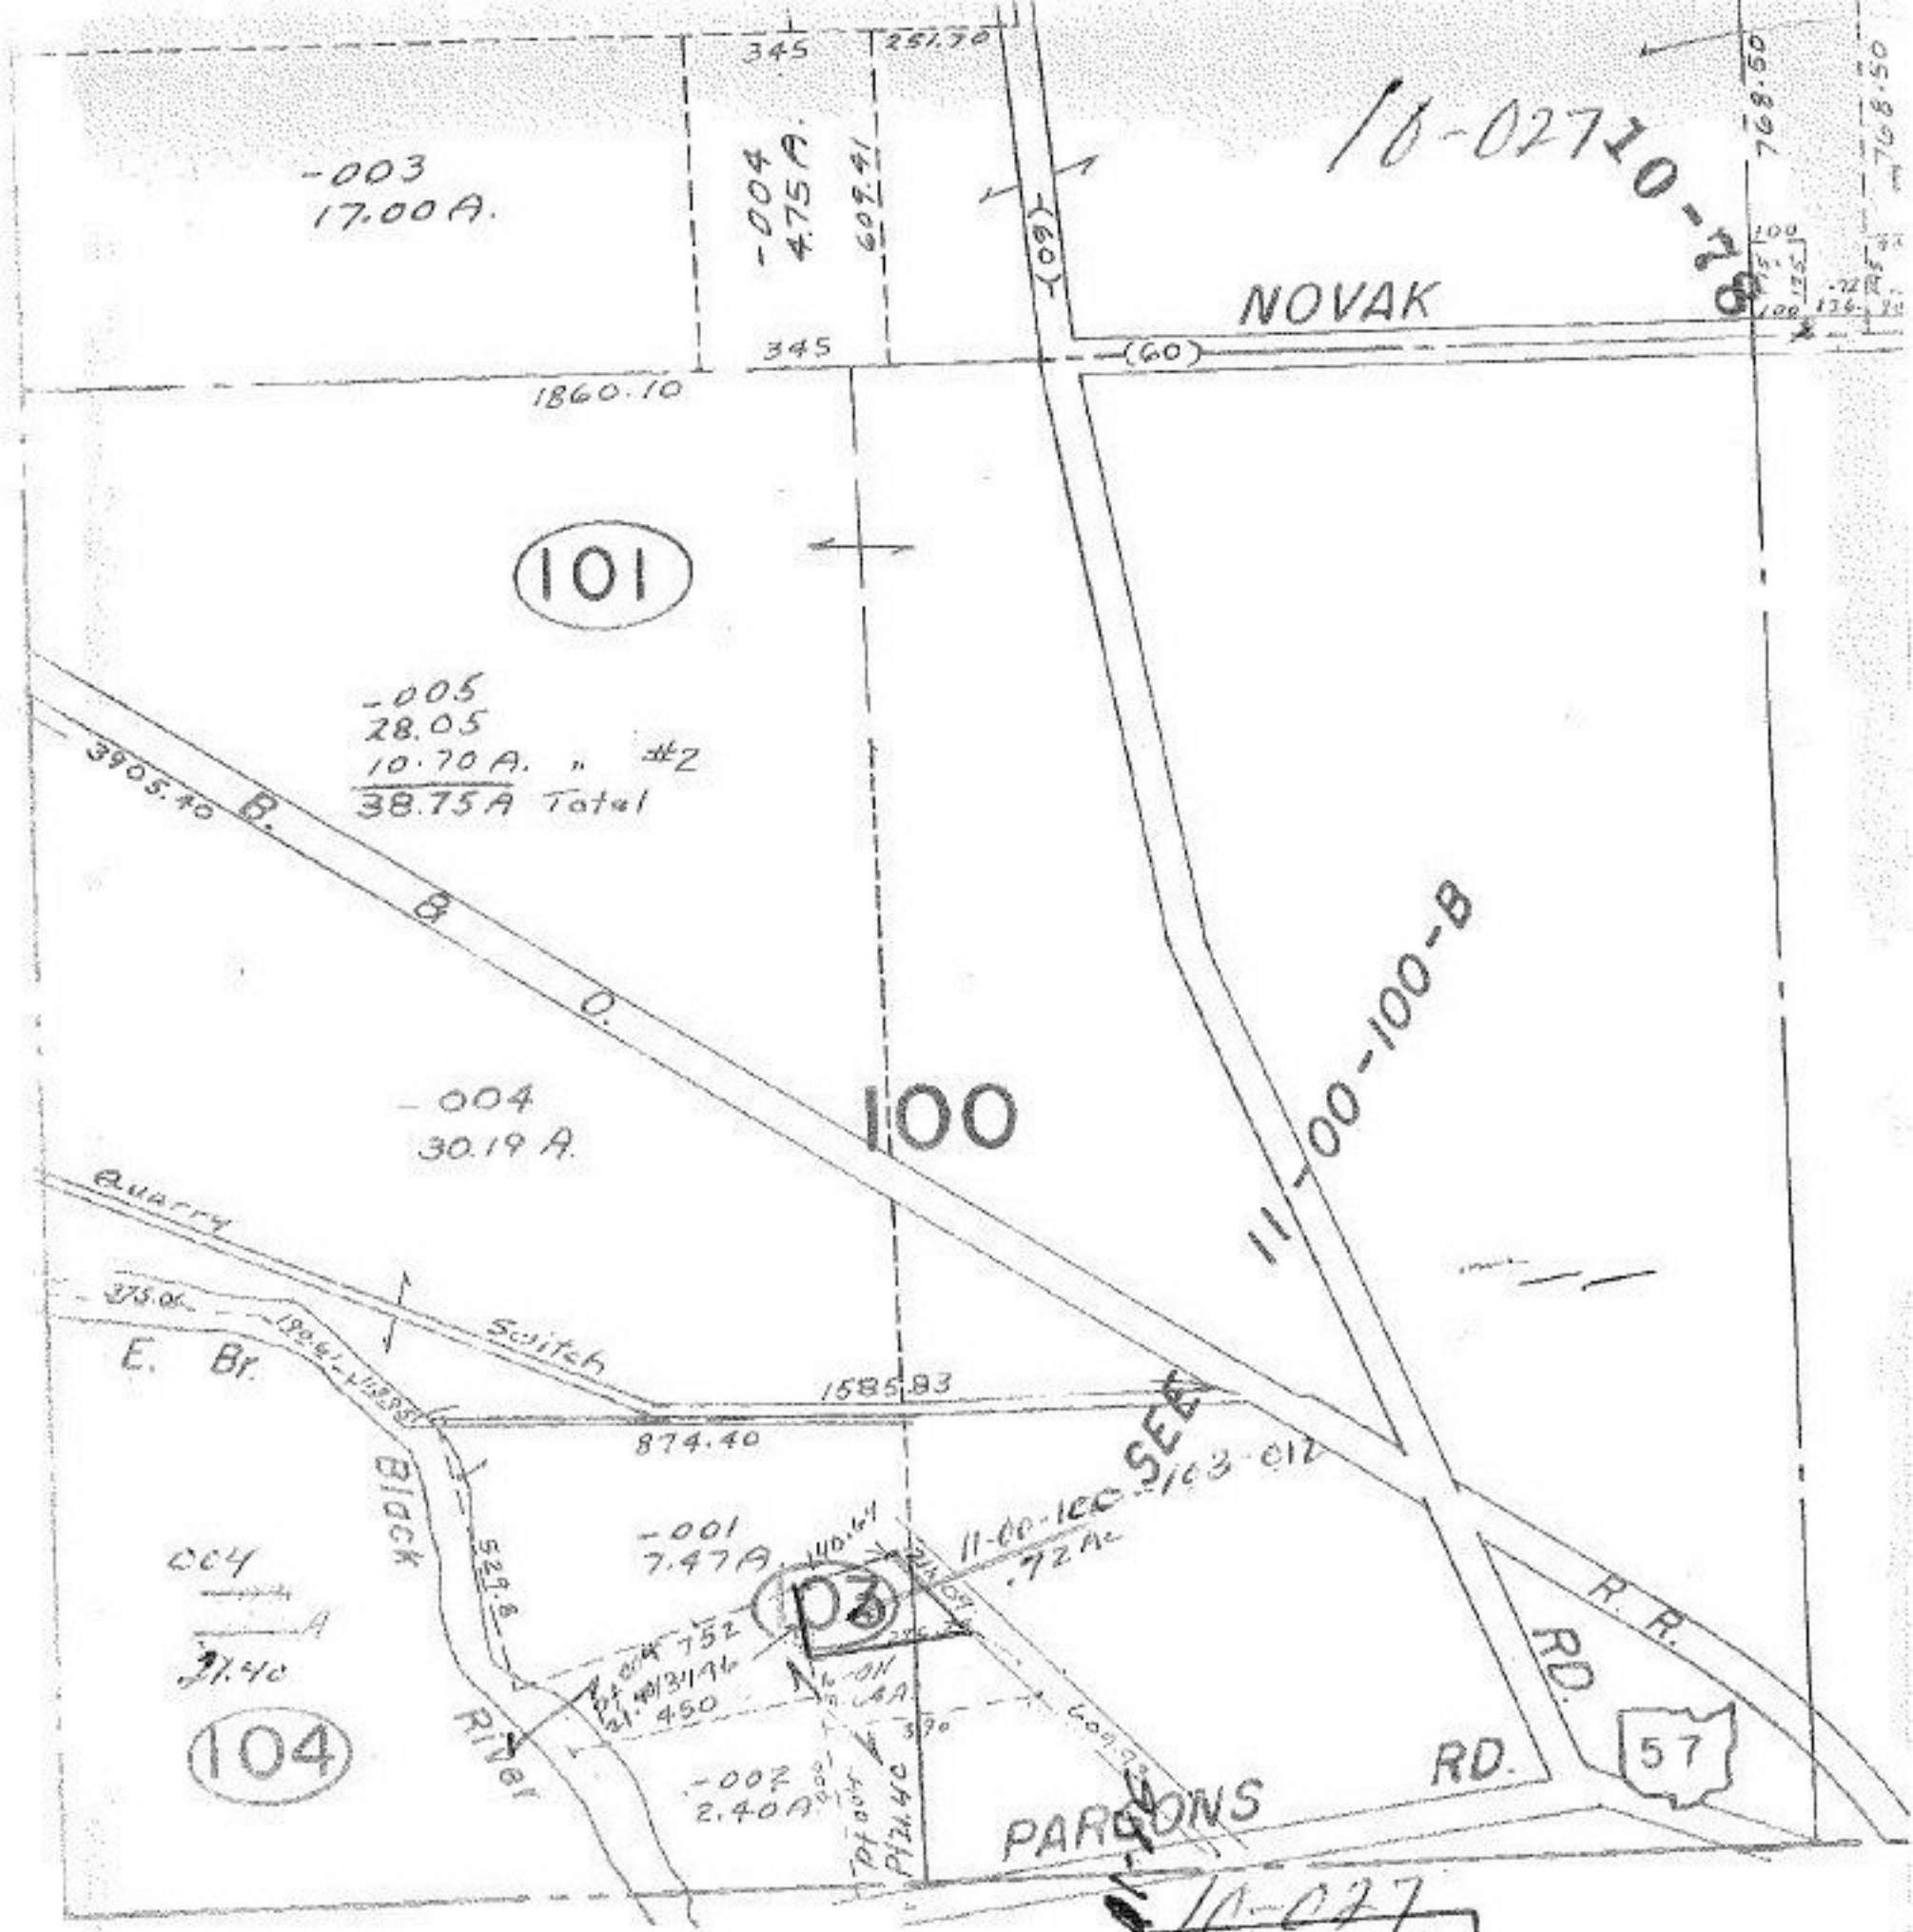

10-027

APPROVED
LORAIN CO.
MAP DEPT.
DATE 10/13/76
PAGE 11 E. South Pt
BY L. W. Hale
VOID AFTER 11:30 AM

OCT 13 1976

FEB 4 1977

EATON TWP