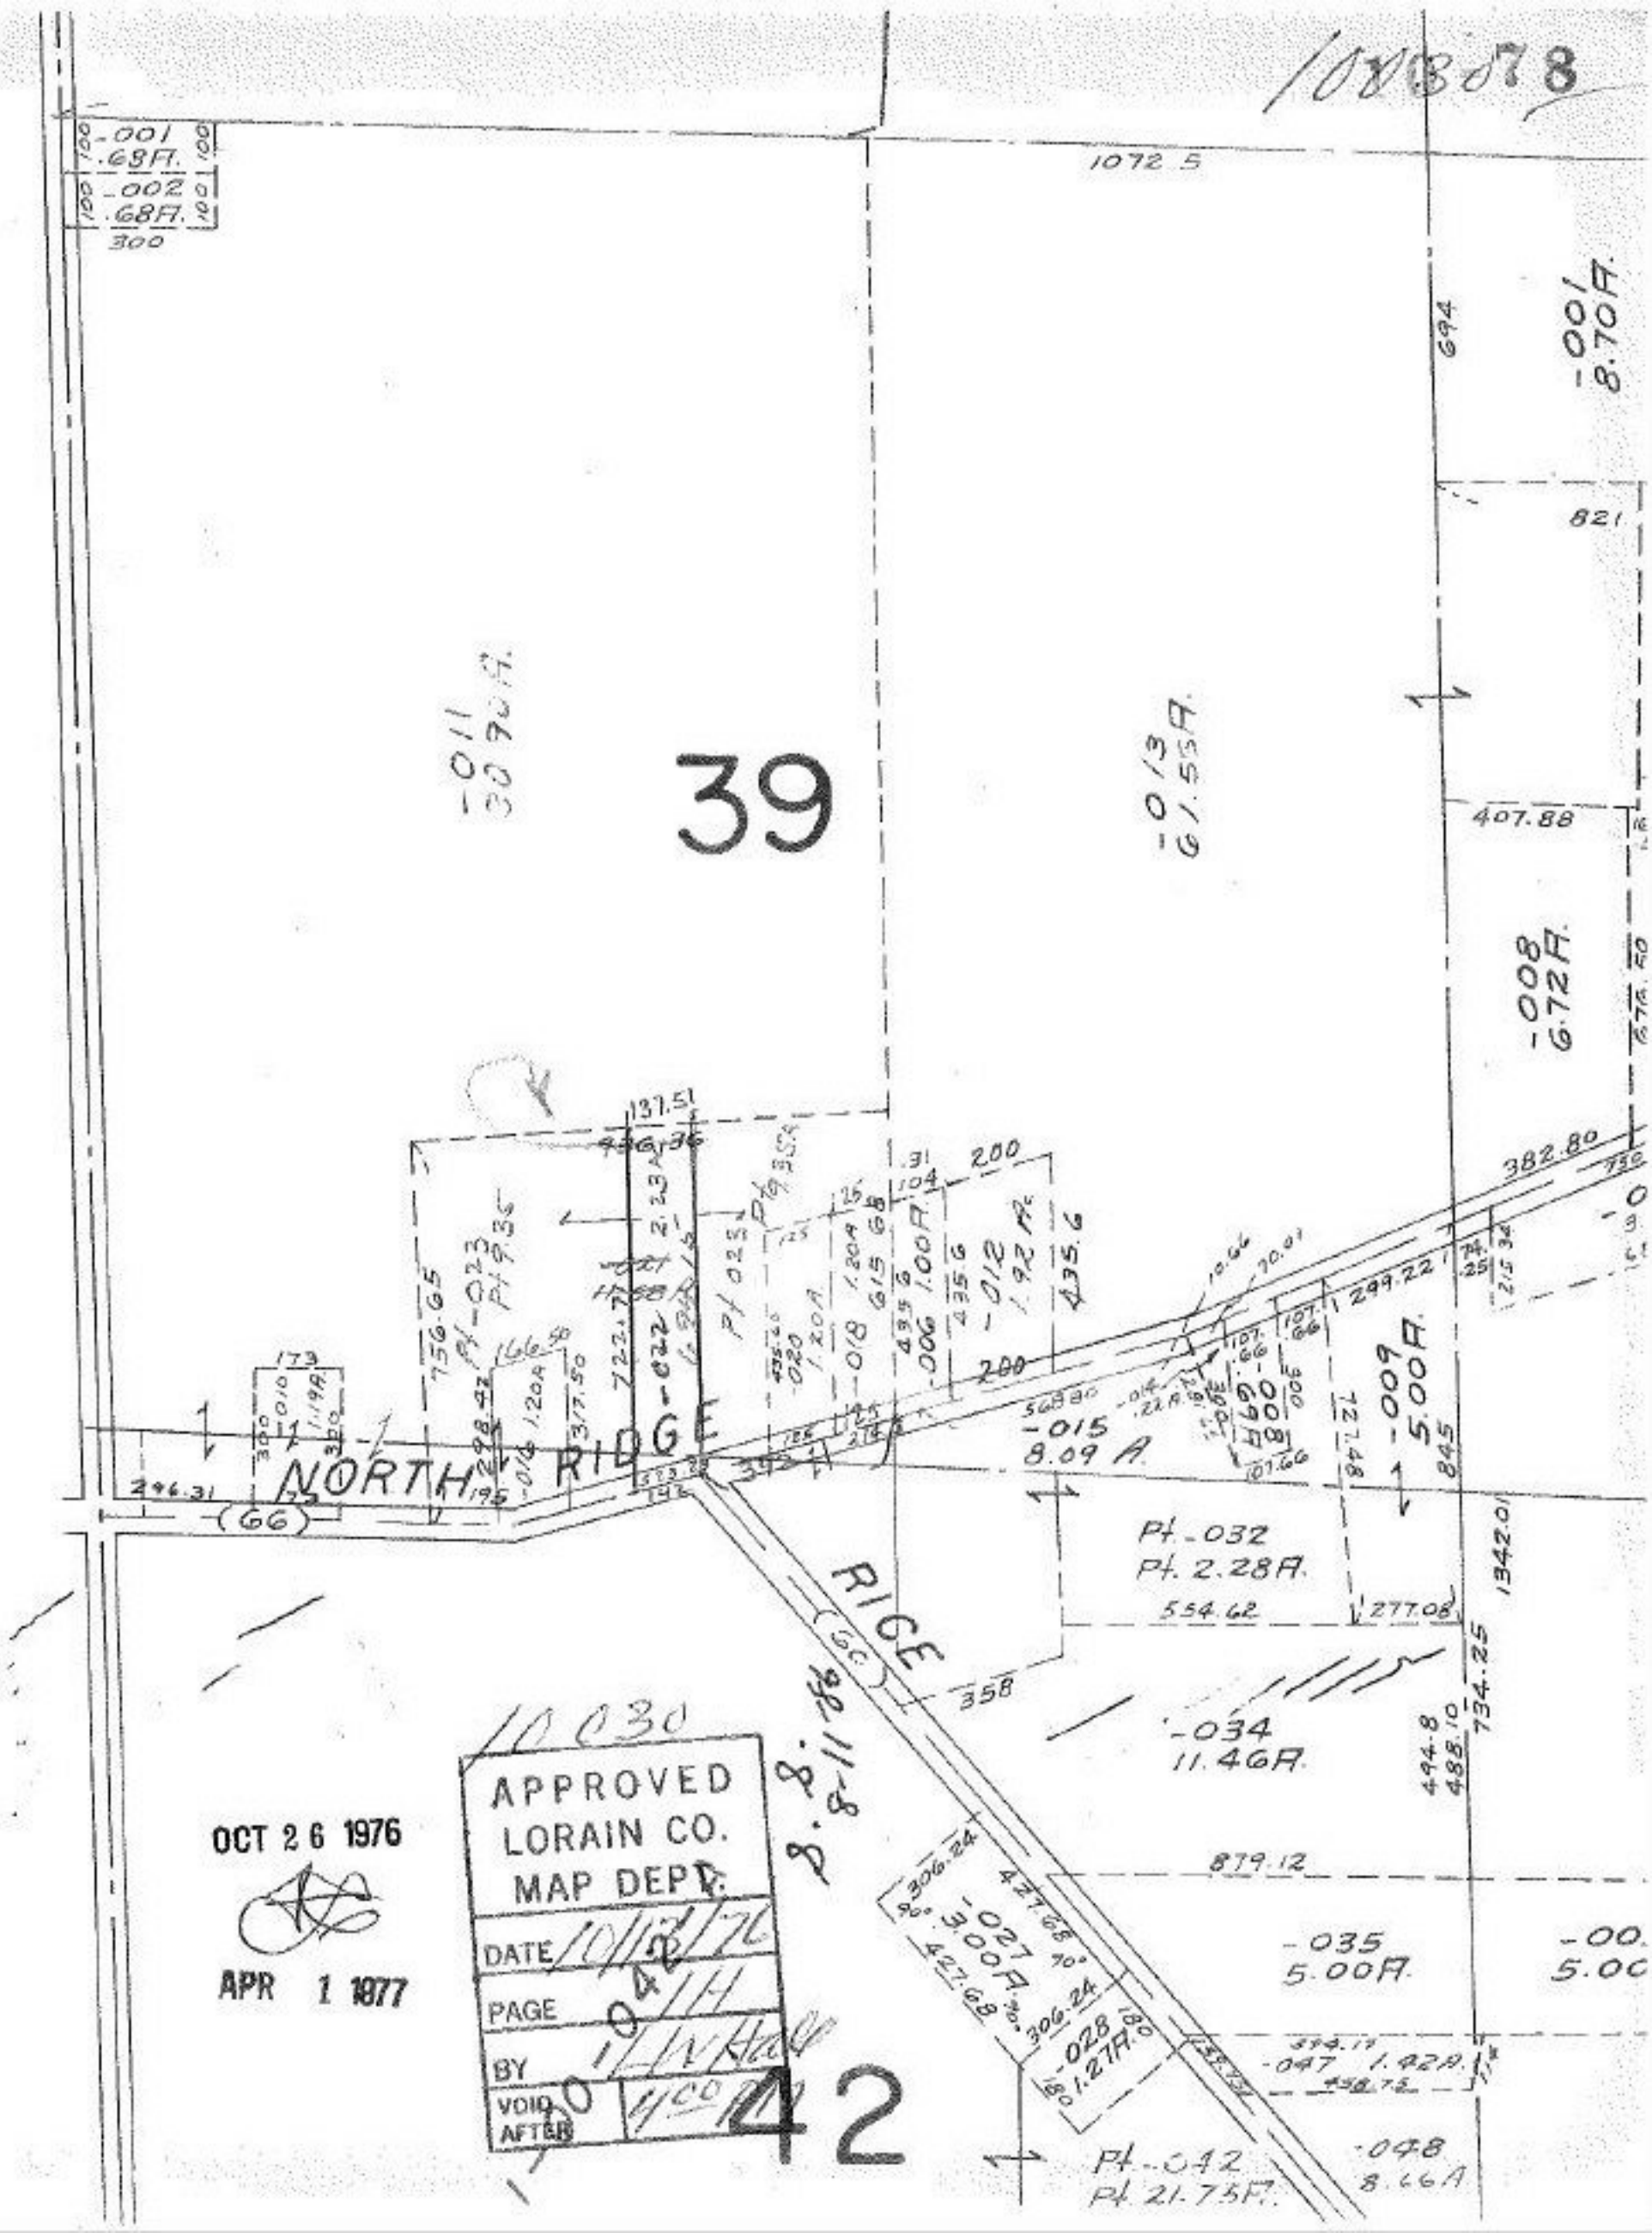

1003078
39
42
NORTH RIDGE
RICE
-001 .68A.
-002 .68A.
-011 30.90A.
-013 61.55A.
-001 8.70A.
-008 6.72A.
-009 5.00A.
-015 8.09 A.
-034 11.46A.
-035 5.00A.
-027 3.00A.
-028 1.27A.
-047 1.42A.
-048 8.66A
Pt.-032 Pt. 2.28A.
Pt.-042 Pt. 21.75A.
1072.5
694
821
407.88
382.80
299.22
1342.01
734.25
879.12
554.62
277.08
358
200
137.51
296.31
(66)
(60)
10030
APPROVED
LORAIN CO.
MAP DEPT.
DATE 10/12/76
PAGE 1/H
BY
VOID AFTER
OCT 26 1976
APR 1 1977