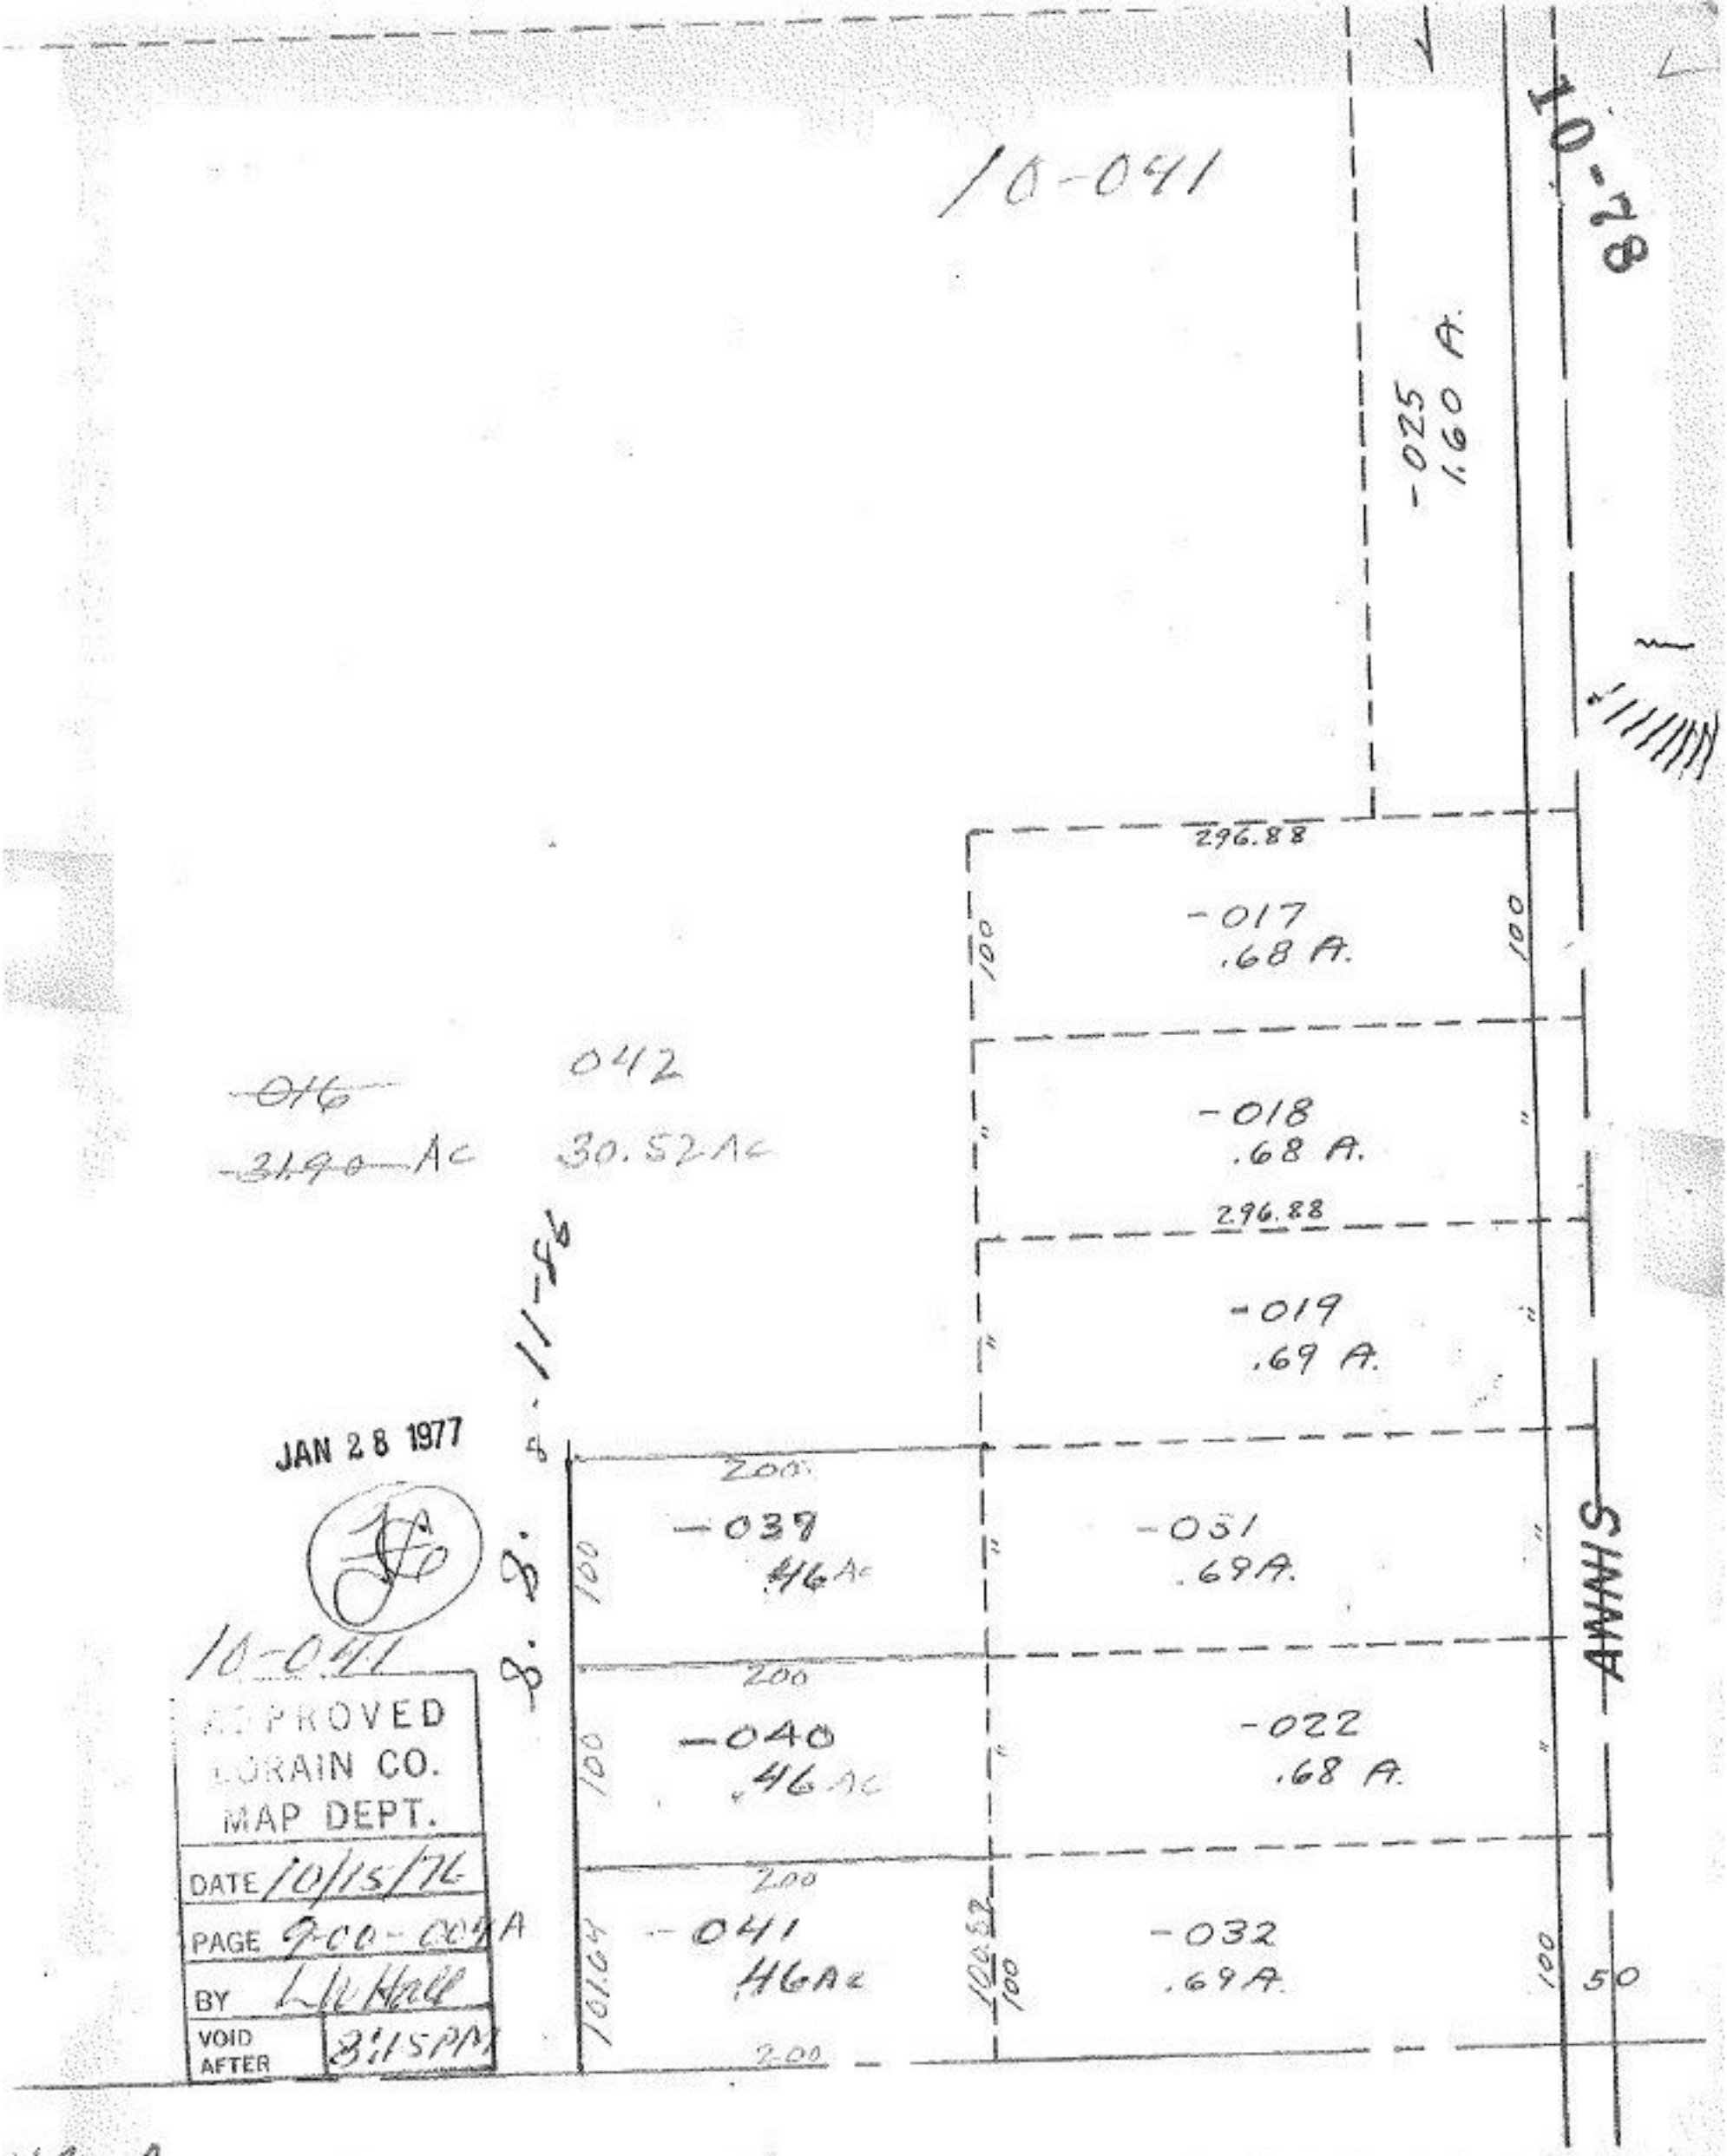
10-041
10-78
-025
1.60 A.
296.88
-017
.68 A.
100
100
-018
.68 A.
296.88
-019
.69 A.
042
~~016~~
~~31.90~~ Ac
30.52 Ac
8.8.11-86
JAN 28 1977
200
-039
.46 Ac
-031
.69 A.
100
200
-040
.46 Ac
-022
.68 A.
100
200
-041
.46 Ac
-032
.69 A.
101.64
100.82
100
100
50
200
ANNIS
10-041
APPROVED
LORAIN CO.
MAP DEPT.
DATE 10/15/76
PAGE 9-00-004A
BY L.W. Hall
VOID AFTER 8:15PM

014-A