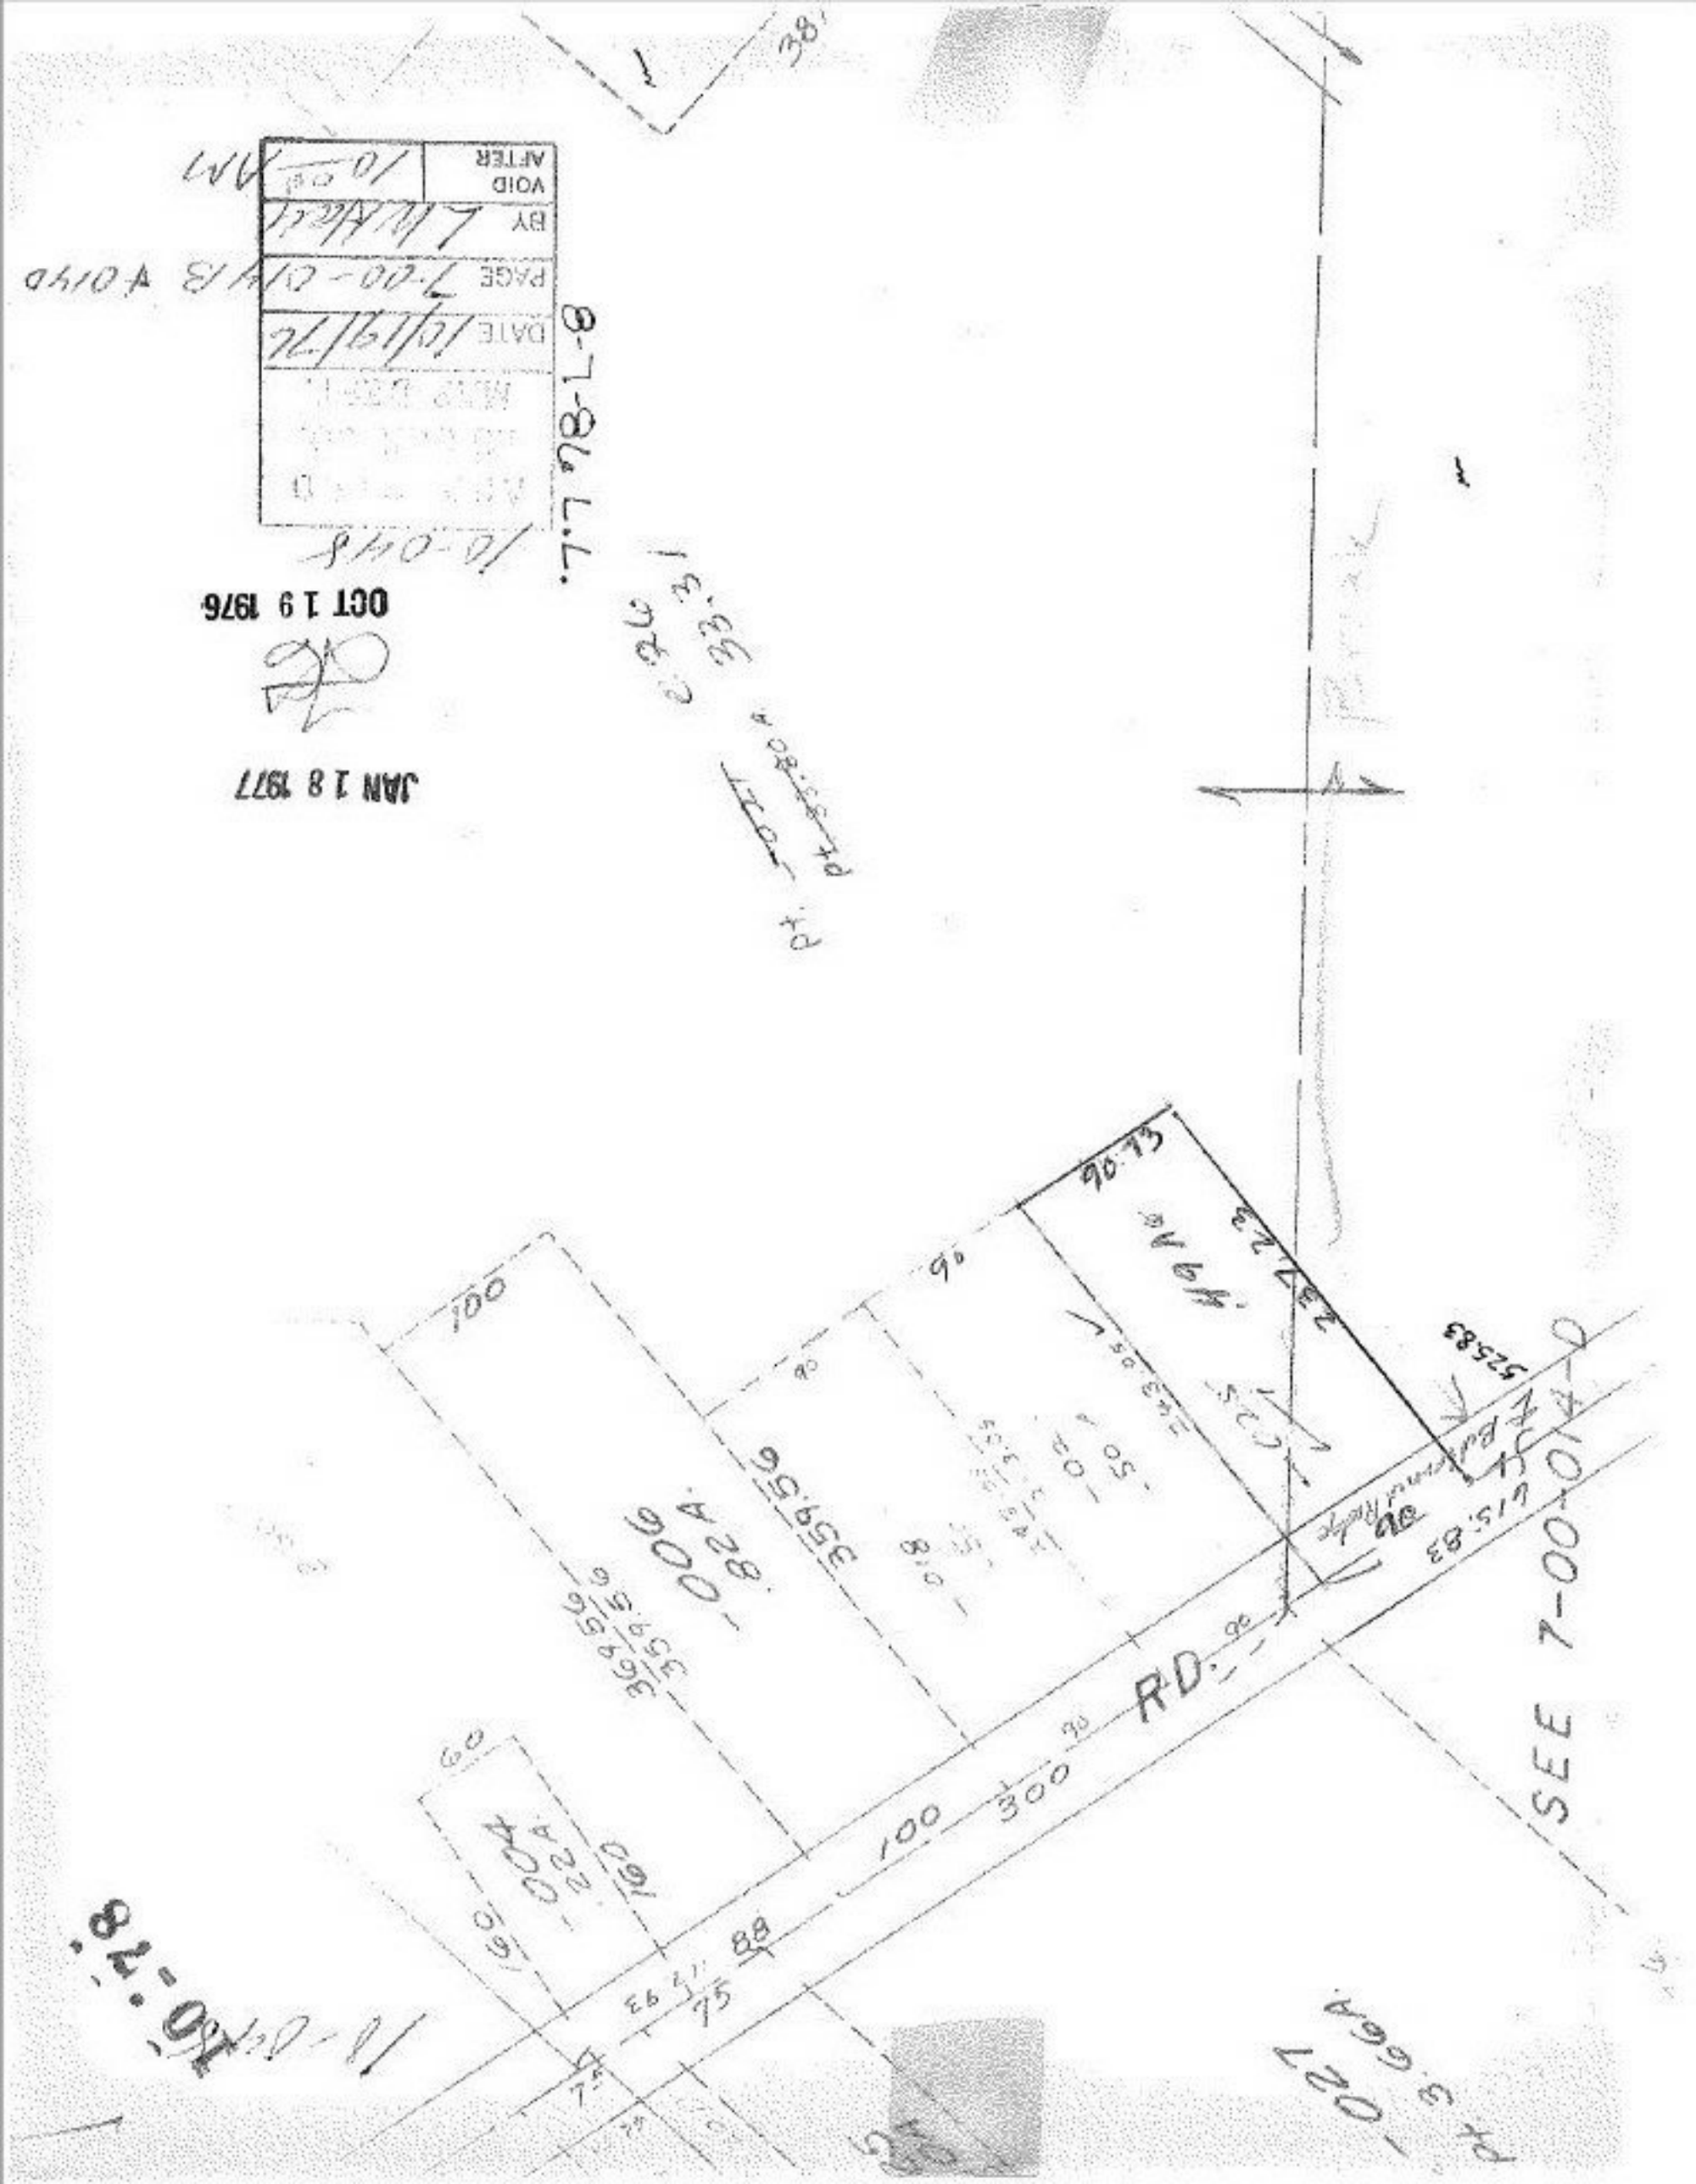

JAN 18 1977
OCT 19 1976
10-048
7.7.78-L-8
DATE 10/19/76
PAGE 7-00-014B
BY
VOID AFTER
10 AM
RD.
100
300
100
88
75
60
160
359.56
90.73
237.23
525.83
615.83
SEE 7-00-014-D
10-78