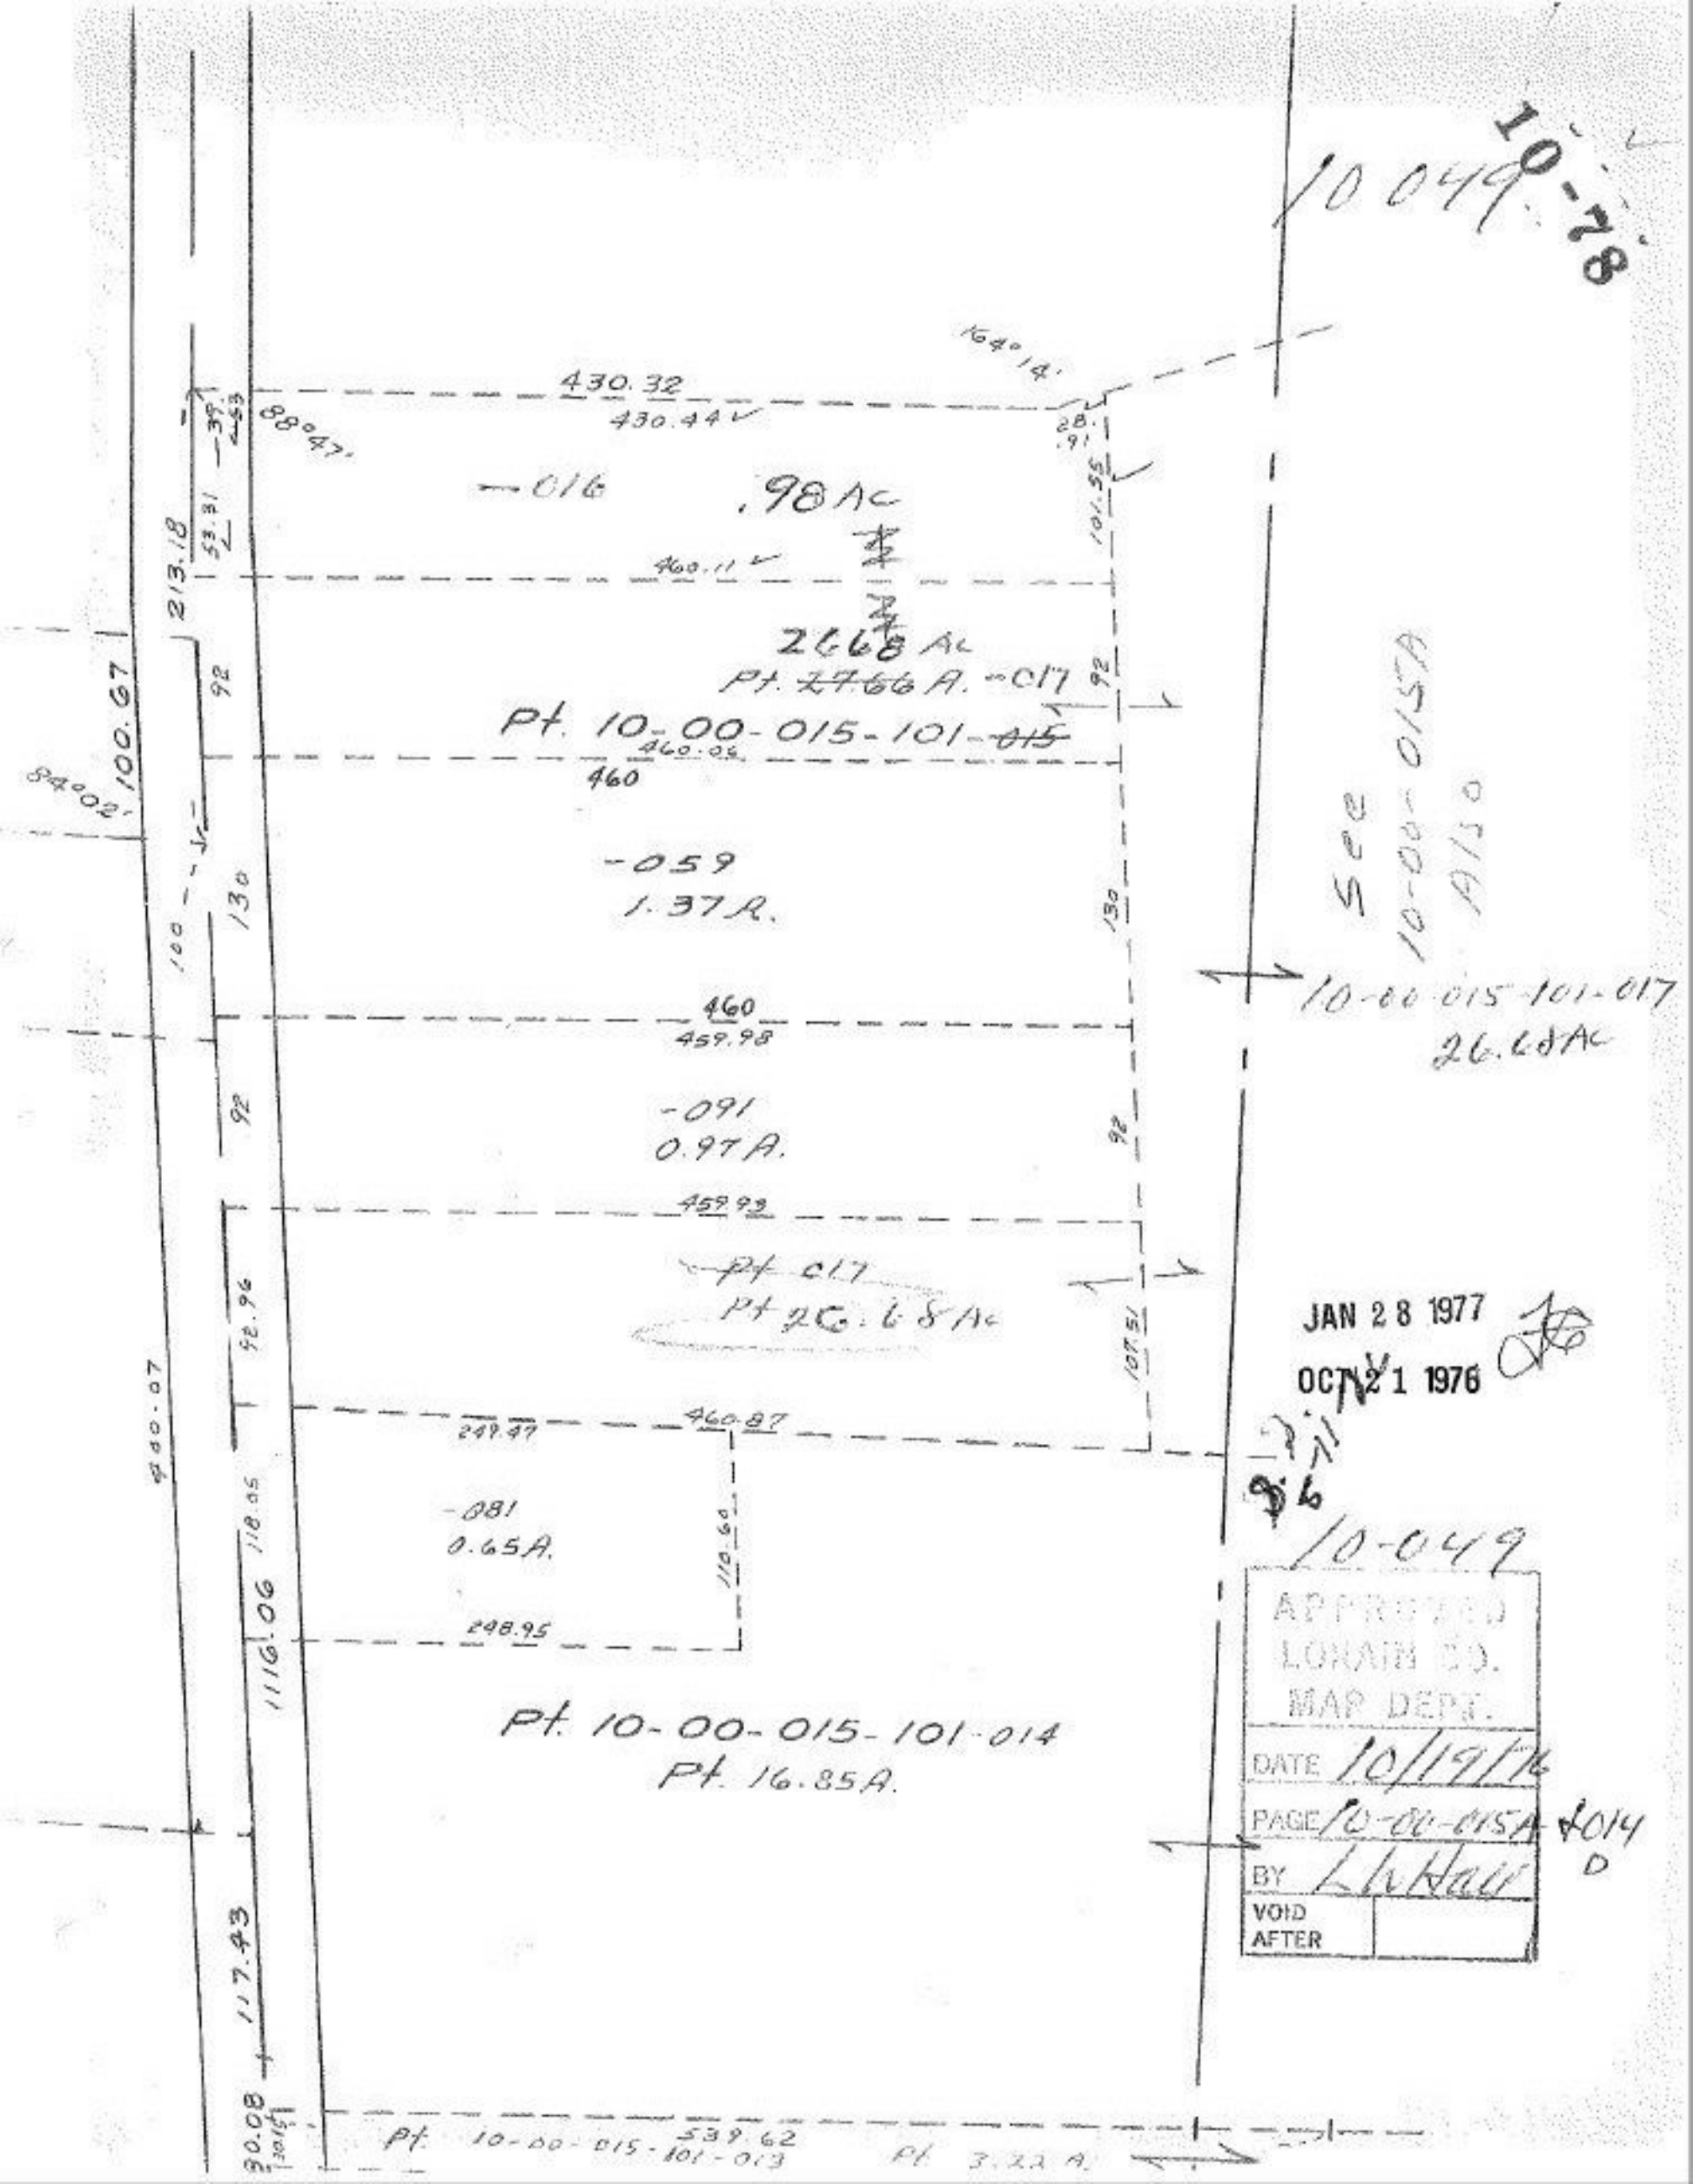
10-78
10 049
430.32
430.44
164°14'
88°47'
-016
.98 AC
460.11
2668 AC
Pt. ~~27.66~~ A. -017
Pt. 10-00-015-101-~~015~~
460.06
460
-059
1.37 A.
460
459.98
-091
0.97 A.
459.93
Pt. 017
Pt 26.68 AC
460.87
249.47
-081
0.65 A.
248.95
Pt. 10-00-015-101-014
Pt. 16.85 A.
Pt. 10-00-015-101-013
539.62
Pt. 3.22 A.
213.18
100.67
84°02'
100
130
92
92.96
118.05
1116.06
117.43
30.08
400.07
101.55
107.51
110.60
See 10-00-015A Also
10-00-015-101-017
26.68 AC
JAN 28 1977
OCT 21 1976
10-049
APPROVED
LORAIN CO.
MAP DEPT.
DATE 10/19/76
PAGE 10-00-015A & 014 D
BY L.W. Hall
VOID AFTER