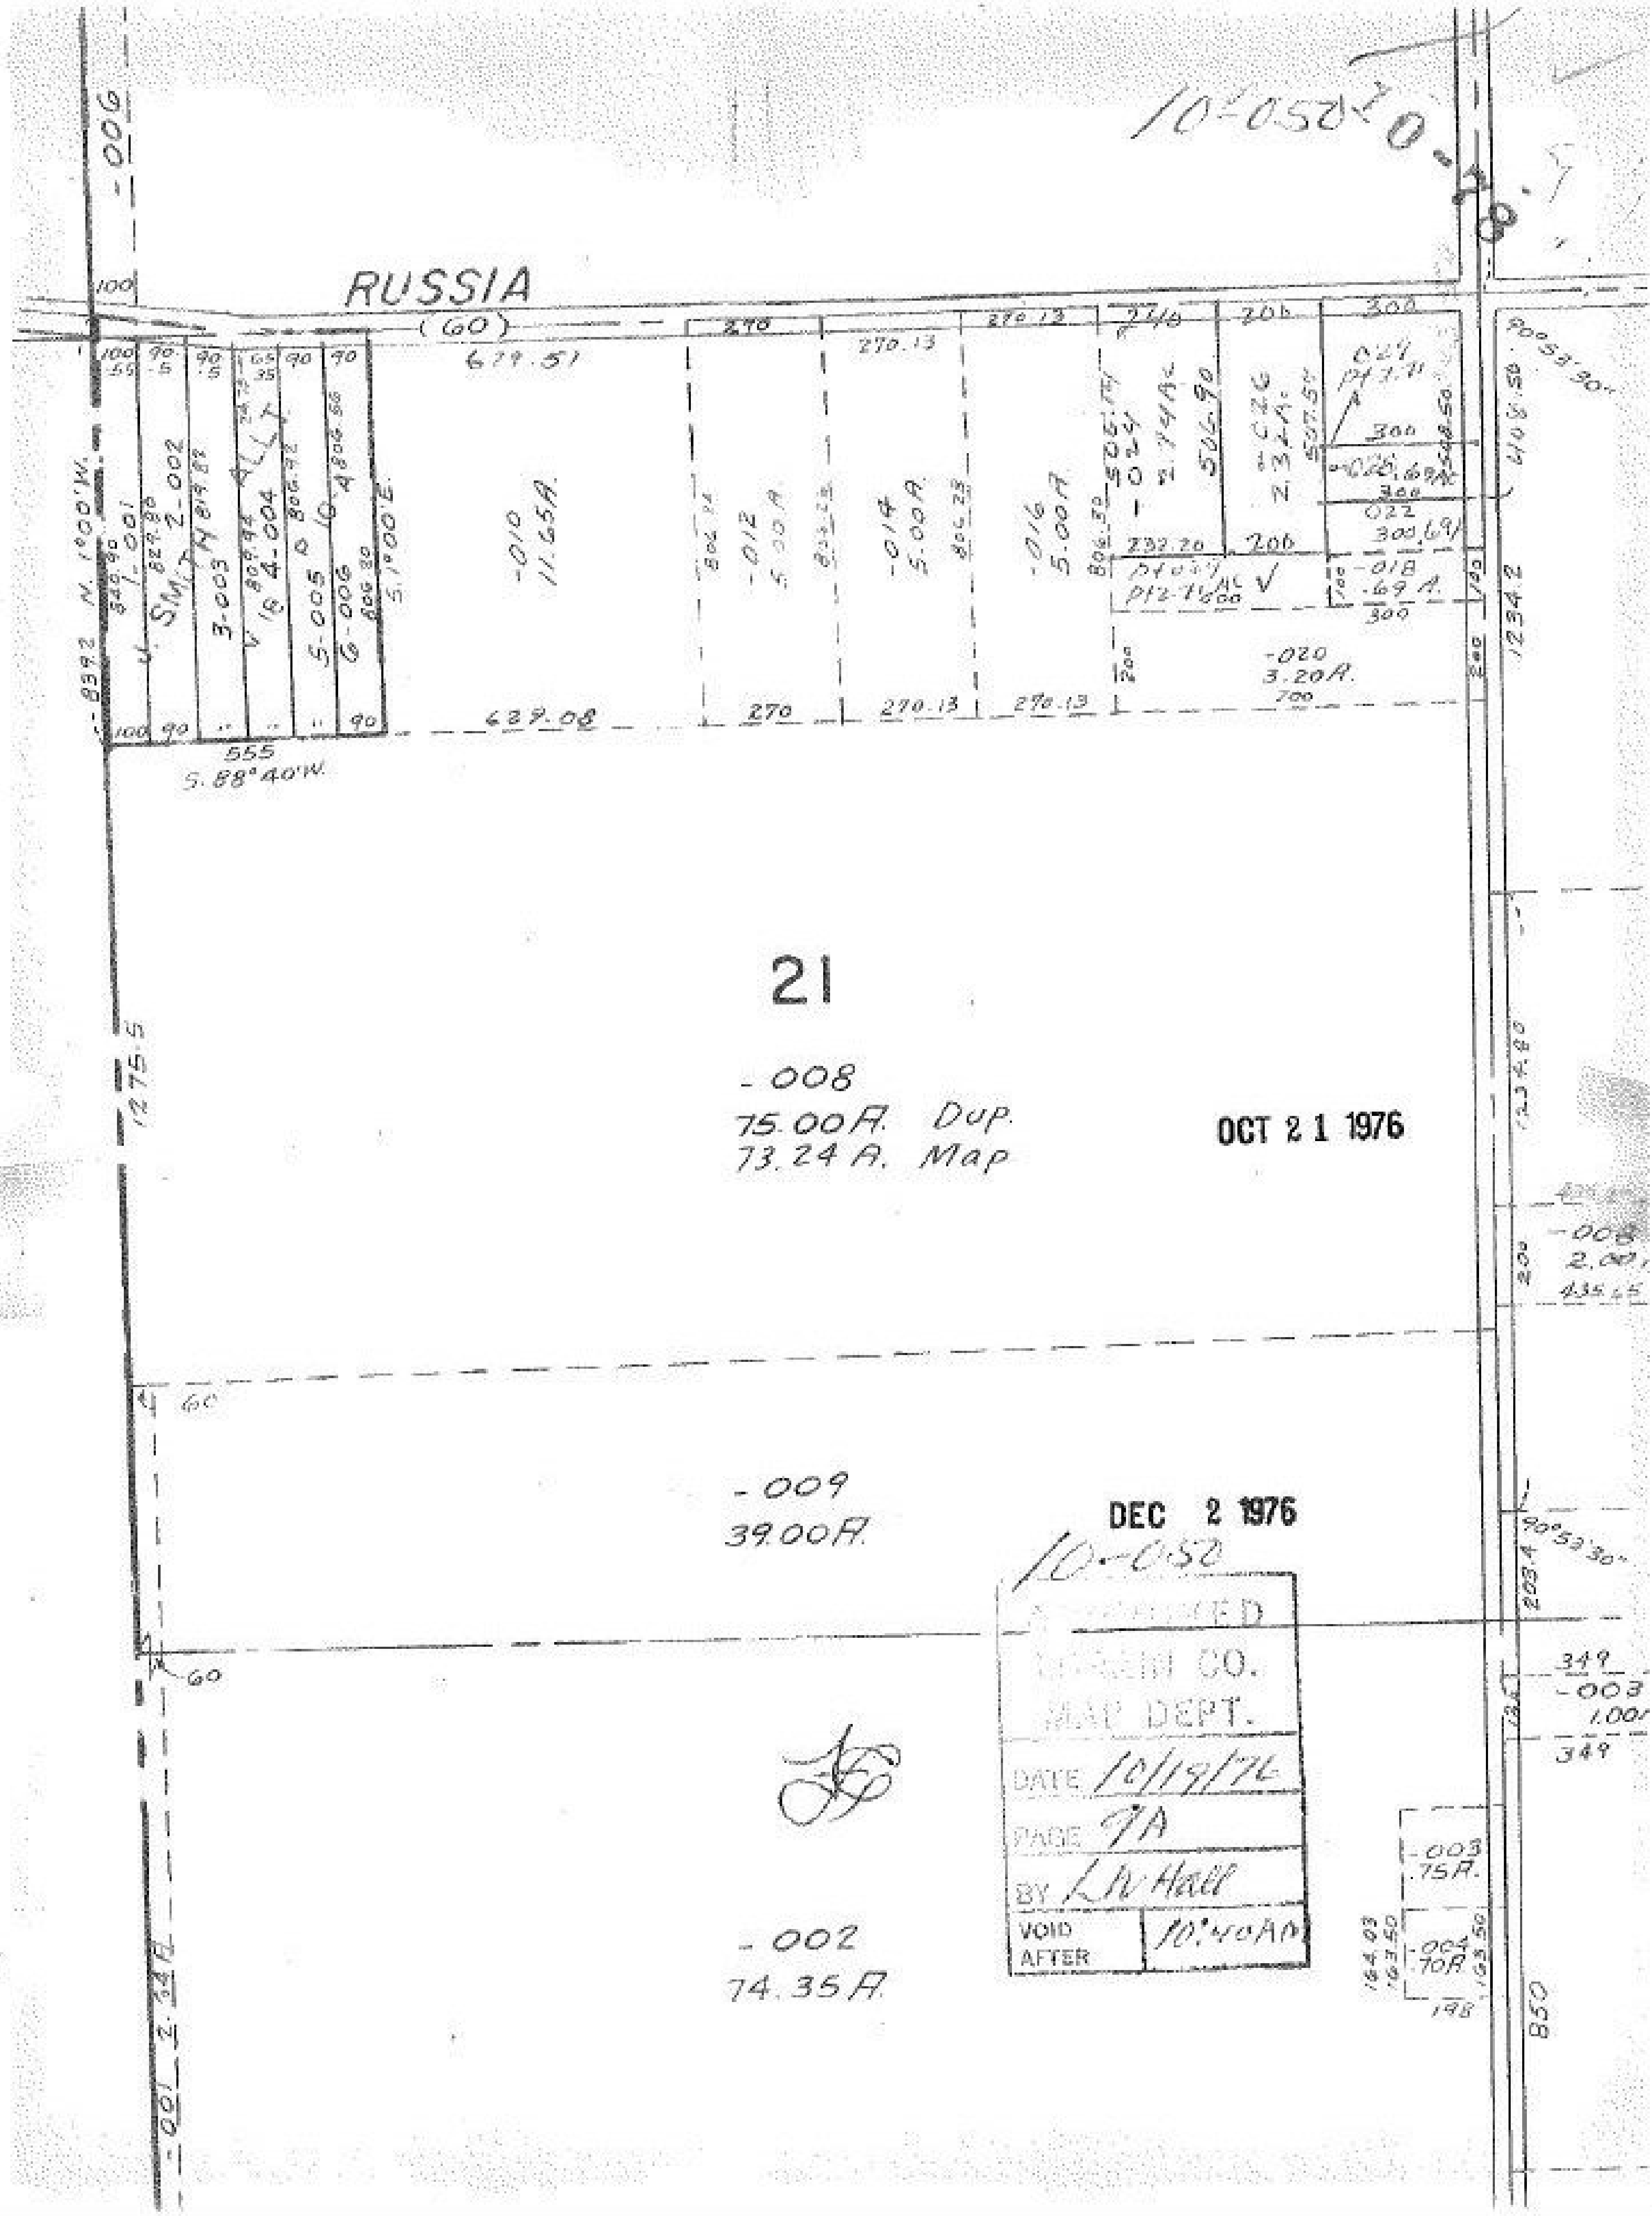
10-050
RUSSIA
(60)
21
-008
75.00 A. Dup.
73.24 A. Map
OCT 21 1976
-009
39.00 A.
DEC 2 1976
-002
74.35 A.
-010
11.65 A.
-012
5.00 A
-014
5.00 A.
-016
5.00 A
-020
3.20 A.
-018
.69 A.
555
S. 88°40'W.
679.51
639.08
270
270.13
1234.2
850
-003
.75 A.
-004
.70 A.
MAP DEPT.
DATE 10/19/76
PAGE 9A
BY L.W. Hall
VOID AFTER
10:40 AM