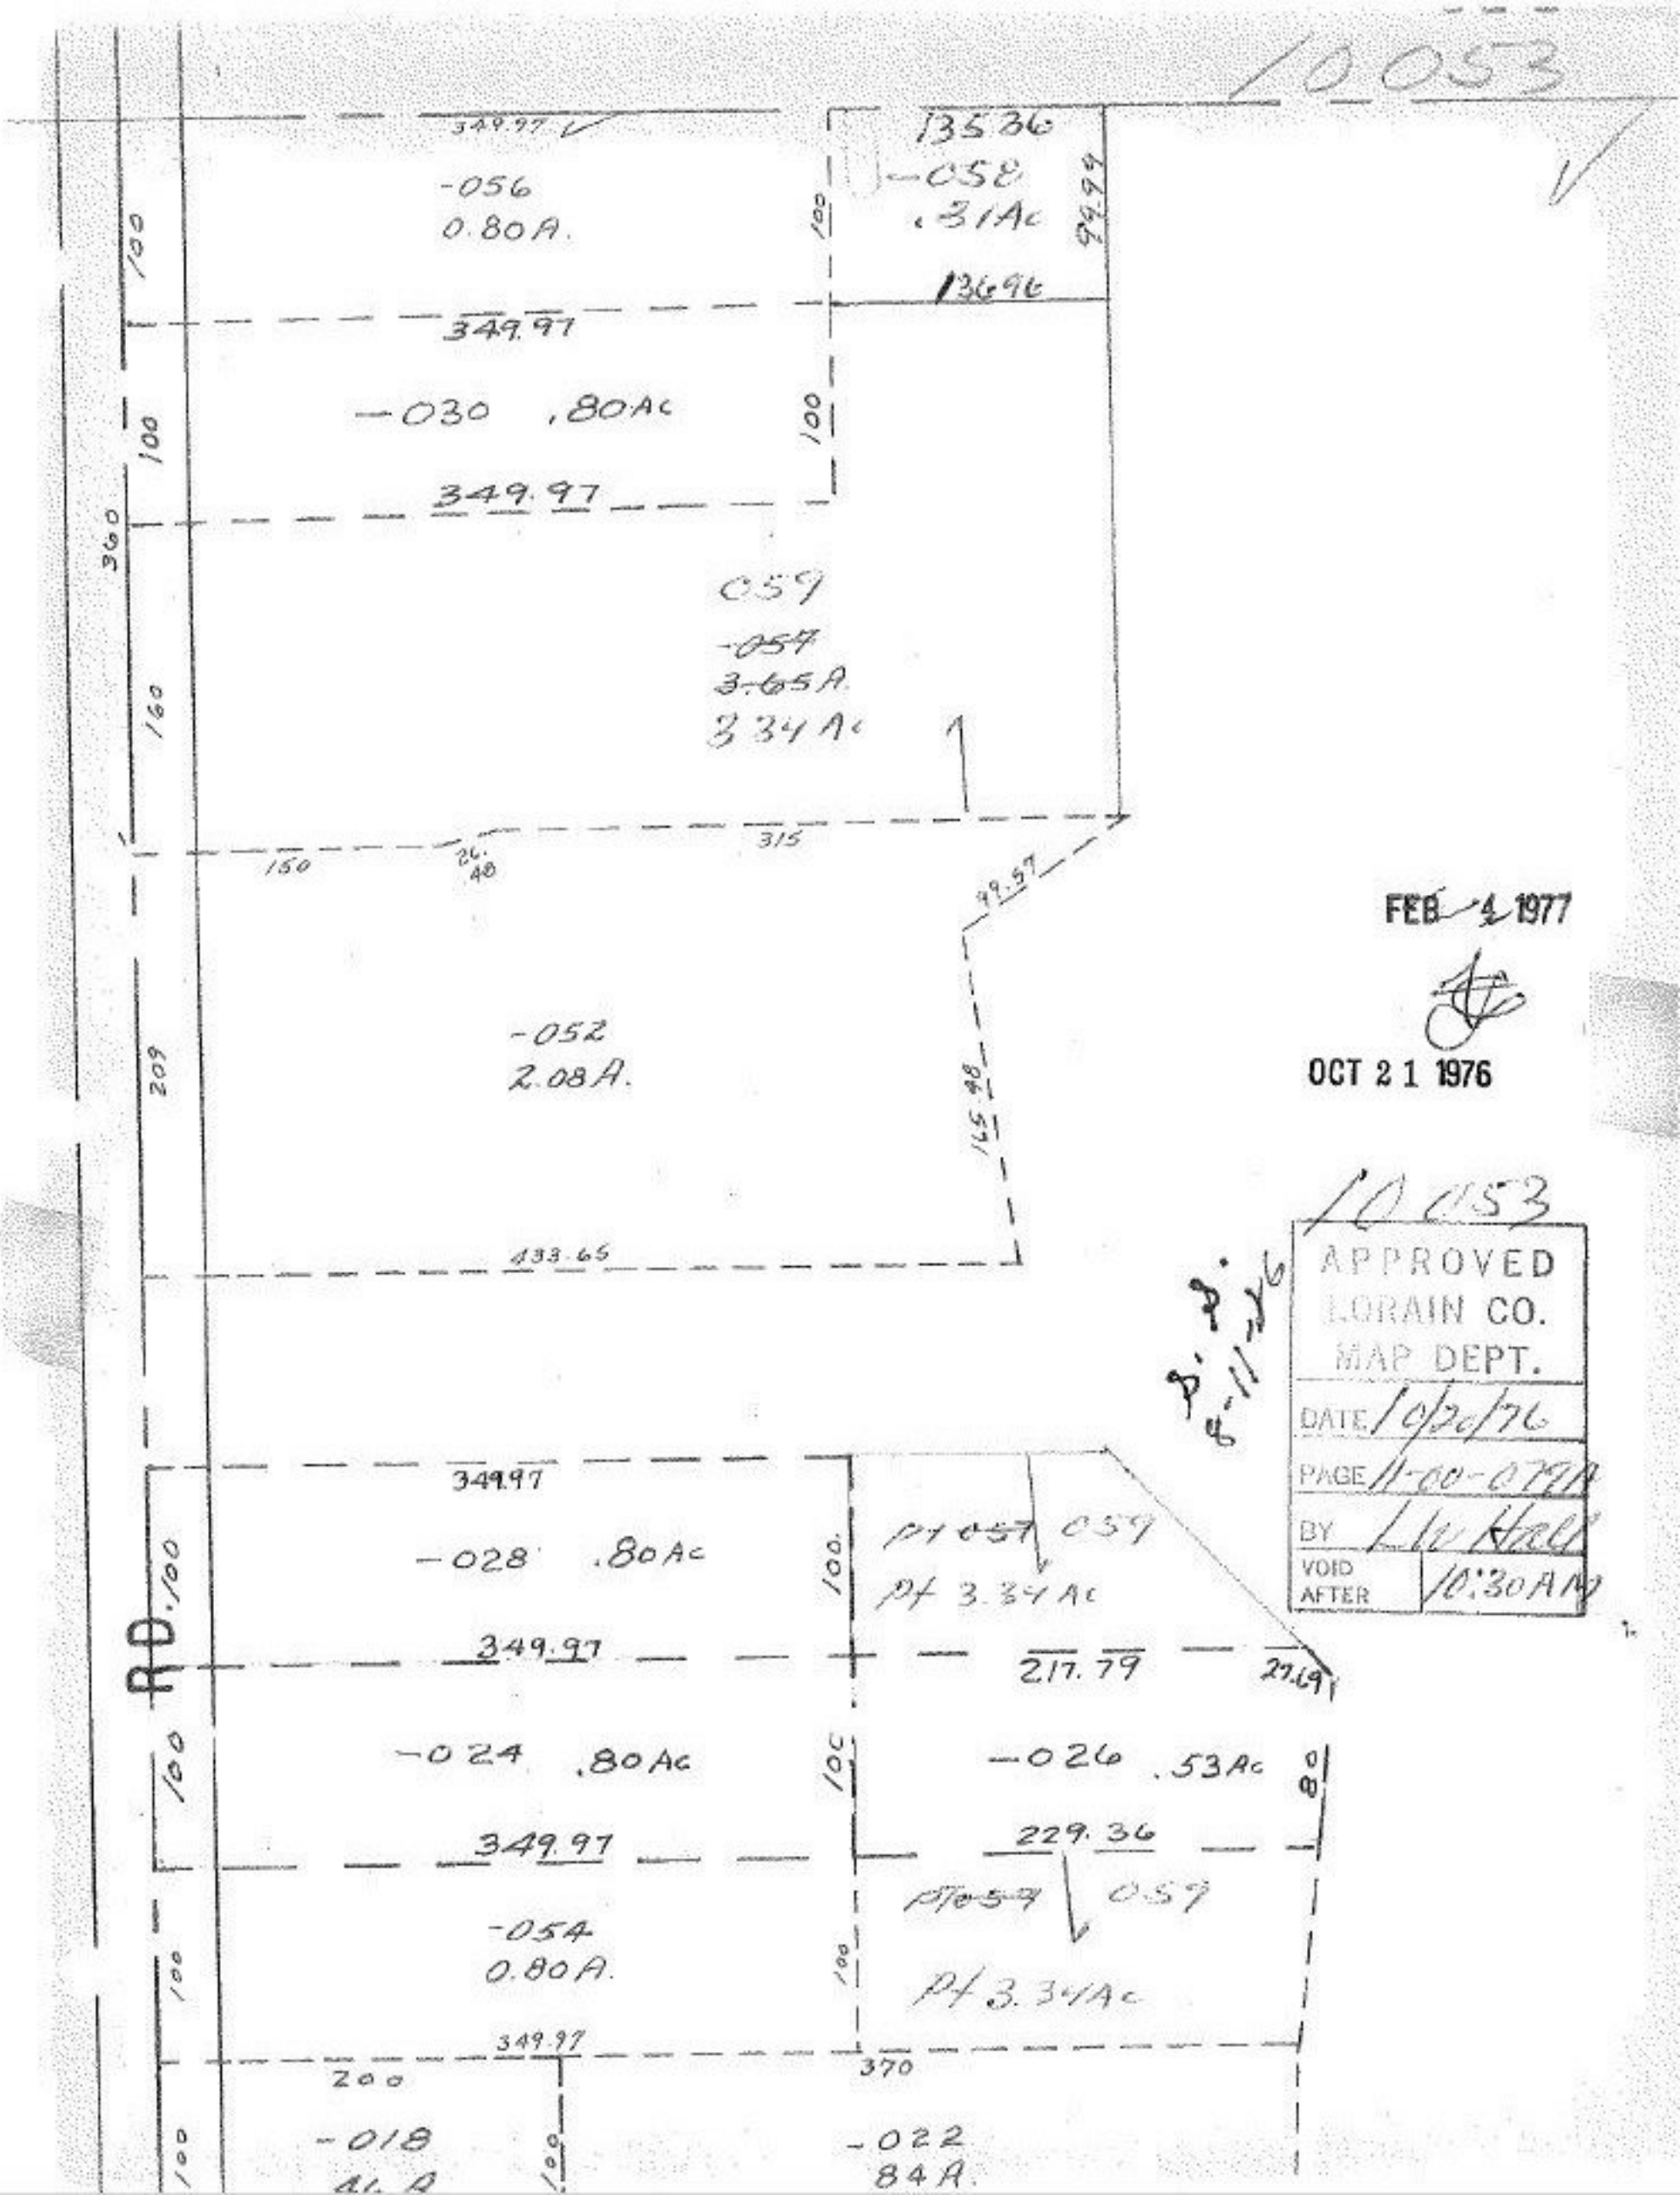
10053
349.97
-056
0.80A.
135.36
-058
.31Ac
99.99
136.96
349.97
-030 .80Ac
349.97
059
-057
3.65A.
3.34Ac
360
160
150
26.48
315
99.57
-052
2.08A.
165.98
209
433.65
349.97
-028 .80Ac
Pt 057 059
Pt 3.34Ac
349.97
217.79
27.69
RD.
-024 .80Ac
-026 .53Ac
349.97
229.36
Pt 059 059
-054
0.80A.
Pt 3.34Ac
349.97
200
370
-018
-022
84A.
FEB 4 1977
OCT 21 1976
10053
APPROVED
LORAIN CO.
MAP DEPT.
DATE 10/20/76
PAGE 11-00-079A
BY L.W. Hall
VOID AFTER 10:30AM
8-11-76