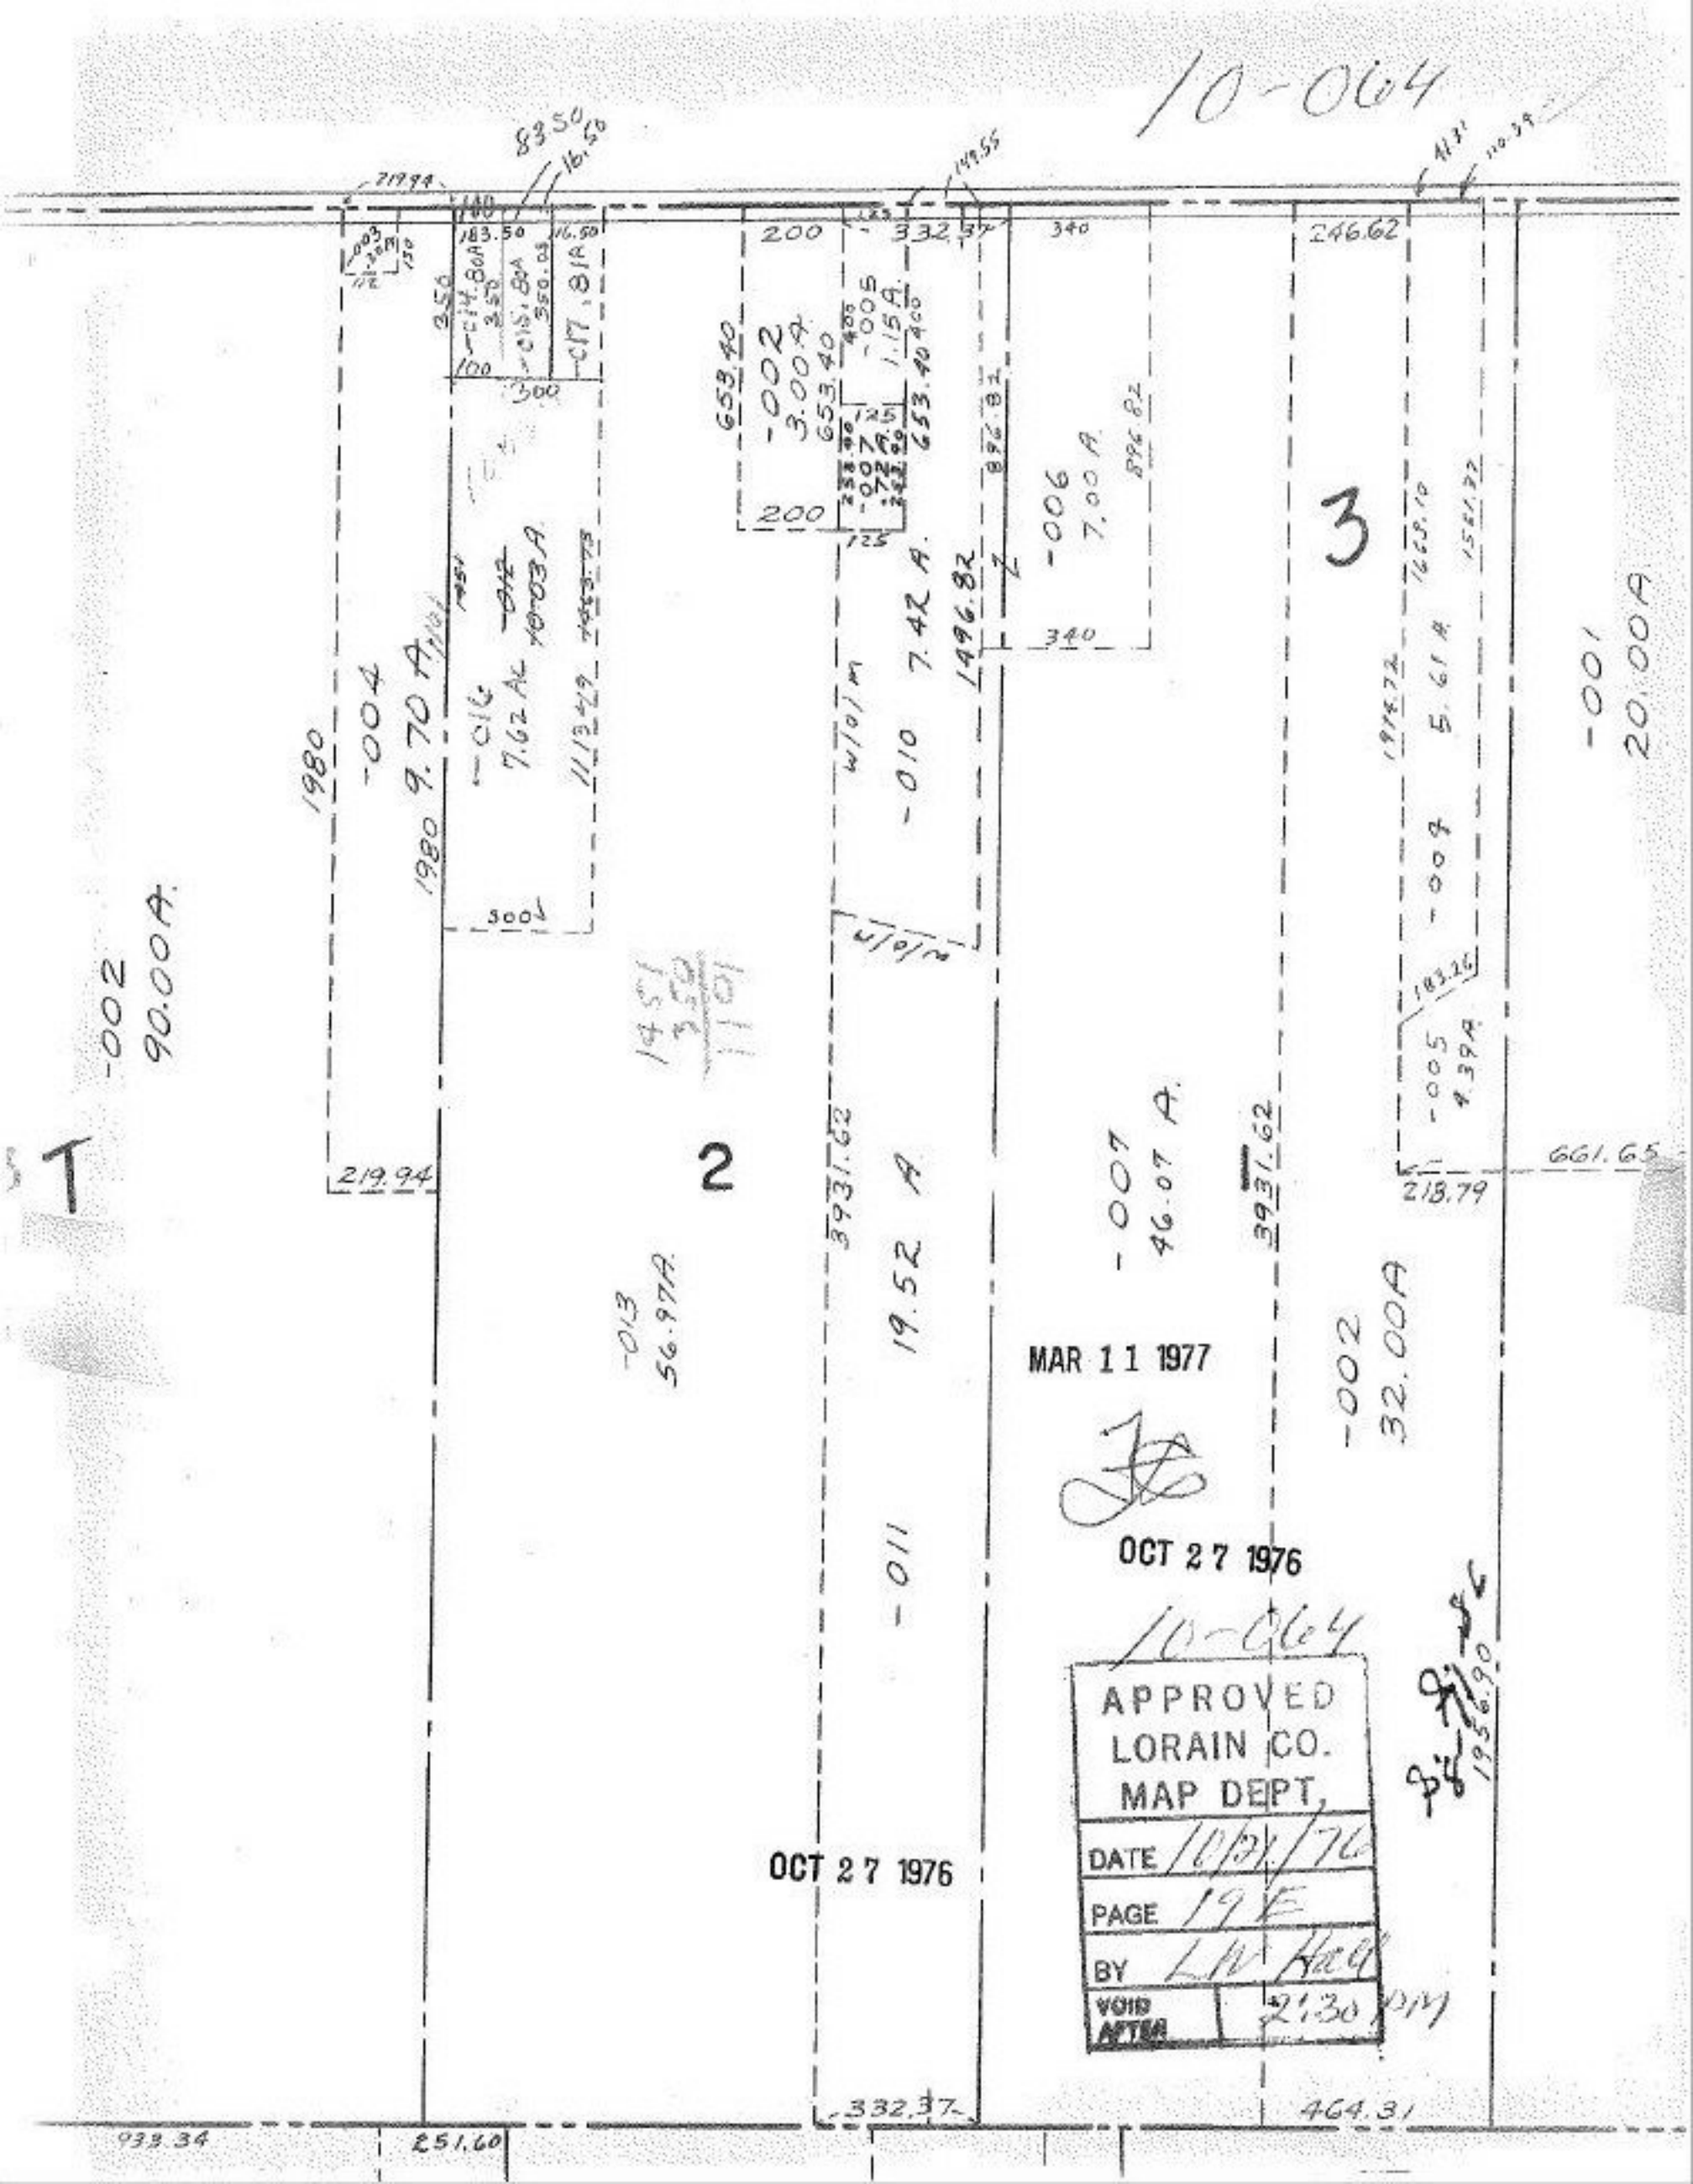
10-064
-002
90.00A.
-004
9.70 A
-016
7.62 Ac
-002
3.00 A
-005
1.15 A
-006
7.00 A
-010
7.42 A
-007
46.07 A
-002
32.00A
-001
20.00A
-013
56.97A
-011
19.52 A
-004
5.61 A
-005
4.39A
3
2
T
MAR 11 1977
OCT 27 1976
OCT 27 1976
APPROVED
LORAIN CO.
MAP DEPT.
DATE 10/21/76
PAGE 19E
BY LW Hall
VOID AFTER 2:30 PM