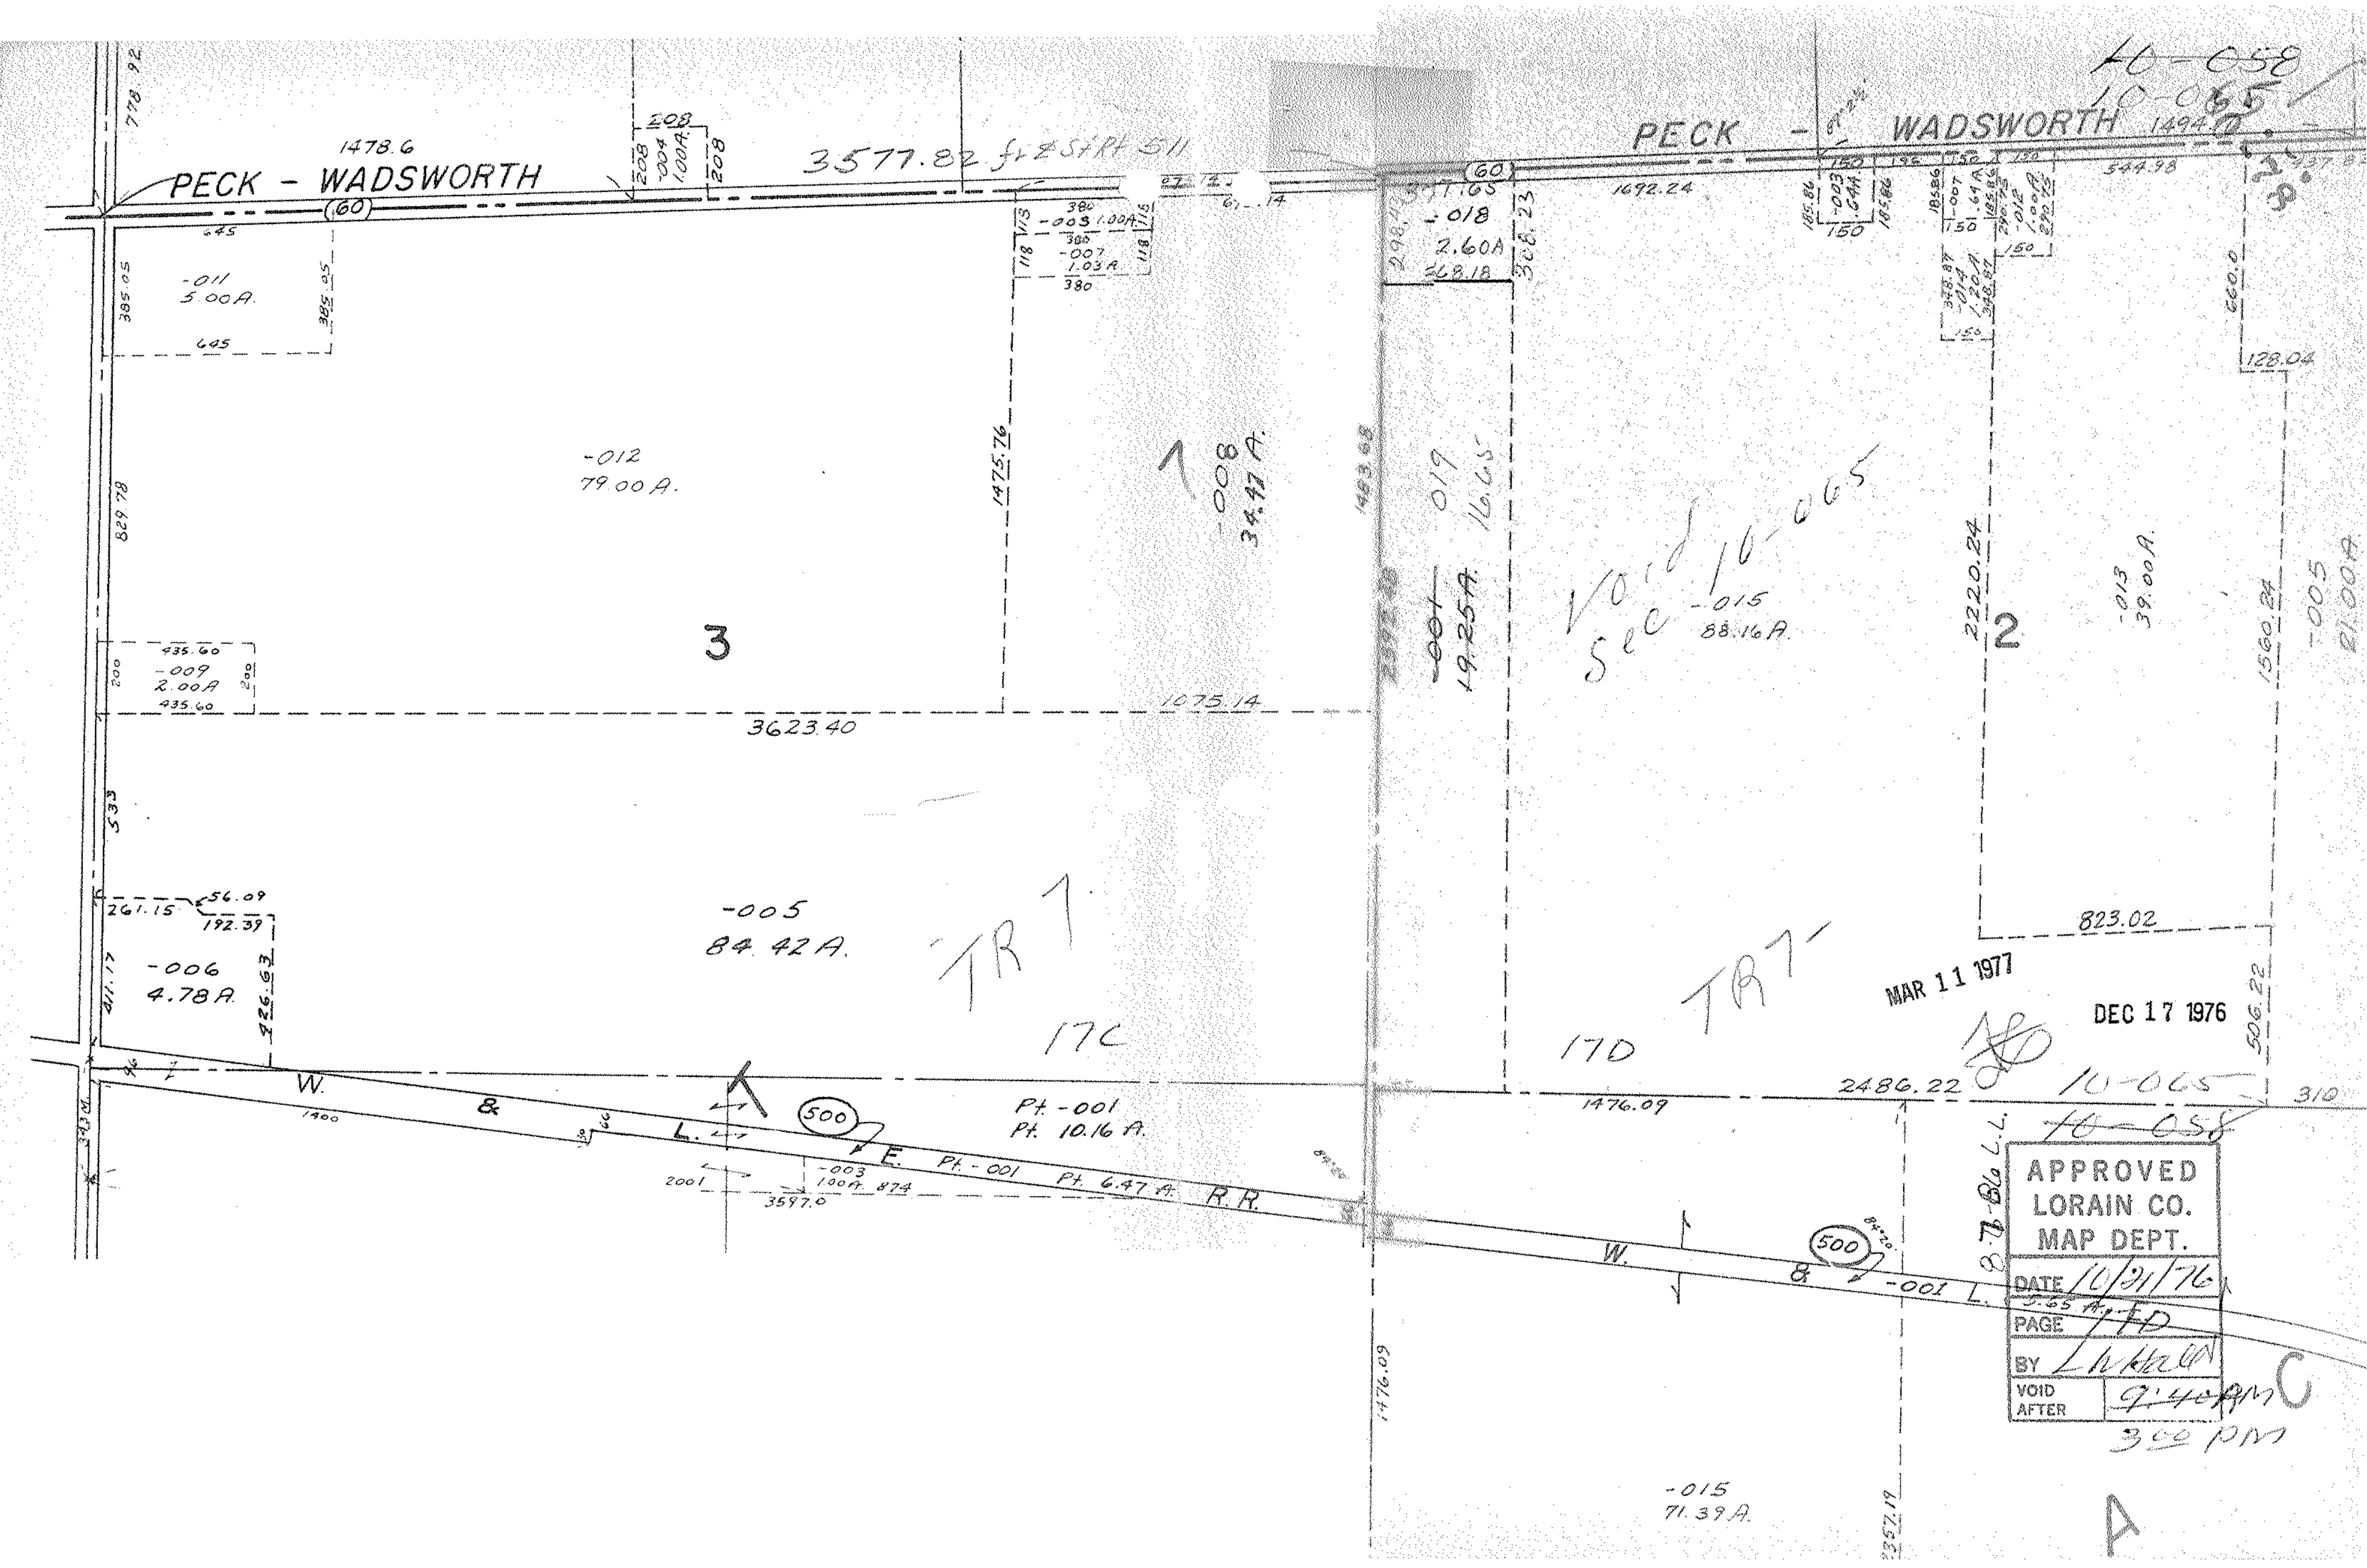

PECK - WADSWORTH
1478.6
3577.82 ft ℄ St Rt 511
PECK - WADSWORTH
1494.0
10-058
10-065
-011
5.00A.
-012
79.00A.
-008
34.47A.
-018
2.60A
-019
16.65
-001
19.25A.
Void 10-065
Sec
-015
88.16A.
-013
39.00A.
-009
2.00A
3
2
3623.40
1075.14
1475.76
1692.24
544.98
128.04
2220.24
1560.24
-005
21.00A.
-005
84.42A.
-006
4.78A.
TR 7
17C
17D
TR 7
823.02
506.22
MAR 11 1977
DEC 17 1976
W. & L. E. R.R.
Pt. -001
Pt. 10.16 A.
Pt. -001
Pt. 6.47 A.
500
2486.22
1476.09
10-065
10-058
-001 L.
-015
71.39A.
APPROVED
LORAIN CO.
MAP DEPT.
DATE 10/21/76
PAGE 1 FD
BY L.W. Hall
VOID AFTER 9:40 AM
3:00 PM
A
C