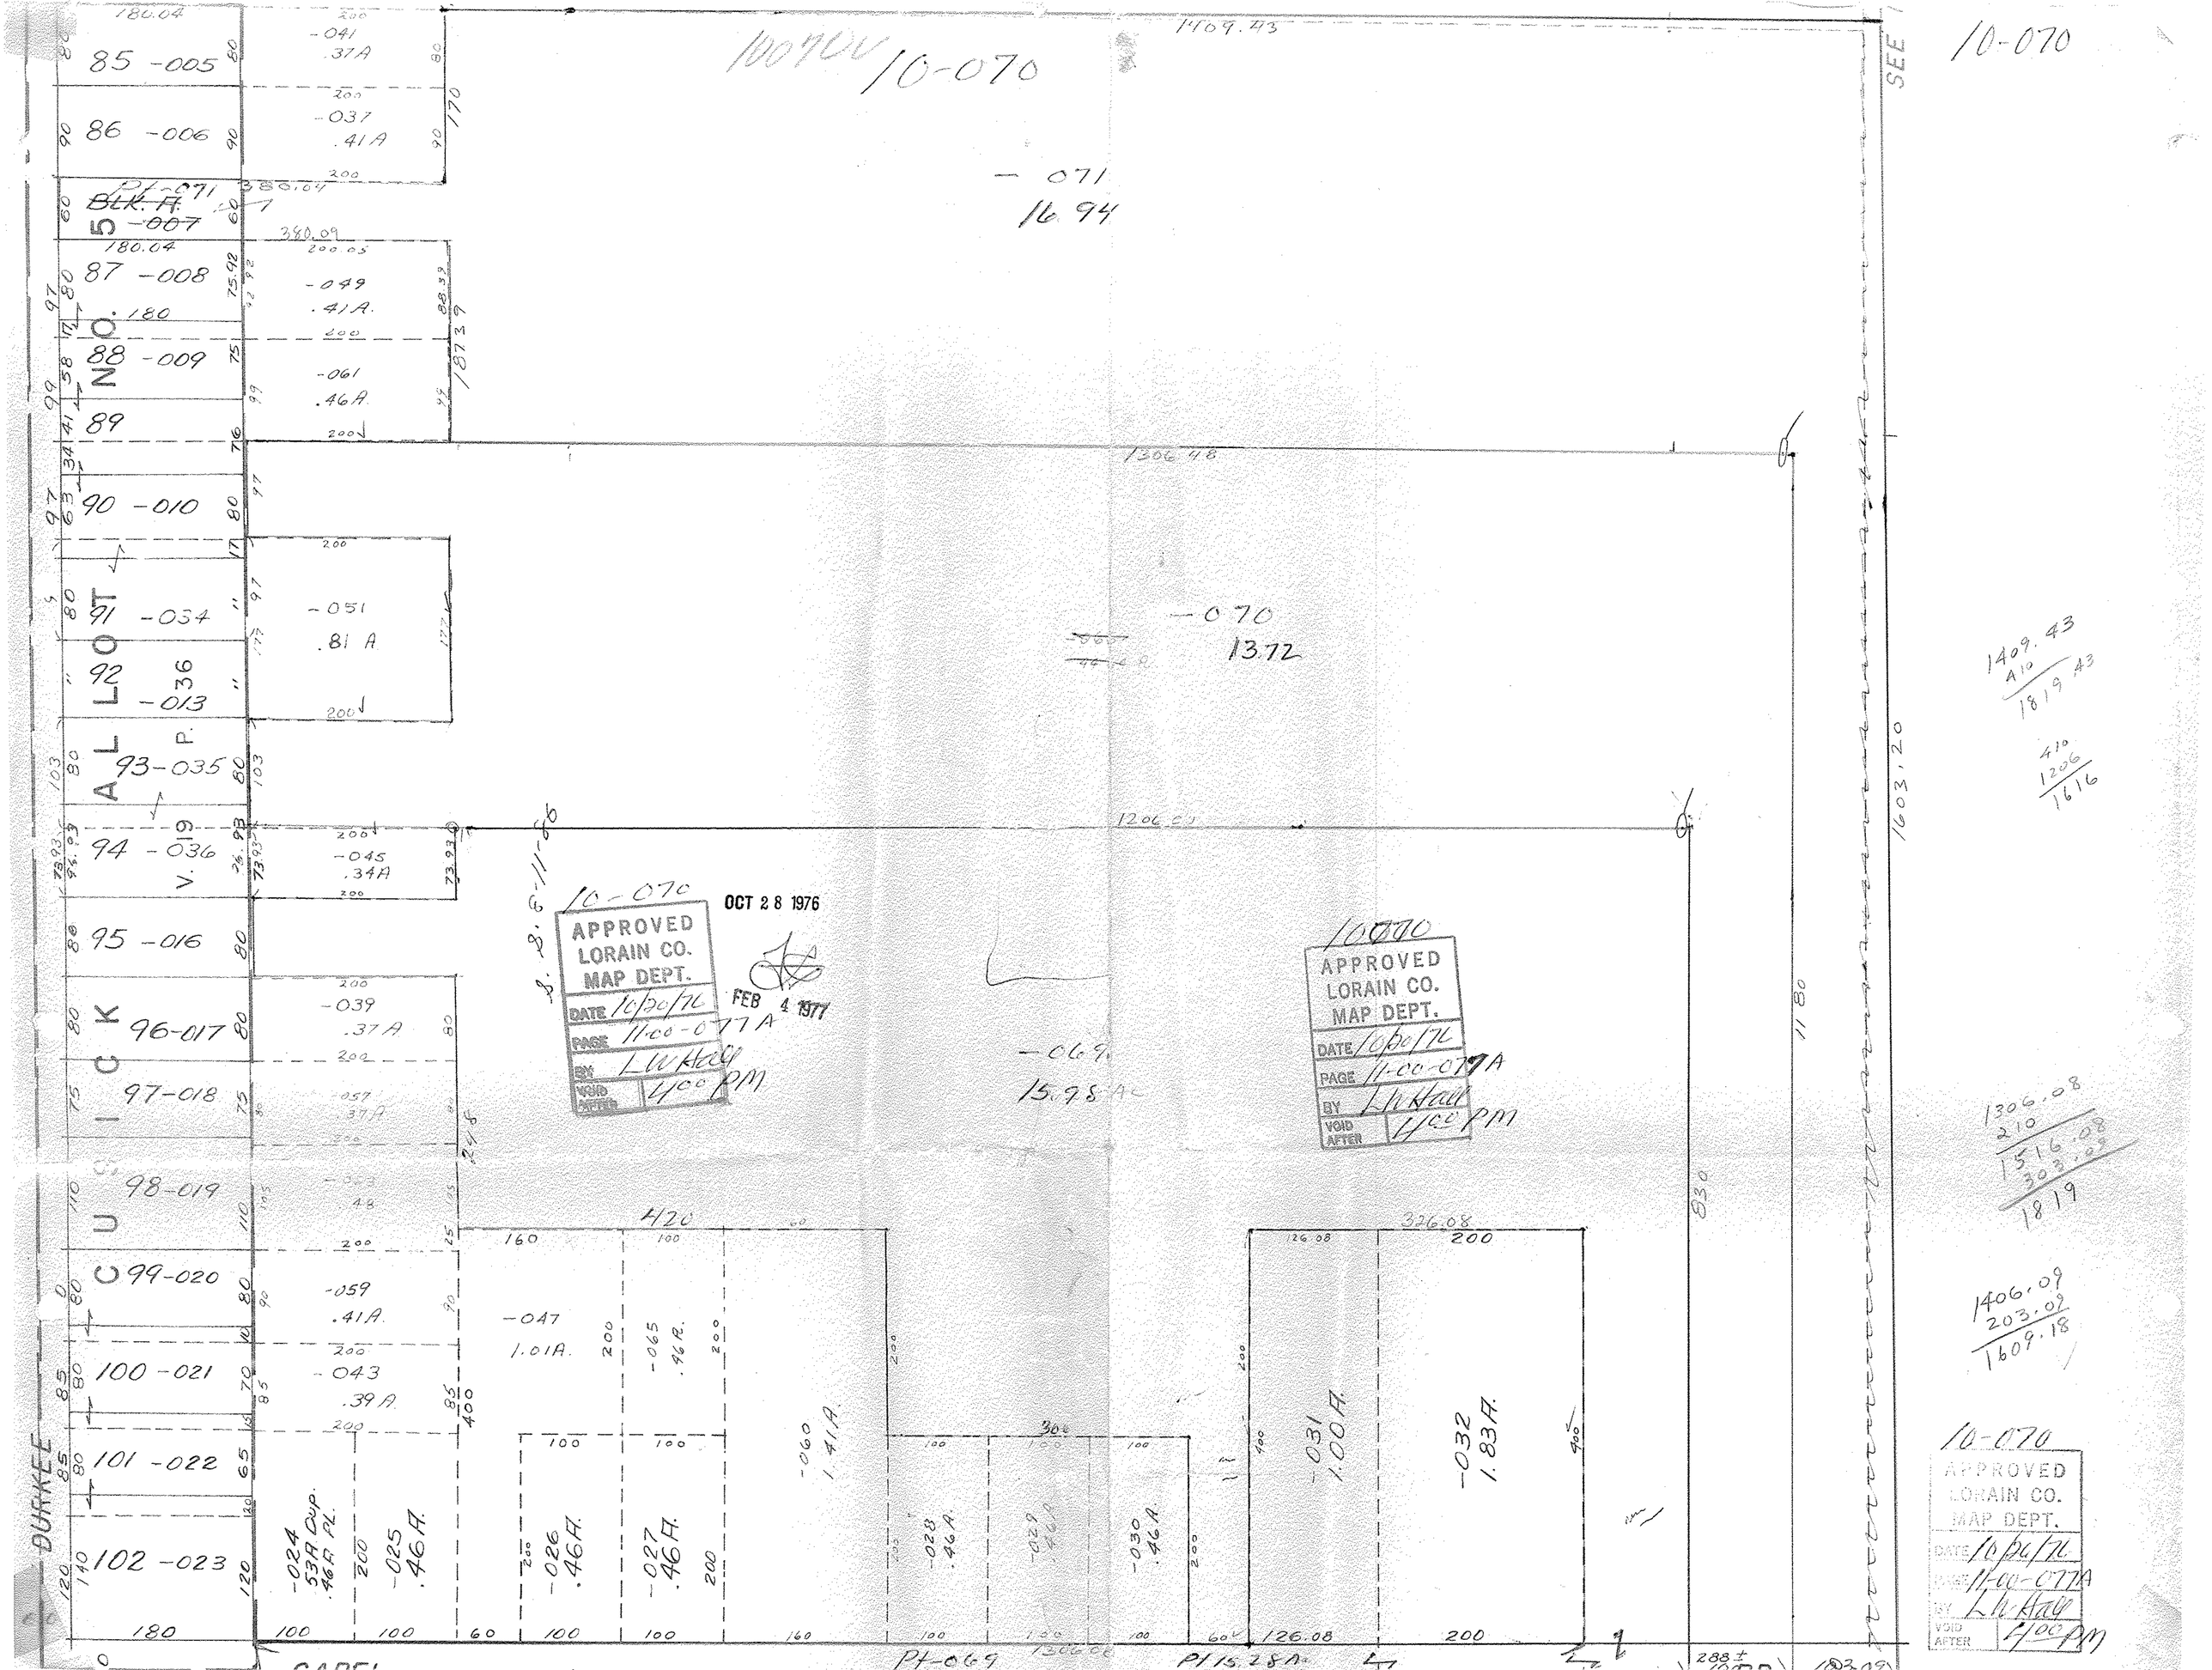

10-070
1409.43
SEE
10-070
85 -005
86 -006
Pt-071
BLK. A.
-007
87 -008
88 -009
89
90 -010
91 -034
92 -013
93-035
94 -036
95 -016
96-017
97-018
98-019
99-020
100 -021
101 -022
102 -023
CUSICK ALLOT NO. 5
P. 36
V. 19
-041
.37A
-037
.41A
-049
.41A.
-061
.46A.
-051
.81 A
-045
.34A
-039
.37A
-059
.41A.
-043
.39A.
-071
16.94
-070
13.72
-069
15.98 Ac
-047
1.01A.
-065
.46A.
-060
1.41A.
-024
53A Cup.
.46A PL.
-025
.46A.
-026
.46A.
-027
.46A.
-028
.46A.
-029
.46A.
-030
.46A.
-031
1.00A.
-032
1.83A.
1306.48
1206.00
1603.20
1180
830
420
326.08
126.08
Pt-069
Pt 15.28 Ac
DURKEE
10-070
APPROVED
LORAIN CO.
MAP DEPT.
DATE 10/20/76
PAGE 11-00-077A
BY LW Hall
VOID AFTER 4:00 PM
OCT 28 1976
FEB 4 1977
10-070
APPROVED
LORAIN CO.
MAP DEPT.
DATE 10/20/76
PAGE 11-00-077A
BY LW Hall
VOID AFTER 4:00 PM
1409.43
410
1819.43
410
1206
1616
1306.08
210
1516.08
303.09
1819
1406.09
203.09
1609.18
10-070
APPROVED
LORAIN CO.
MAP DEPT.
DATE 10/26/76
PAGE 11-00-077A
BY LW Hall
VOID AFTER 4:00 PM