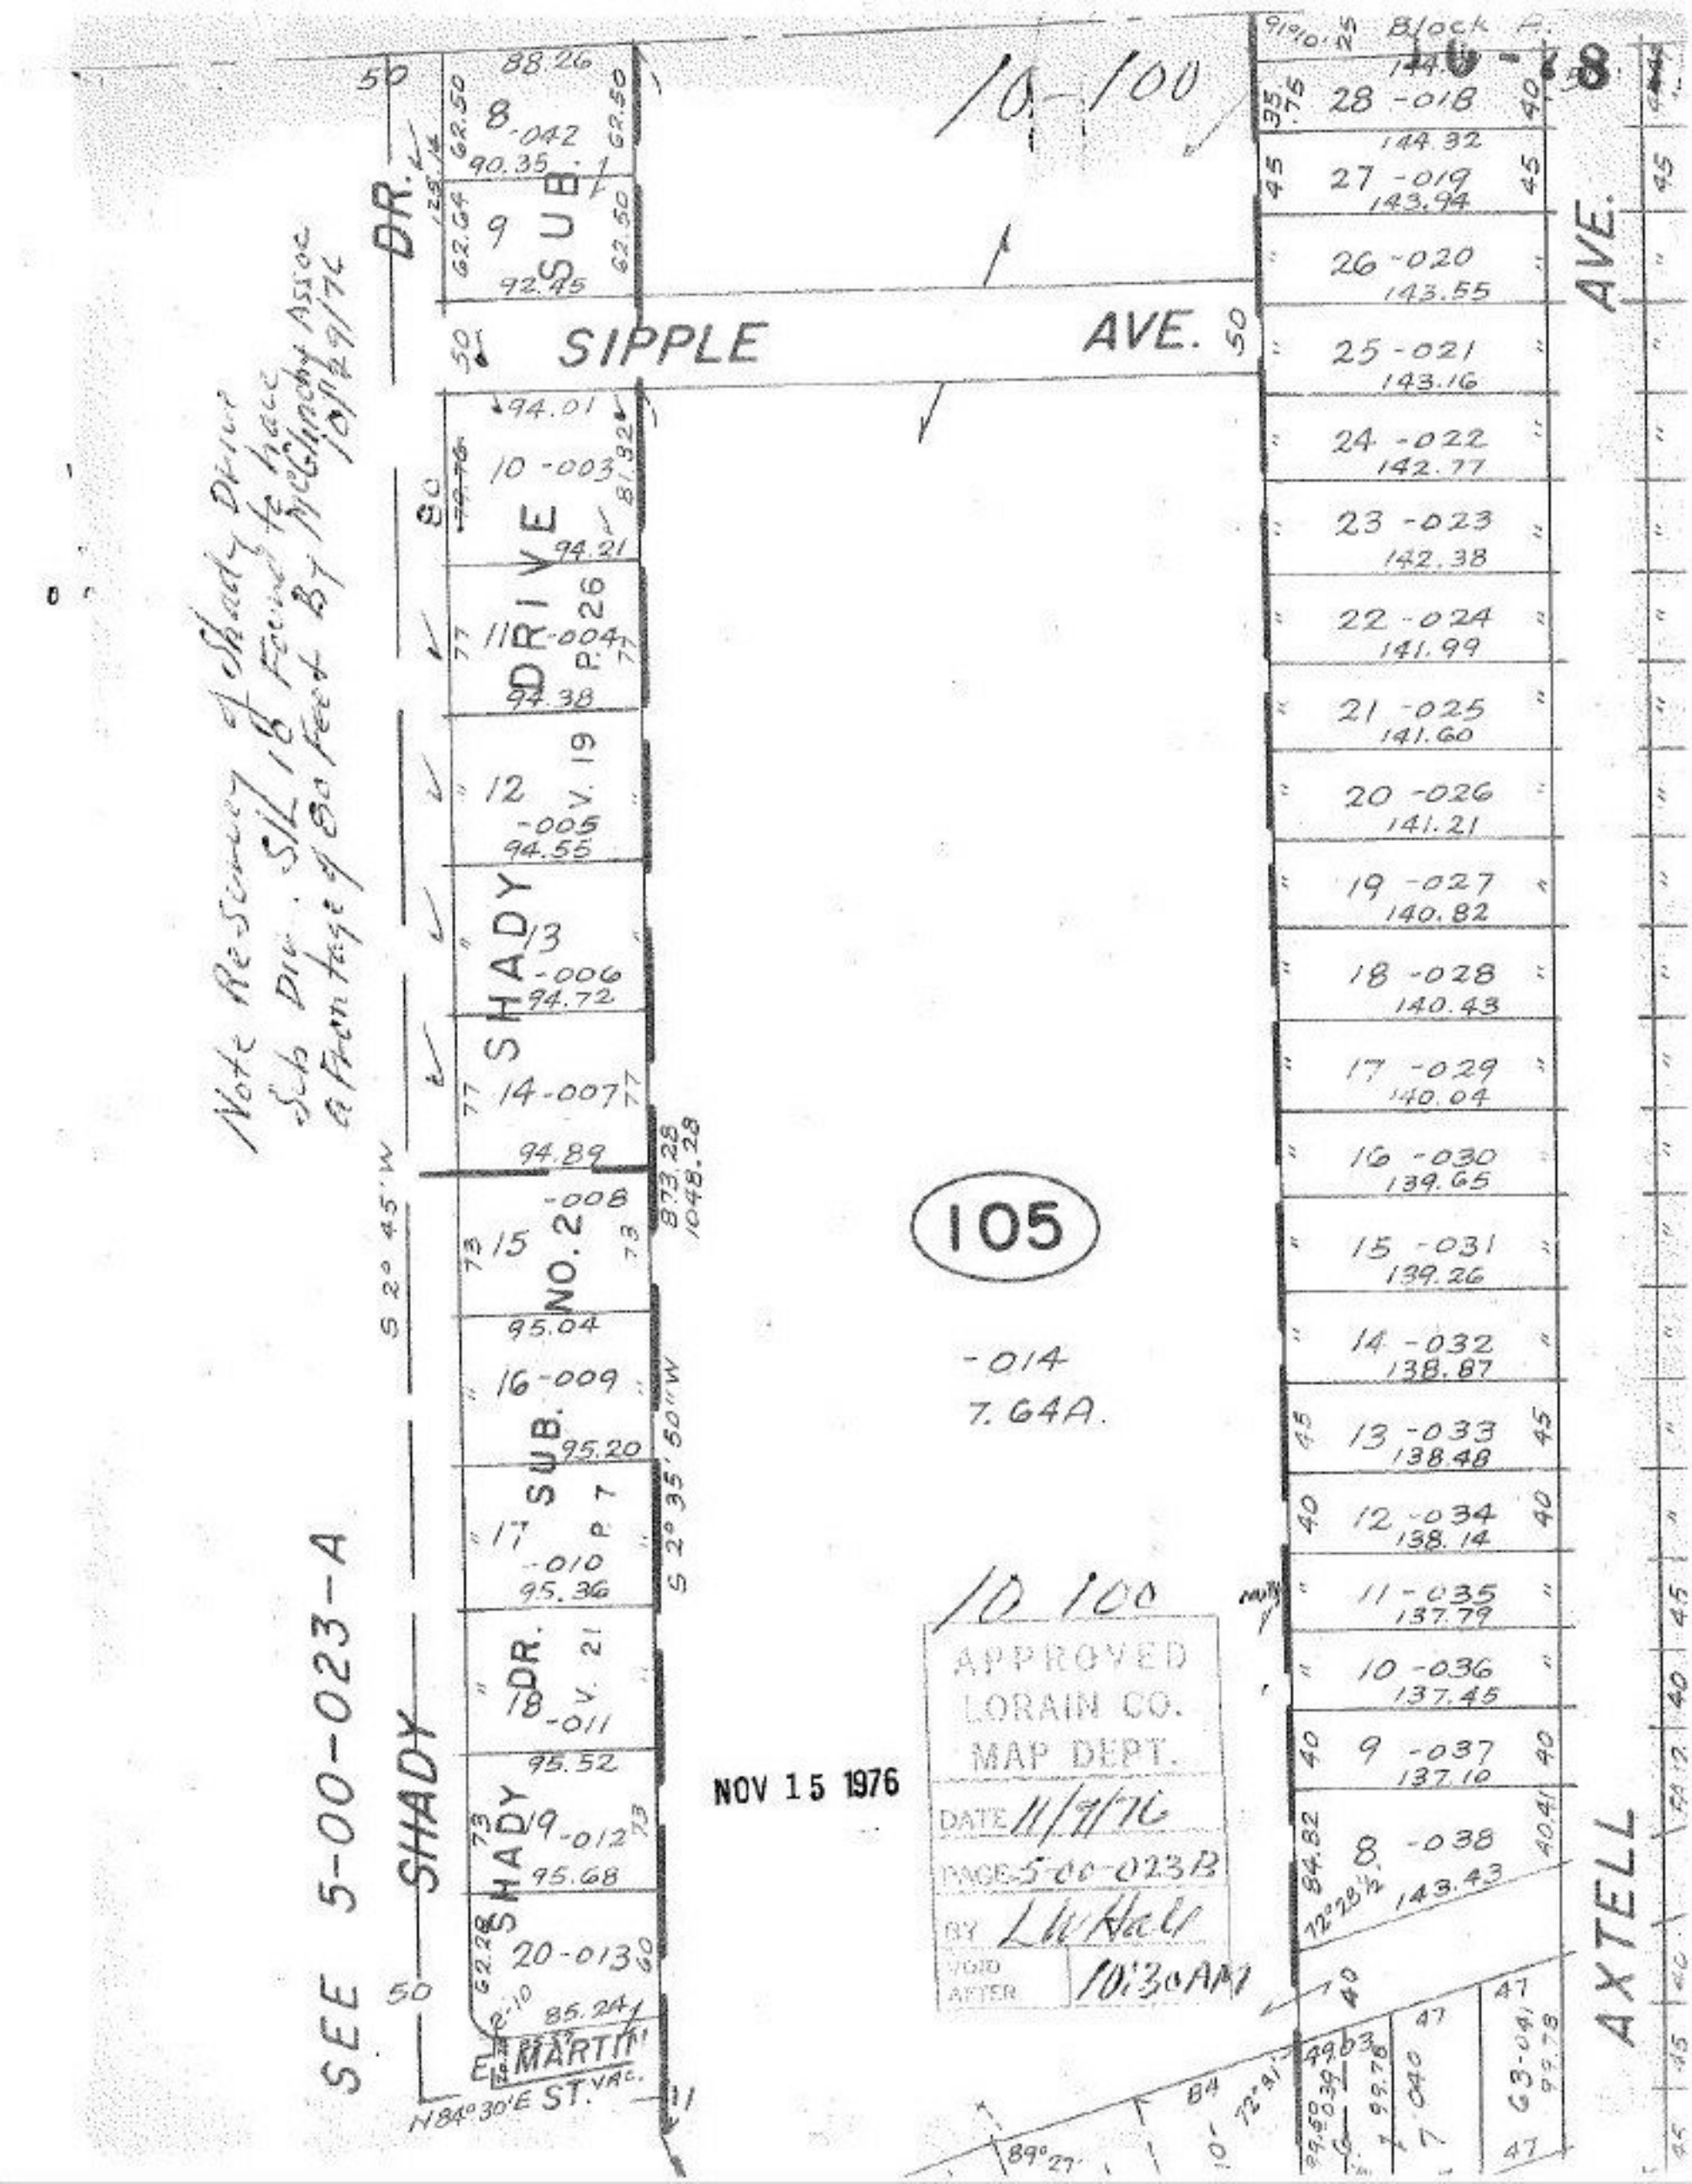

10-100
Block A
SIPPLE AVE.
SHADY DR.
SHADY DRIVE
SUB. NO. 2
SUB. P. 7
SUB. P. 26
SUB. V. 19
SUB. V. 21
E. MARTIN ST. VAC.
N84°30'E
S 2° 45' W
S 2° 35' 50" W
8-042
9
10-003
11-004
12-005
13-006
14-007
15-008
16-009
17-010
18-011
19-012
20-013
28-018
27-019
26-020
25-021
24-022
23-023
22-024
21-025
20-026
19-027
18-028
17-029
16-030
15-031
14-032
13-033
12-034
11-035
10-036
9-037
8-038
AXTELL AVE.
105
-014
7.64A.
10 100
APPROVED
LORAIN CO.
MAP DEPT.
DATE 11/9/76
PAGE 5-00-023B
BY LWHall
VOID AFTER 10:30AM
NOV 15 1976
SEE 5-00-023-A
Note Resurvey of Shady Drive Sub Div. S/L 18 Found to have a Frontage of 80 Feet By McGlinchy Assoc 10/29/76