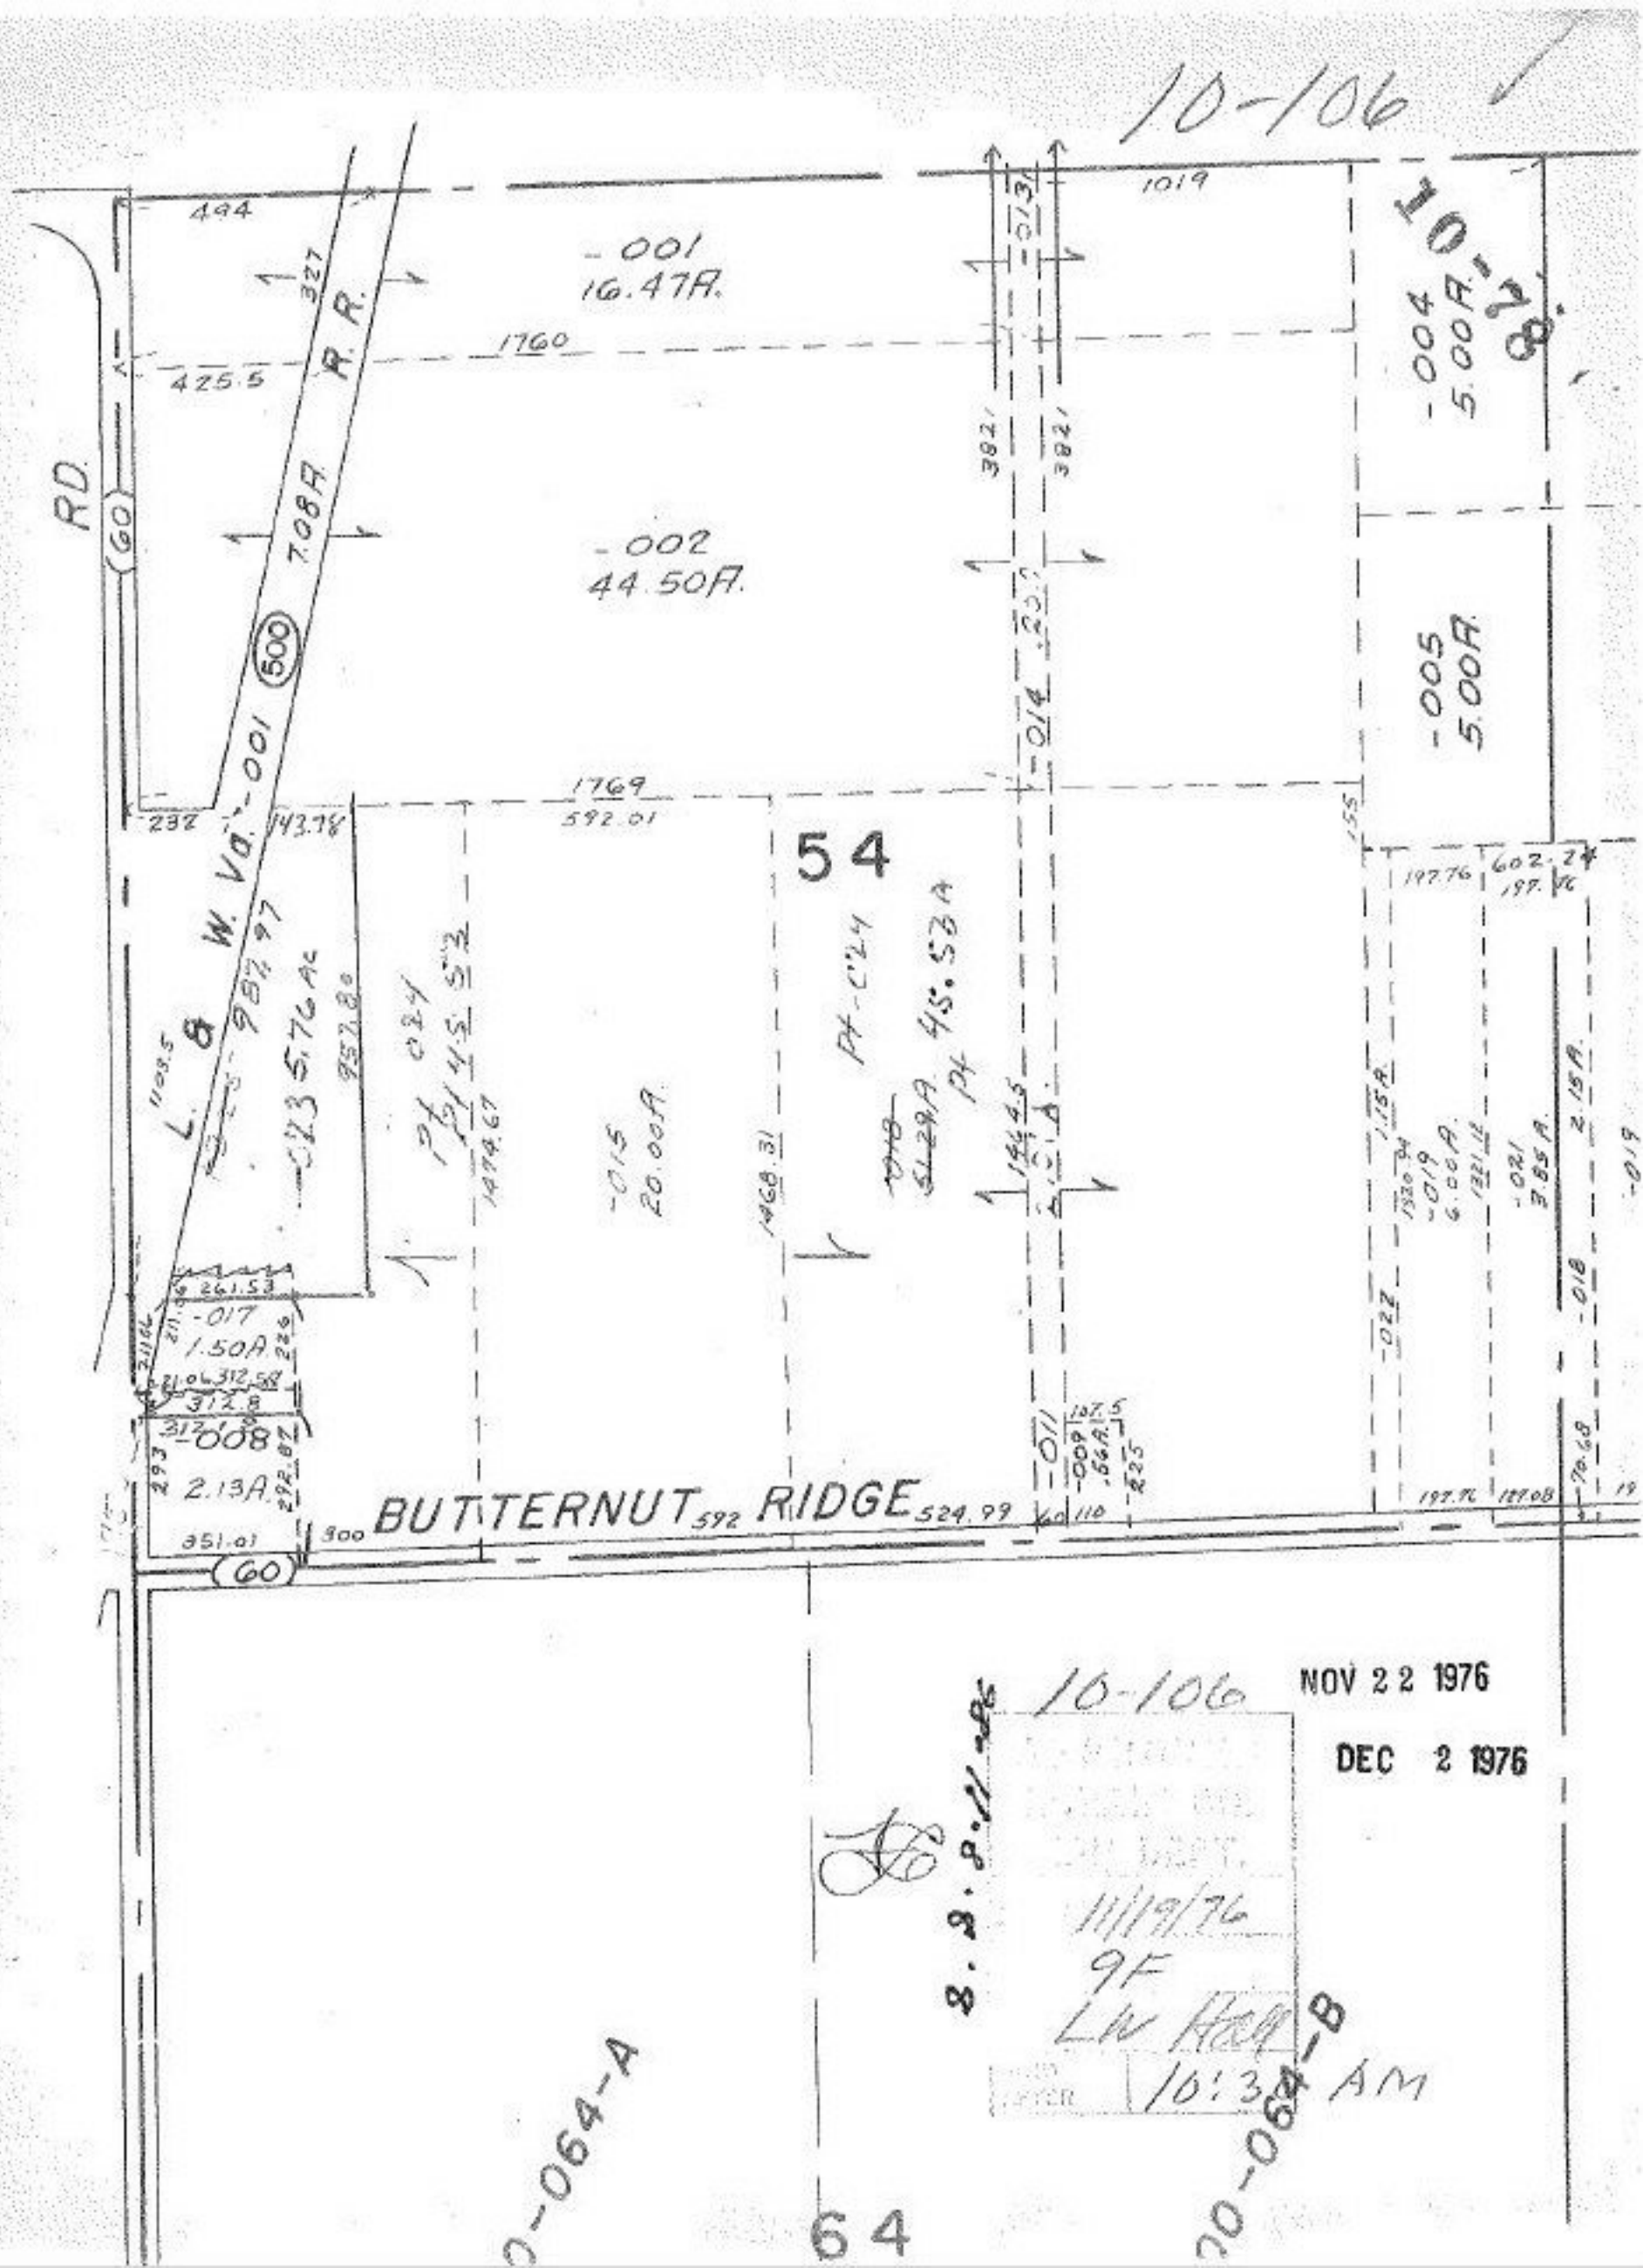
10-106
RD.
(60)
-001
16.47A.
-002
44.50A.
-004
5.00A.
-005
5.00A.
R.R.
7.08A.
(500)
-001
L. & W. Va.
-023 5.76 Ac
-015
20.00A.
54
-017
1.50A.
-008
2.13A.
BUTTERNUT RIDGE
(60)
10-106
NOV 22 1976
DEC 2 1976
11/19/76
9F
10:34 AM
64