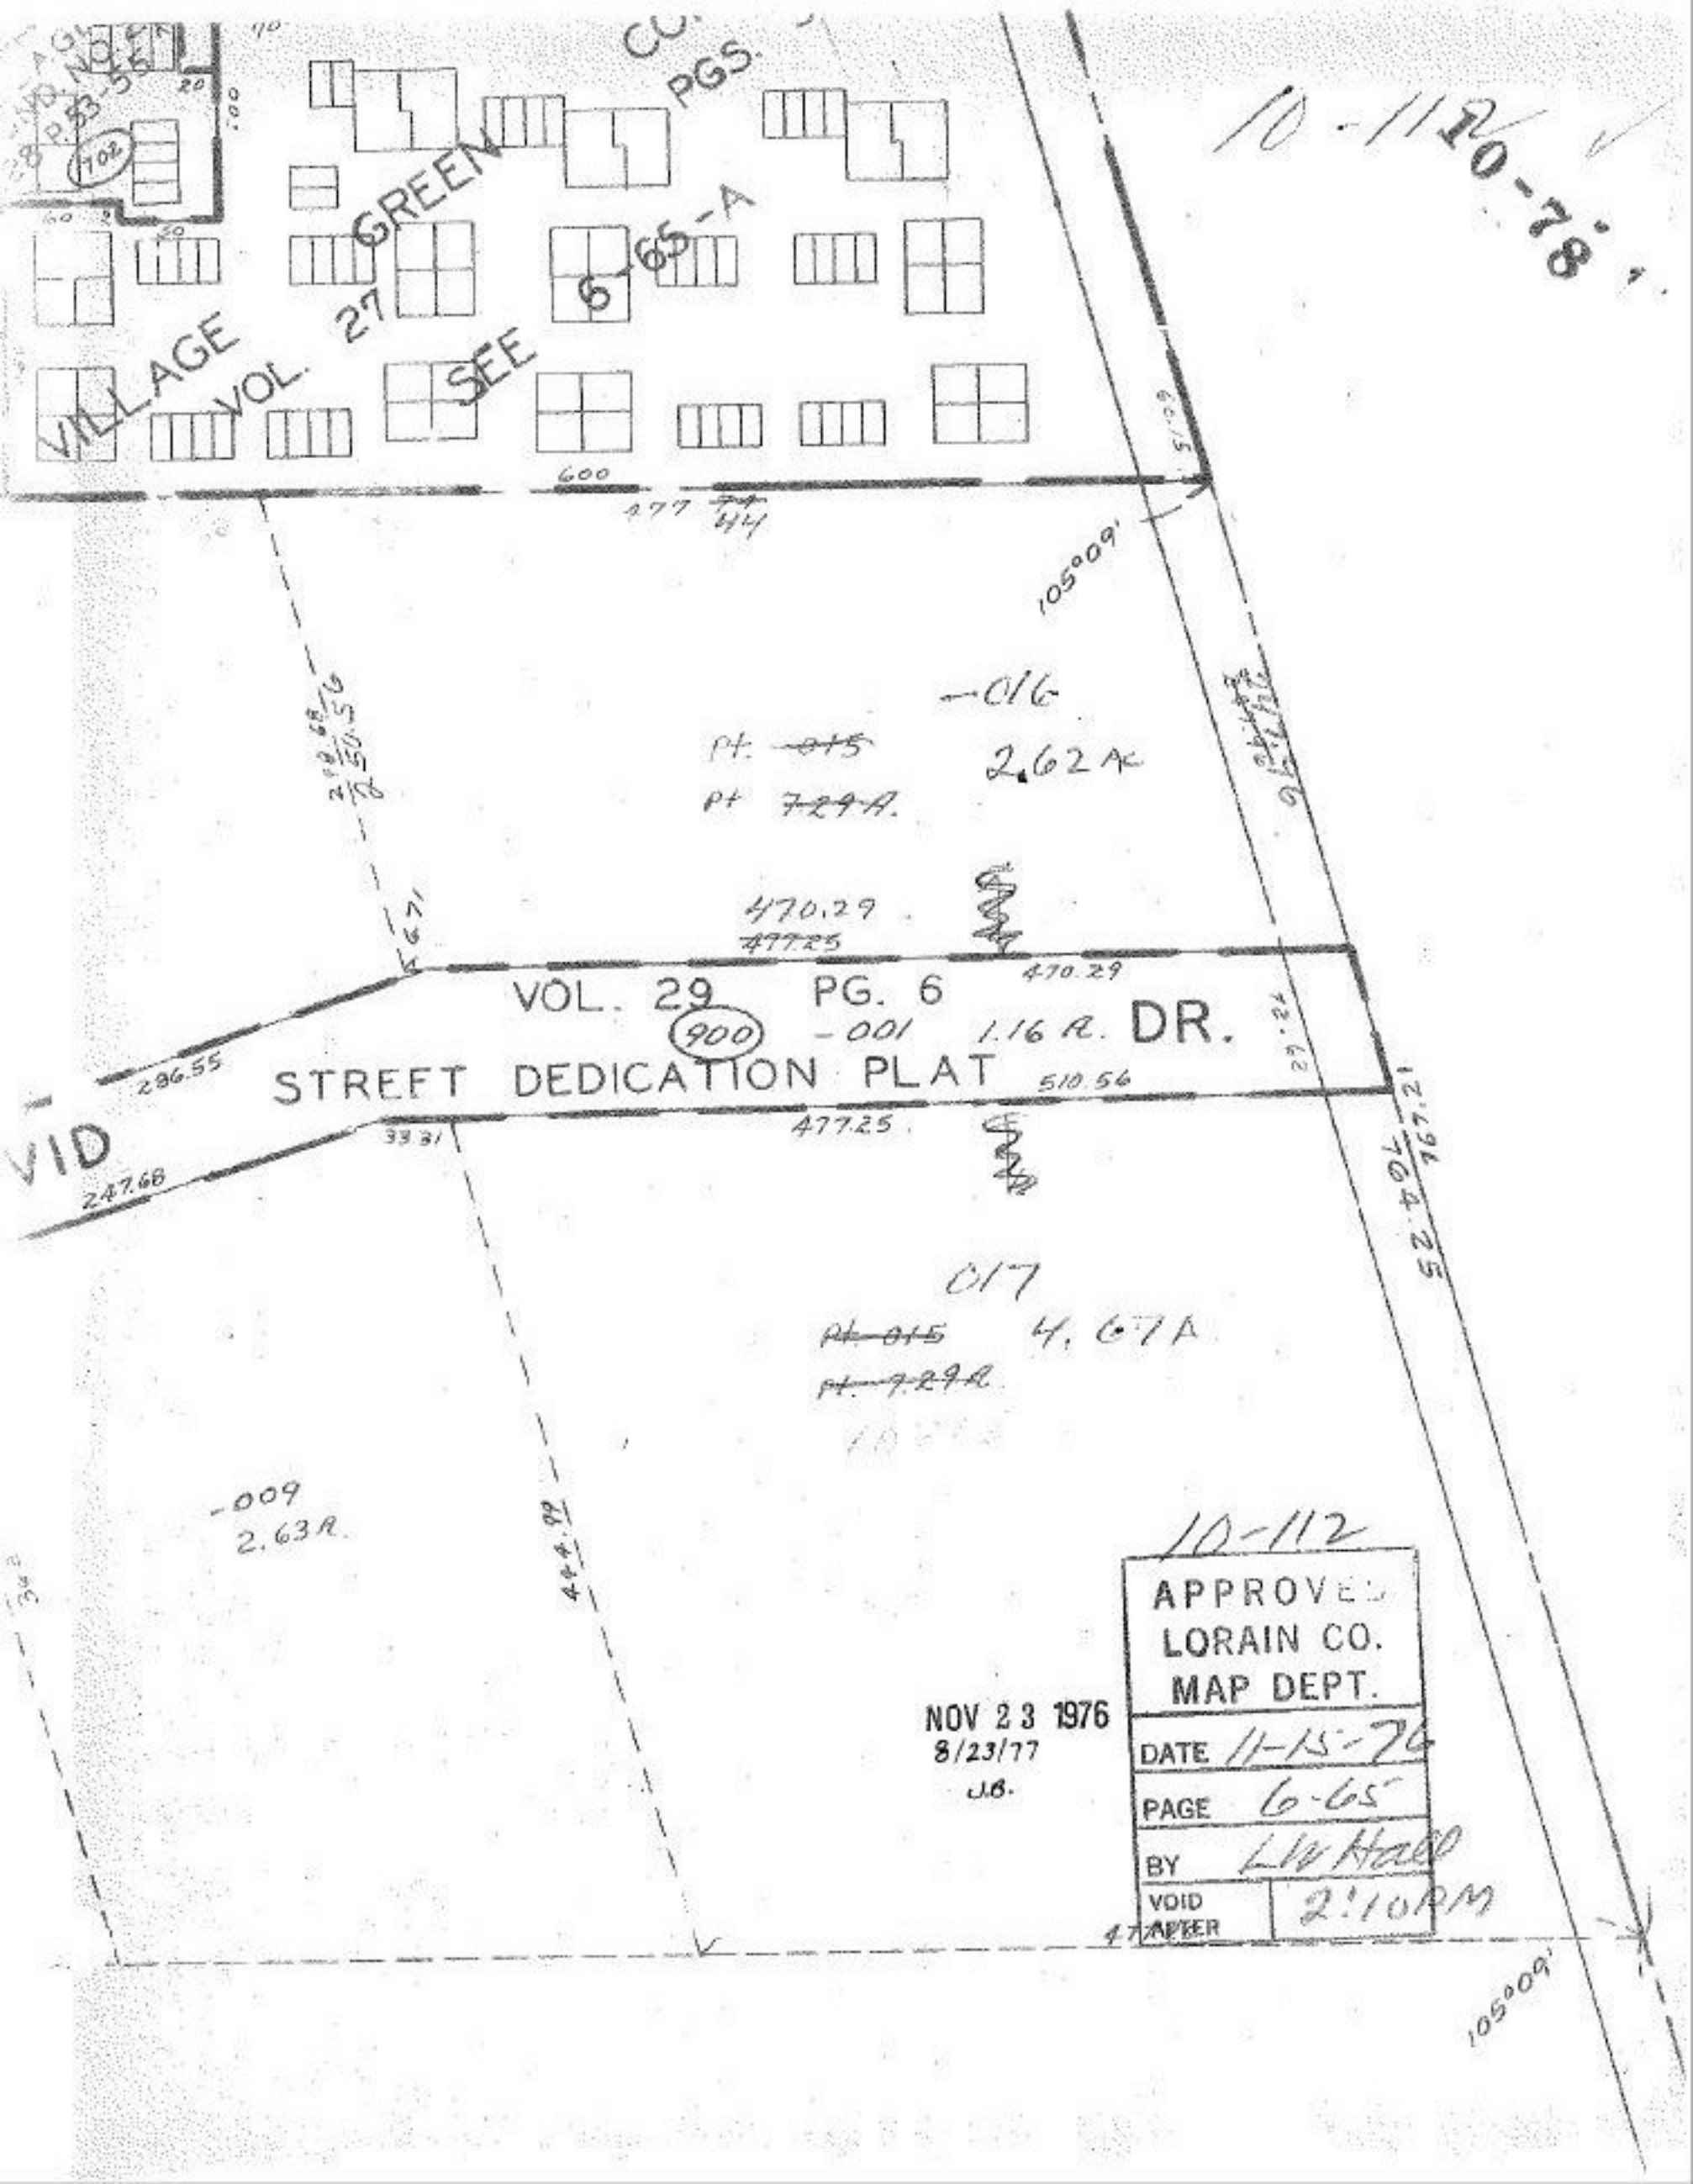

10-112
10-78
VILLAGE GREEN
VOL. 27
SEE 6-65-A
PGS.
600
477 ~~74~~ 44
105°09'
-016
Pt. ~~015~~
Pt ~~7.29 A.~~
2.62 AC
470.29
~~477.25~~
470.29
VOL. 29 PG. 6
900 -001 1.16 A. DR.
STREET DEDICATION PLAT
286.55
510.56
477.25
33.31
247.68
VID
017
~~Pt. 015~~ 4.67A
~~Pt. 7.29A~~
-009
2.63A
444.99
764.25
105°09'
APPROVED
LORAIN CO.
MAP DEPT.
DATE 11-15-76
PAGE 6-65
BY LW Hall
VOID AFTER 2:10PM
NOV 23 1976
8/23/77
J.B.