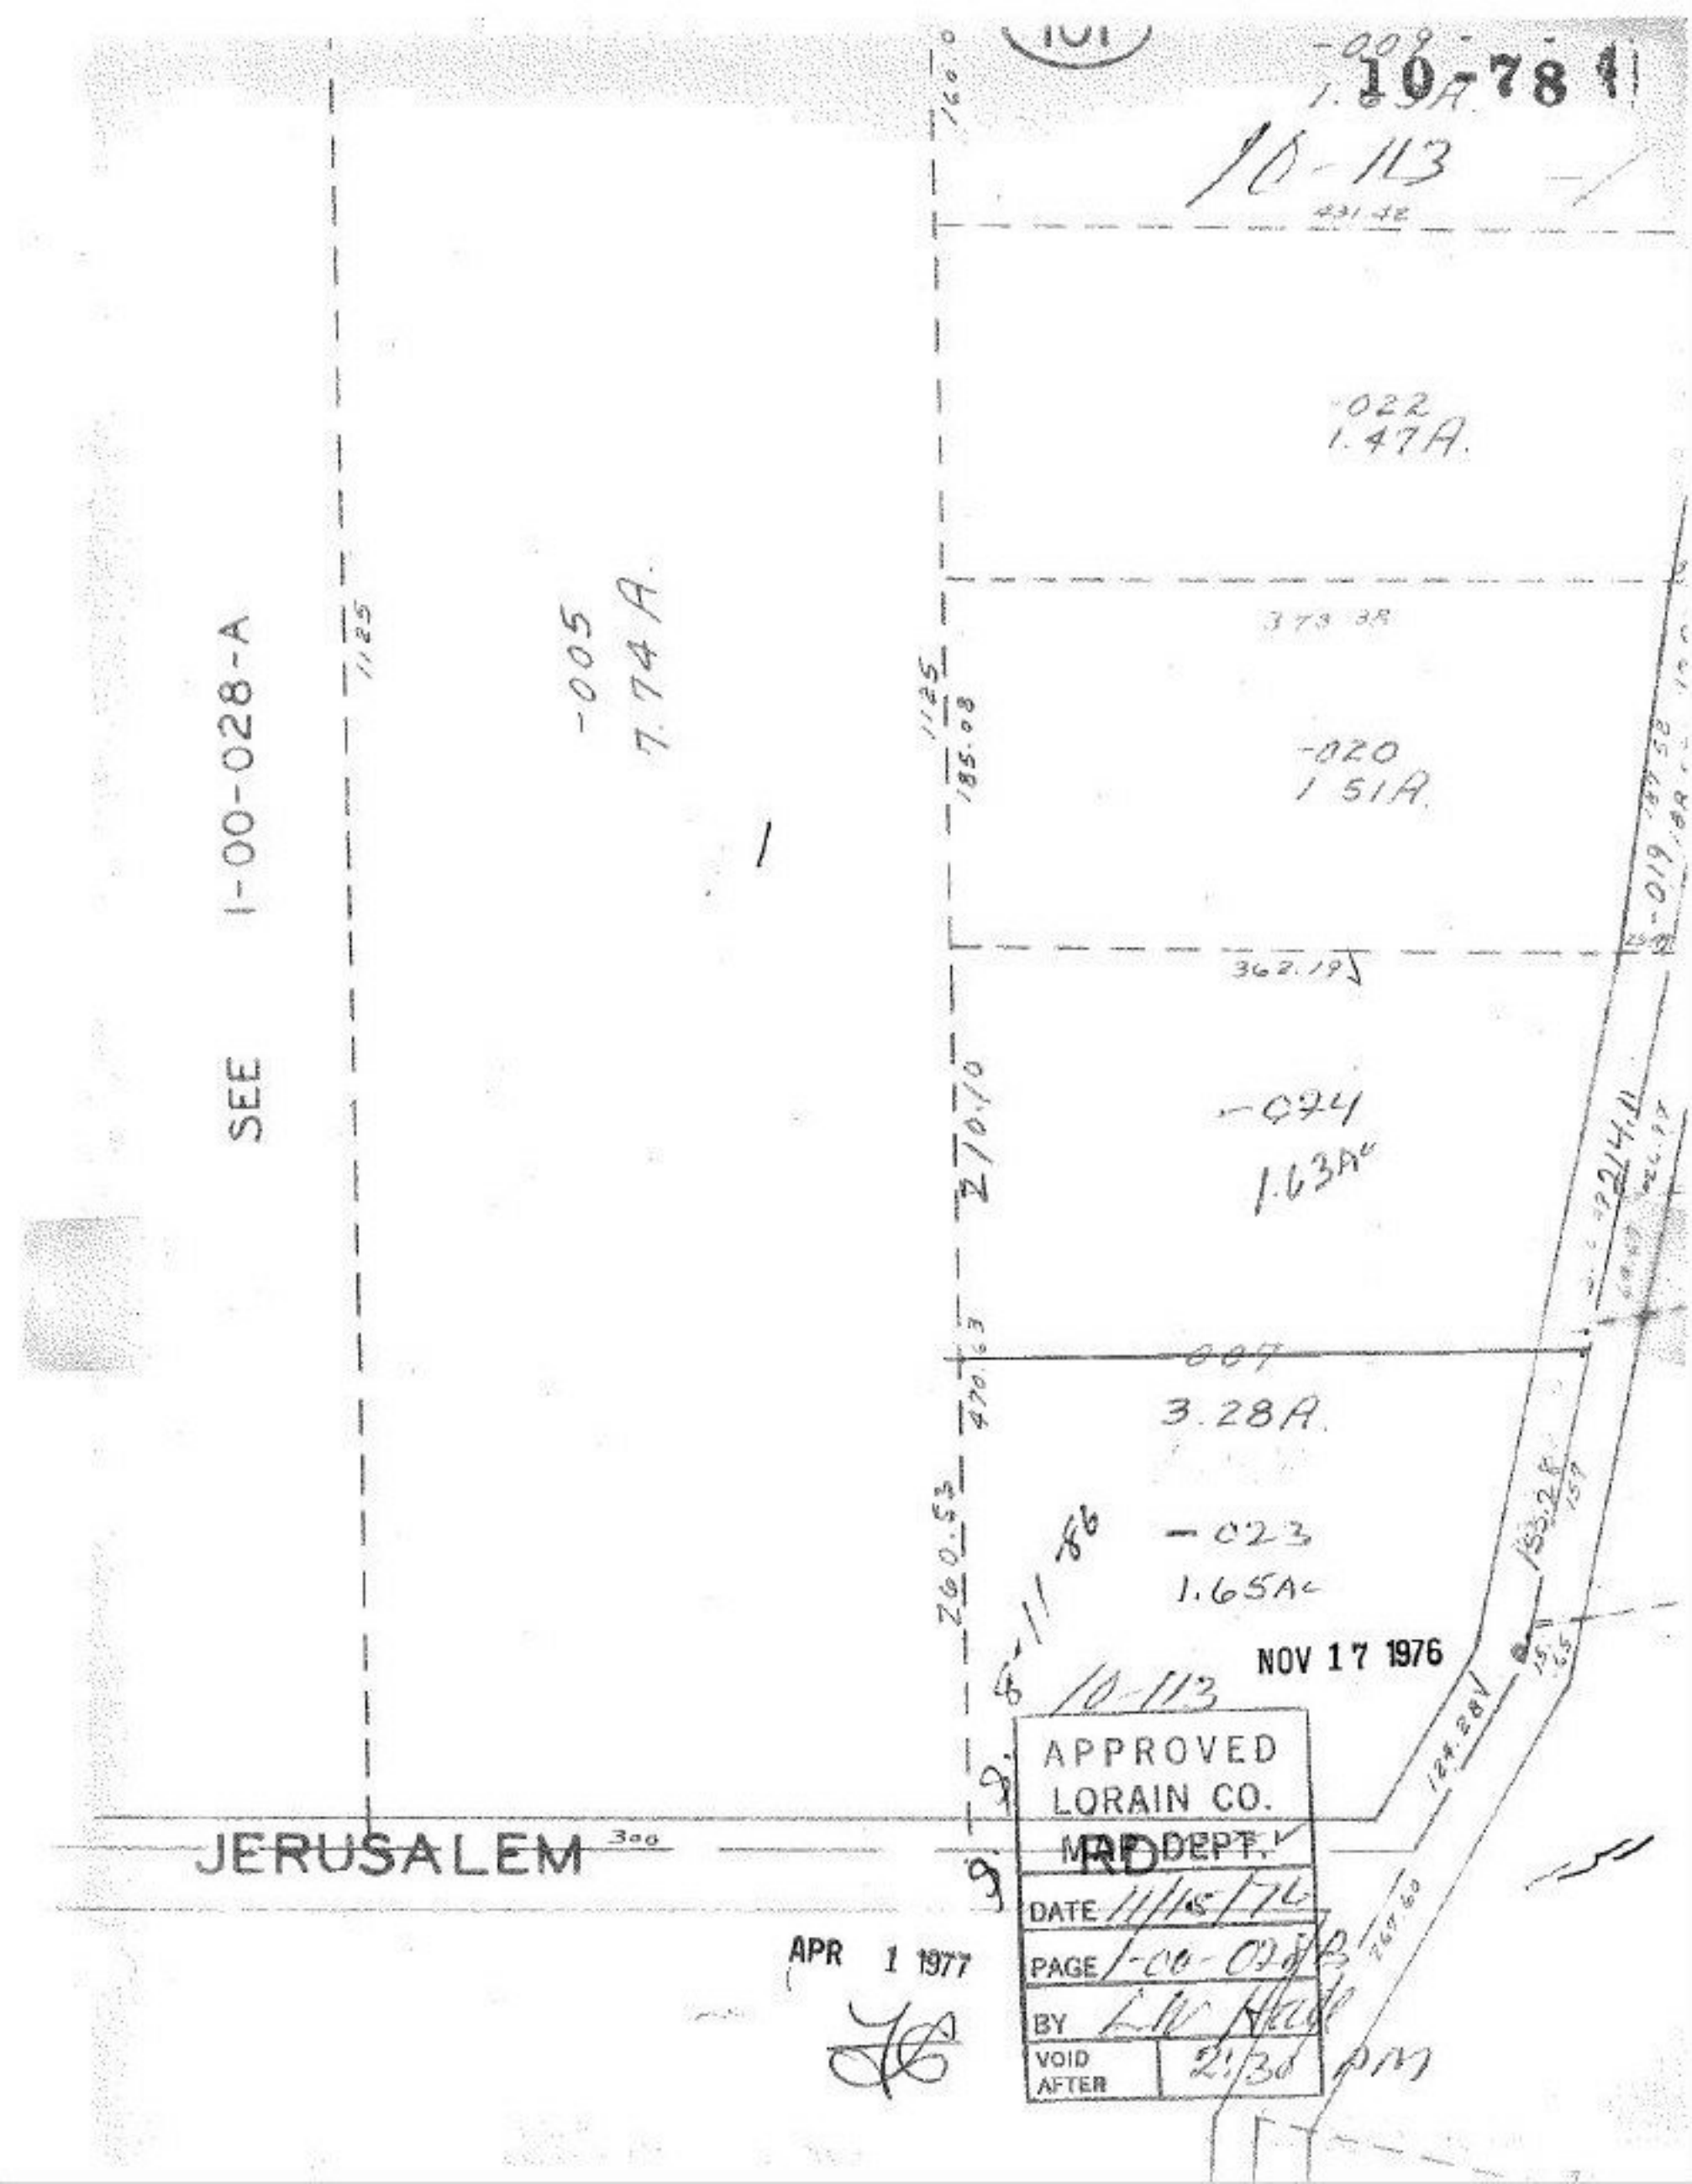

10-78
10-113
-009
1.69A.
431.42
-022
1.47A.
373.38
-020
1.51A.
362.19
-024
1.63Ac
-007
3.28A.
-023
1.65Ac
-005
7.74A.
1125
185.08
270.70
470.63
260.53
1-00-028-A
SEE
JERUSALEM
300
NOV 17 1976
10-113
APPROVED
LORAIN CO.
MAP DEPT.
RD
DATE 11/15/76
PAGE 1-00-028B
BY
VOID AFTER 2:30 PM
APR 1 1977