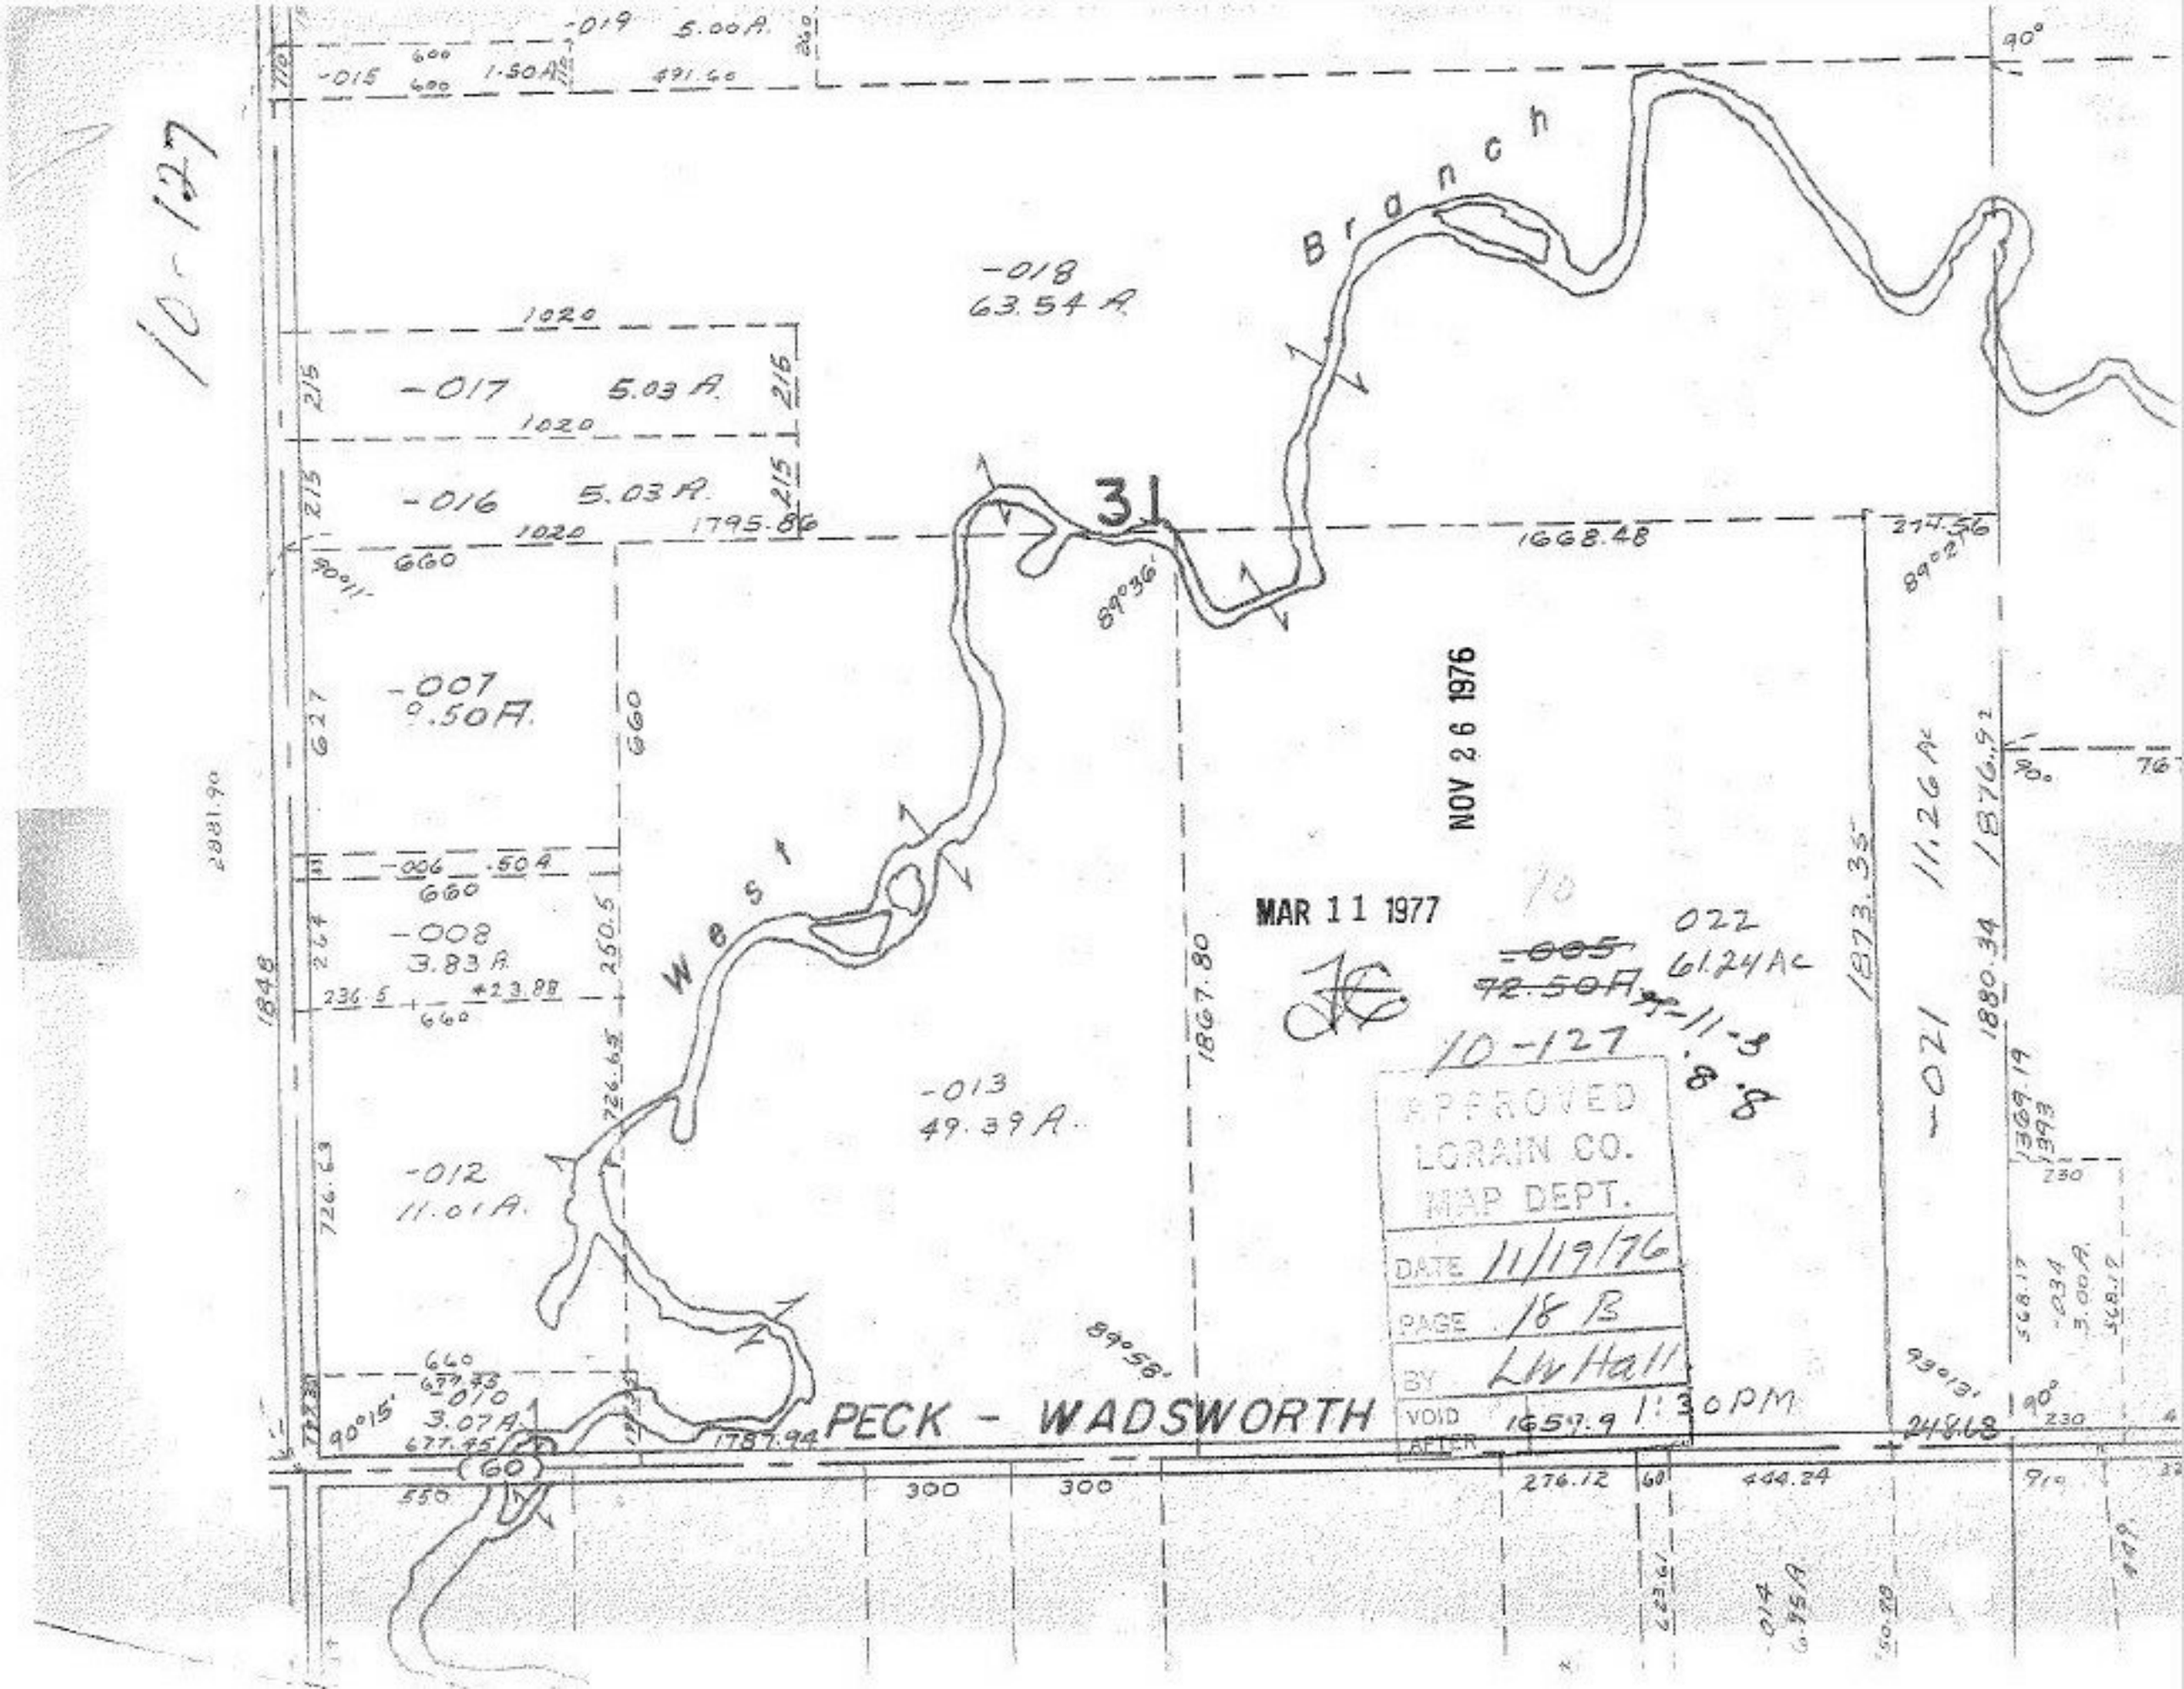
10-127
-019 5.00A.
-015 1.50A.
491.60
-018
63.54 A.
Branch
-017 5.03 A.
-016 5.03 A.
1795.86
31
1668.48
-007
9.50A.
-006 .50A
-008
3.83 A.
West
-013
49.39 A.
-012
11.01 A.
-010
3.07 A.
PECK - WADSWORTH
NOV 26 1976
MAR 11 1977
022
61.24 Ac
~~-005~~
~~72.50A~~
10-127
APPROVED
LORAIN CO.
MAP DEPT.
DATE 11/19/76
PAGE 18 B
BY LW Hall
VOID AFTER 1659.9 1:30 PM
-021
11.26 Ac
1873.35
1876.92
1880.34
1867.80
1848
2881.90
1787.94
1659.9
248.68
276.12
444.24
300
300
550
90°
90°15'
90°11'
89°36'
89°58'
90°21'
90°13'
90°
90°
230
230
1369.19
1393
568.17
568.17
-034
3.00A.
-014
6.75A
-011-3
.8 .8