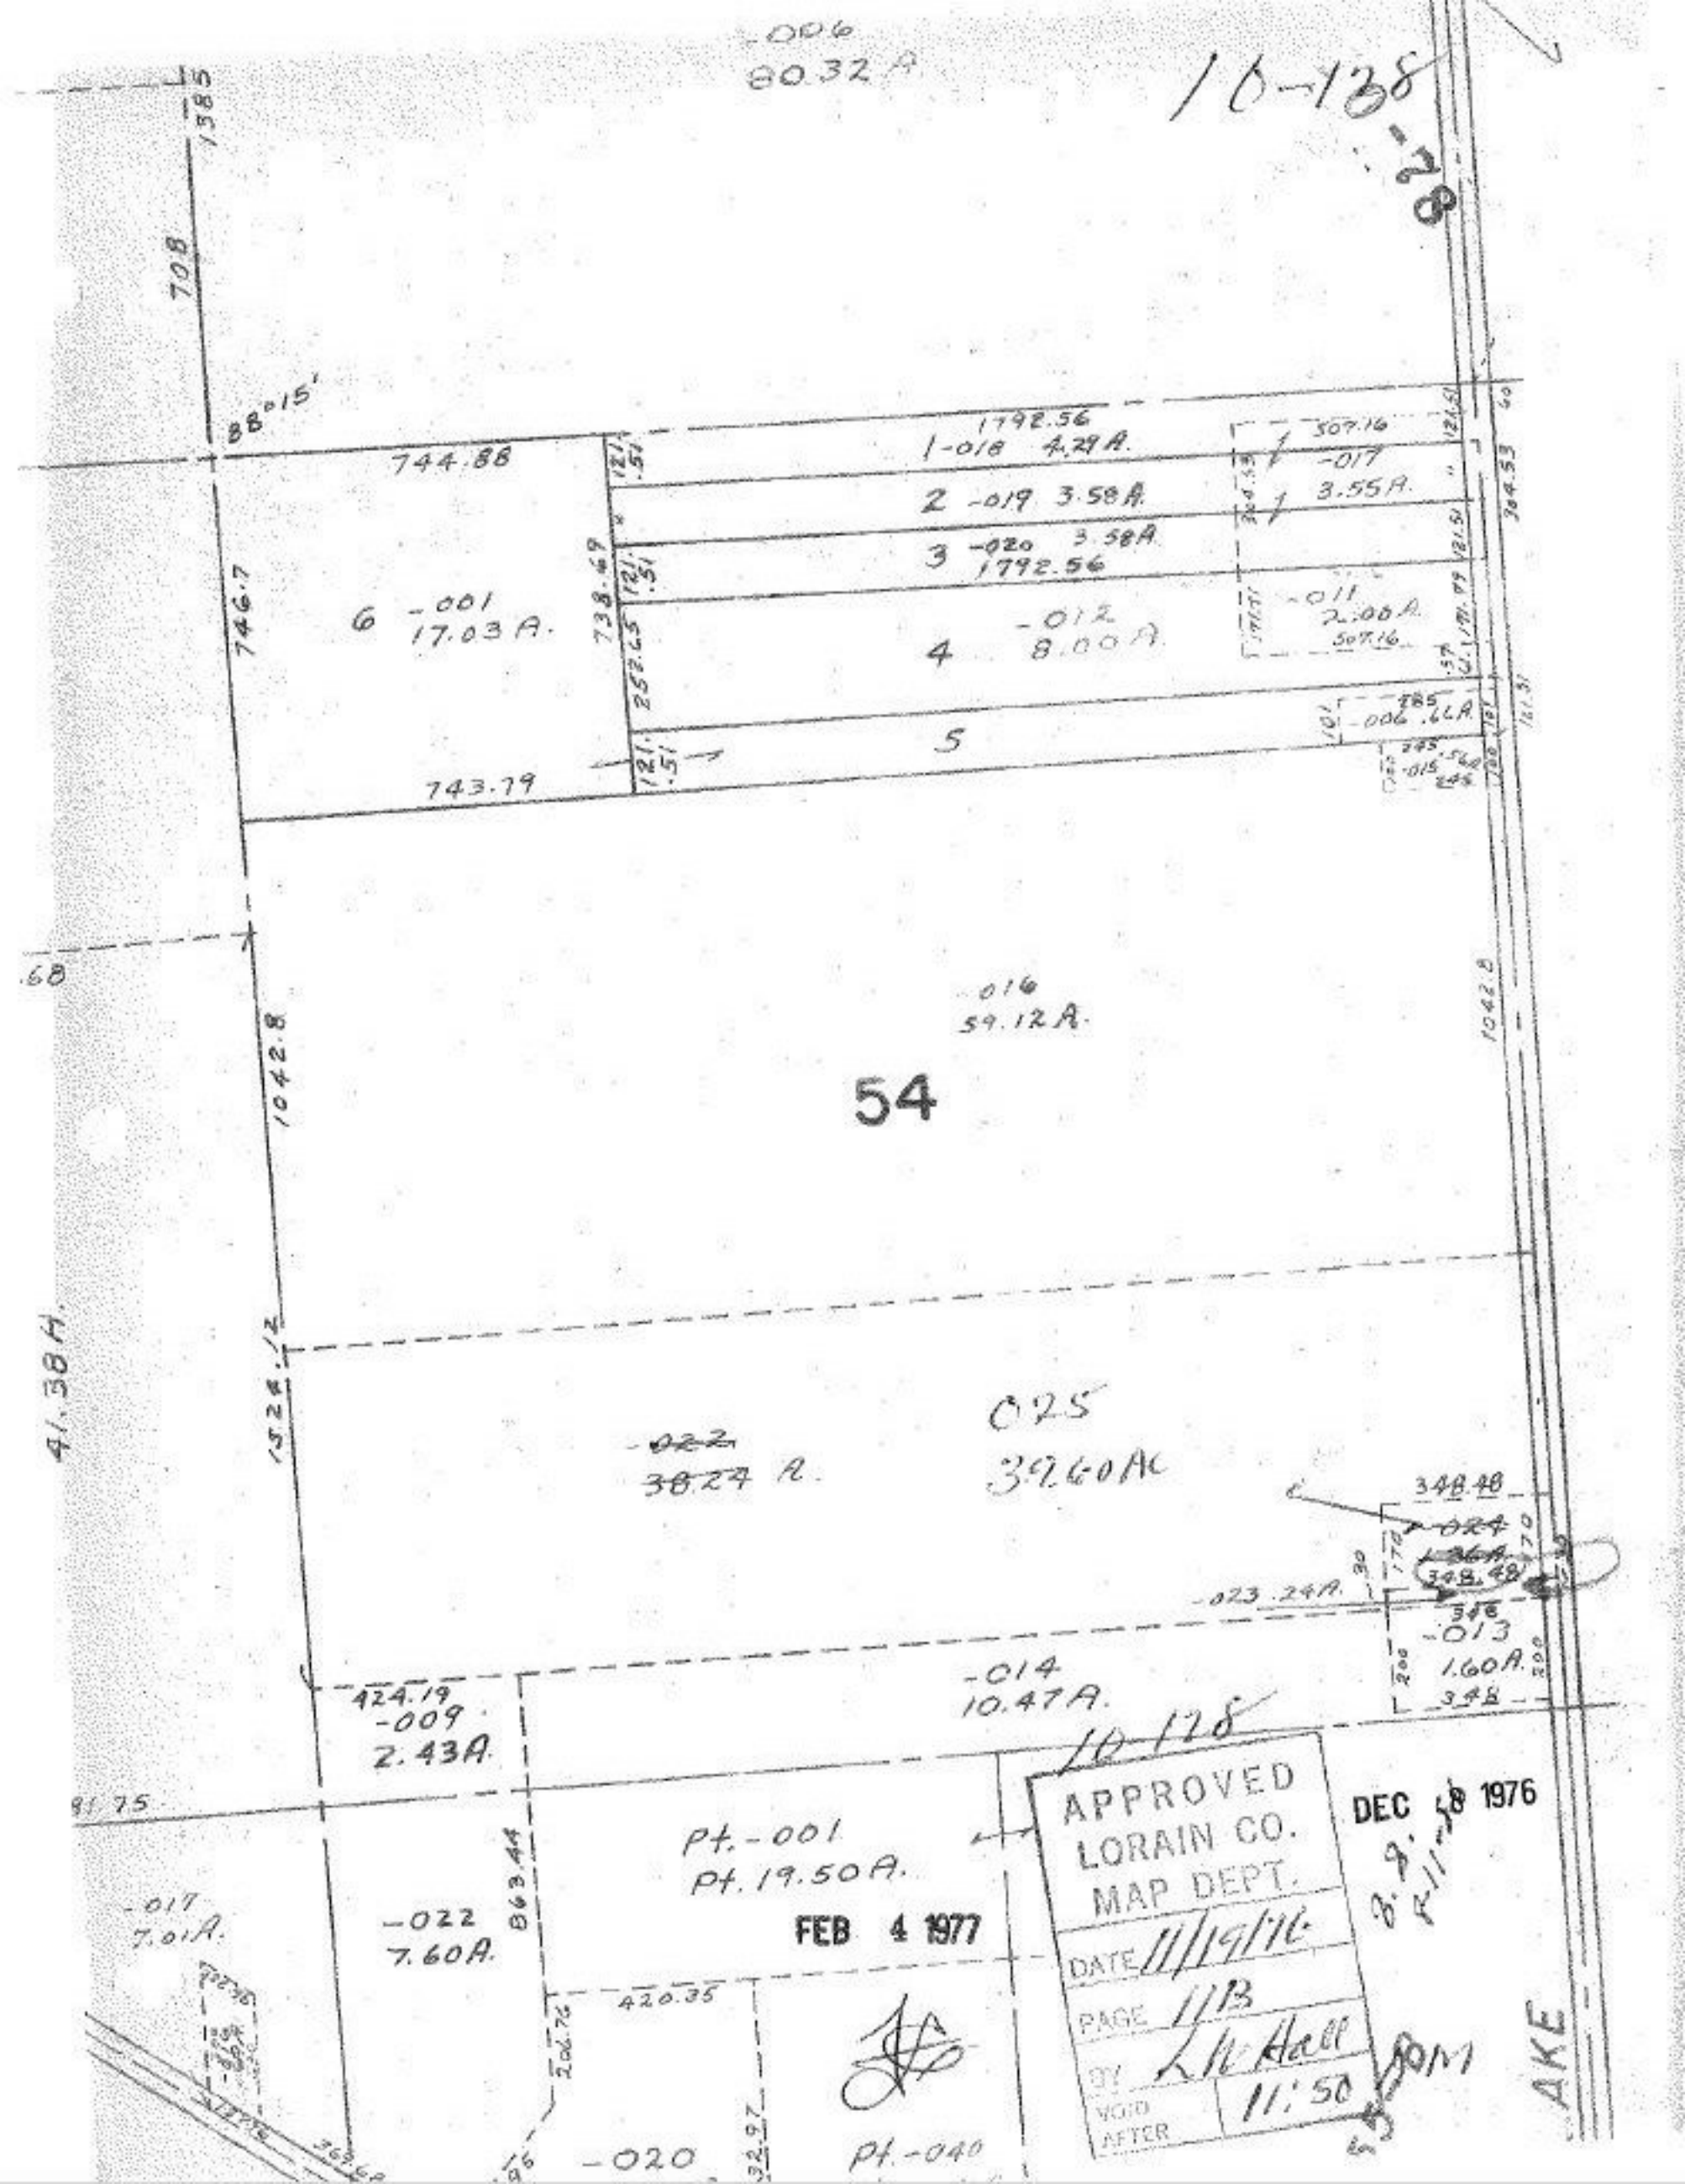

-006
80.32 A
10-138
-78
1385
708
88°15'
744.88
1792.56
1-018 4.29 A.
2 -019 3.58 A.
3 -020 3.58 A
1792.56
507.16
-017
3.55 A.
6 -001
17.03 A.
746.7
738.69
252.65
4 -012
8.00 A.
-011
2.00 A.
507.16
5
-006 .66 A.
743.79
.68
-016
59.12 A.
54
1042.8
41.38 A.
1524.12
-022
38.24 A.
025
39.60 AC
348.48
-024
-023 .24 A.
-013
1.60 A.
348
424.19
-009
2.43 A.
-014
10.47 A.
10-128
81.75
Pt.-001
Pt. 19.50 A.
-017
7.01 A.
-022
7.60 A.
863.44
420.35
-020
Pt.-040
APPROVED
LORAIN CO.
MAP DEPT.
DATE 11/19/76
PAGE 11B
BY L.W. Hall
VOID AFTER 11:50
DEC 8 1976
FEB 4 1977
AKE