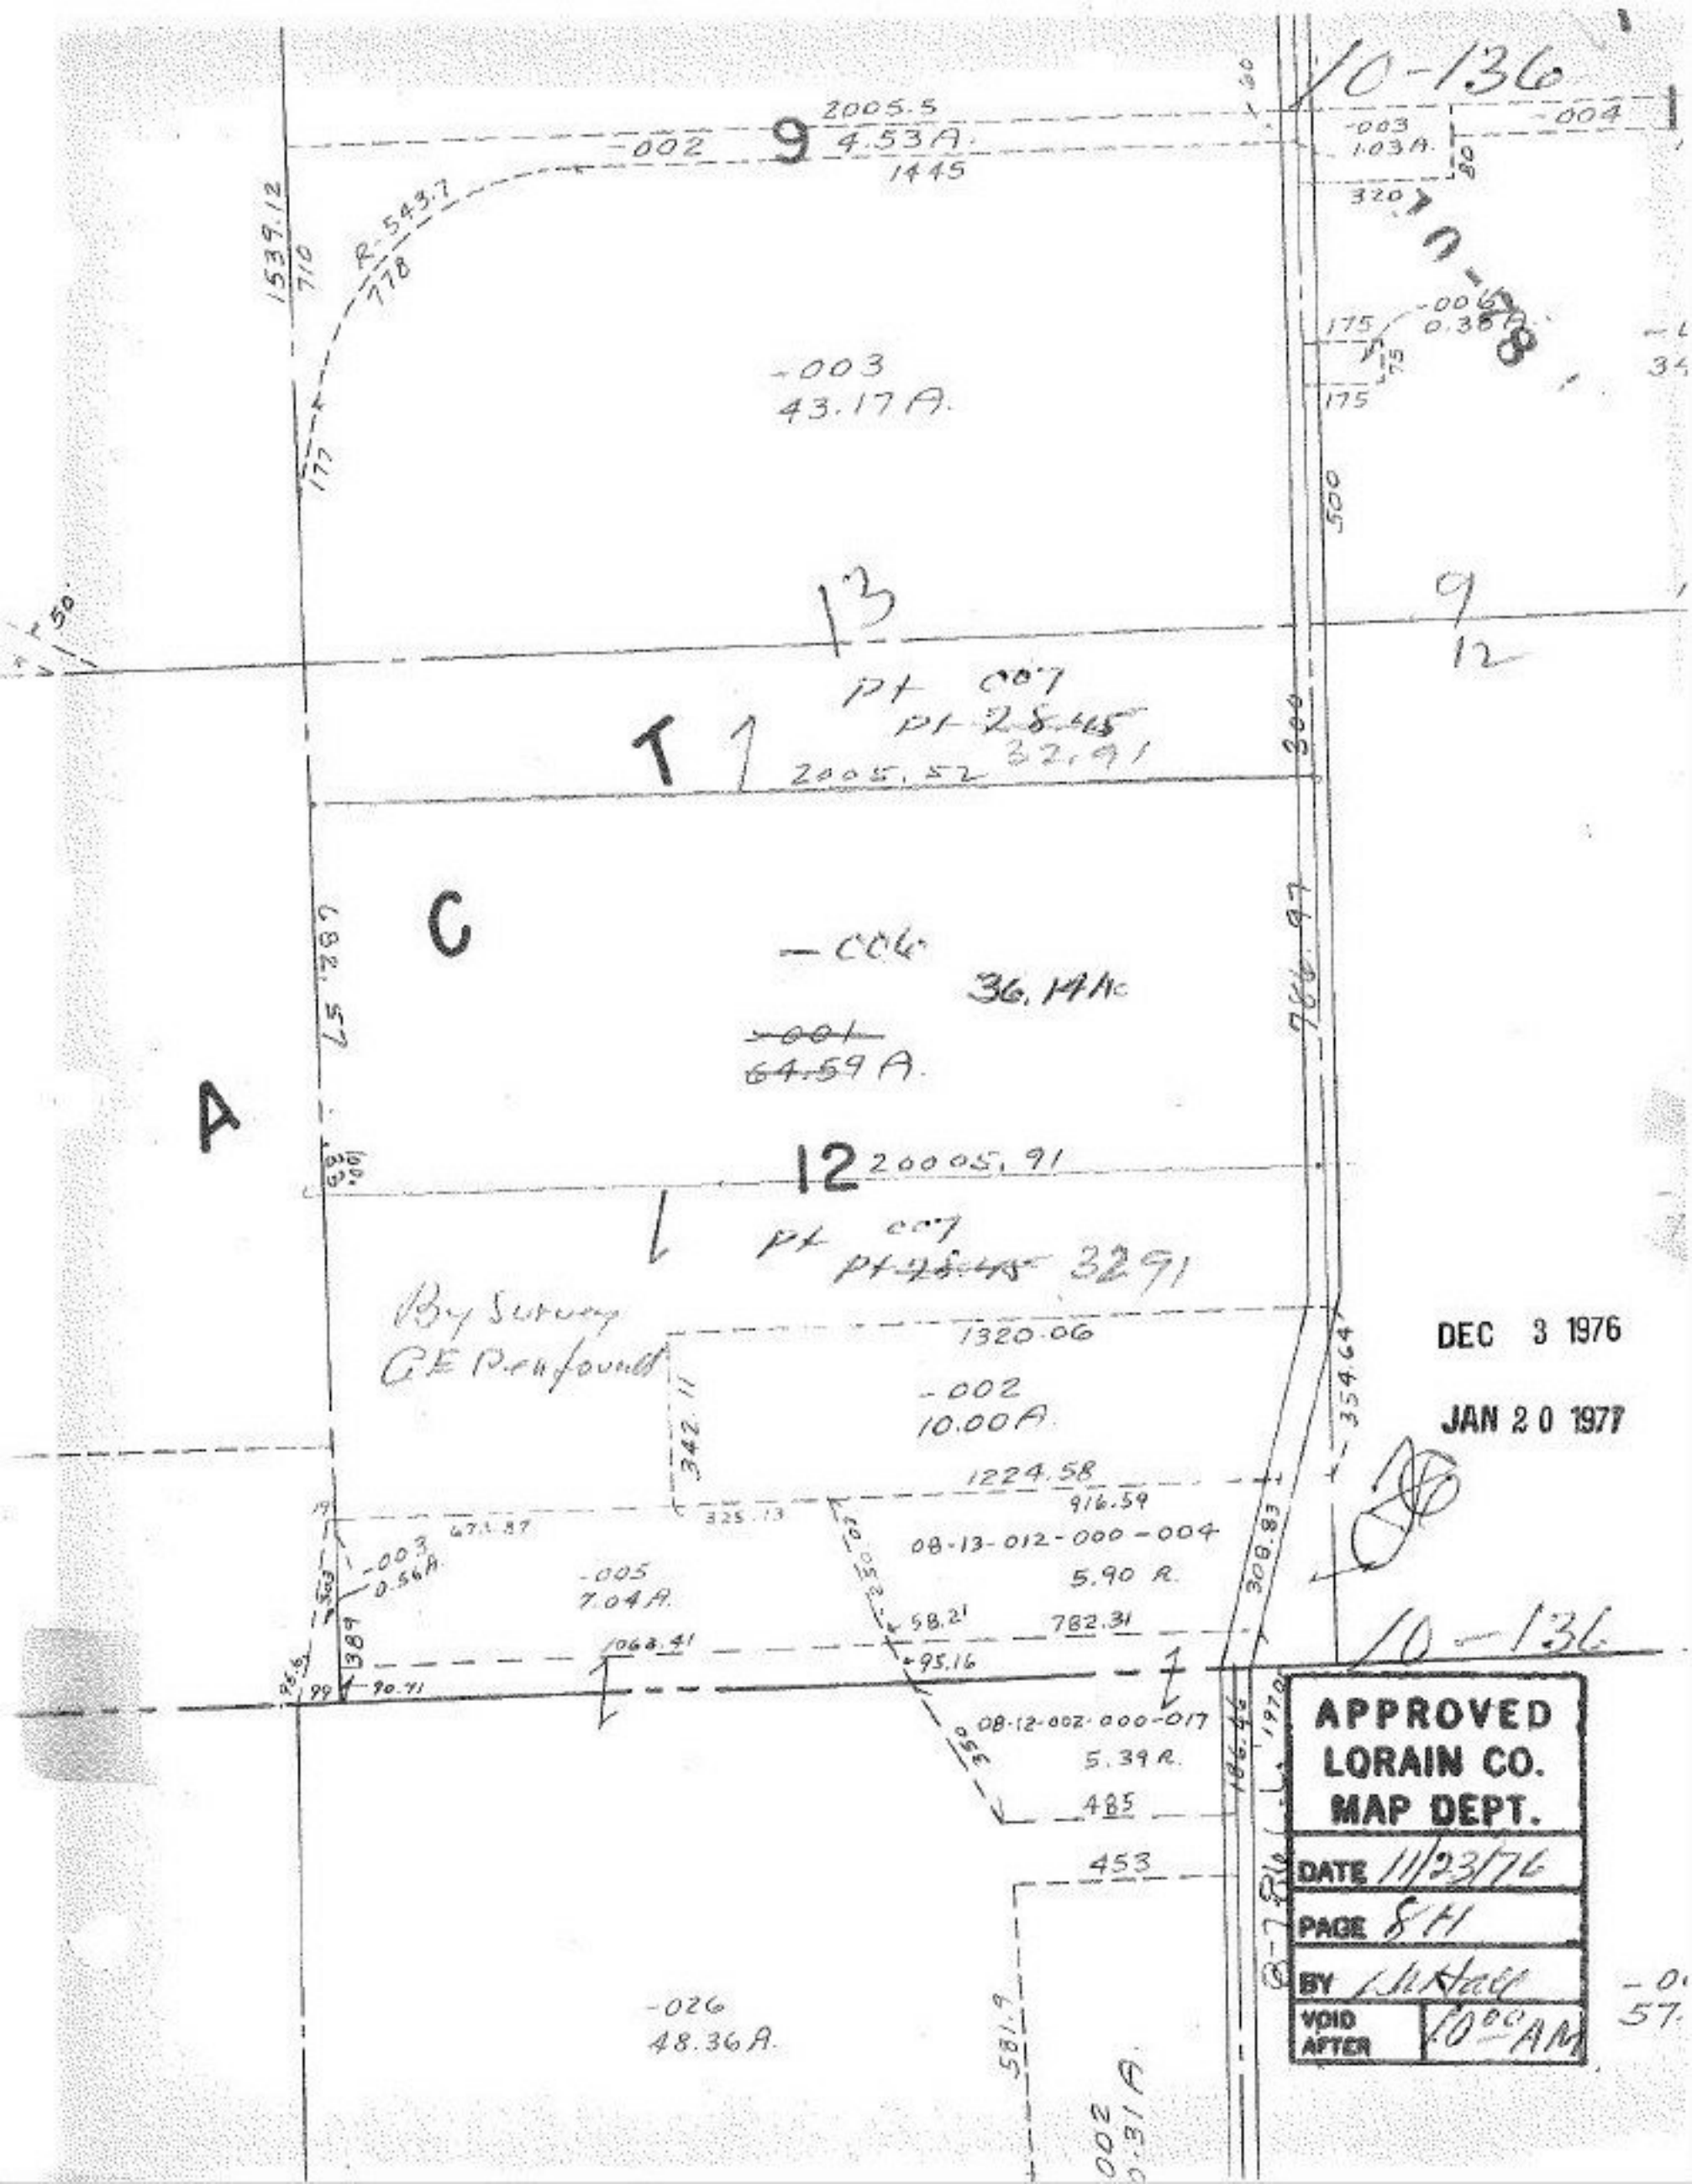
10-136
2005.5
9
4.53A.
1445
-002
-003
1.03A.
-004
320
R-543.7
778
1539.12
710
-003
43.17A.
175
-006
0.38A.
175
500
13
9
12
Pt 007
Pt 28.45
32.91
T
2005.52
300
C
-006
36.14Ac
-001
64.59A.
682.57
A
12
20005.91
Pt 007
Pt 28.45
32.91
By Survey
GE Renfound
1320.06
-002
10.00A.
342.11
354.64
1224.58
916.59
325.13
08-13-012-000-004
5.90 A.
-003
0.56A.
-005
7.04A.
58.21
782.31
1063.41
95.16
90.71
10-136
08-12-002-000-017
5.39 A.
485
453
-026
48.36A.
581.9
-002
0.31A.
DEC 3 1976
JAN 20 1977
APPROVED
LORAIN CO.
MAP DEPT.
DATE 11/23/76
PAGE 8H
BY
VOID AFTER 10:00 AM