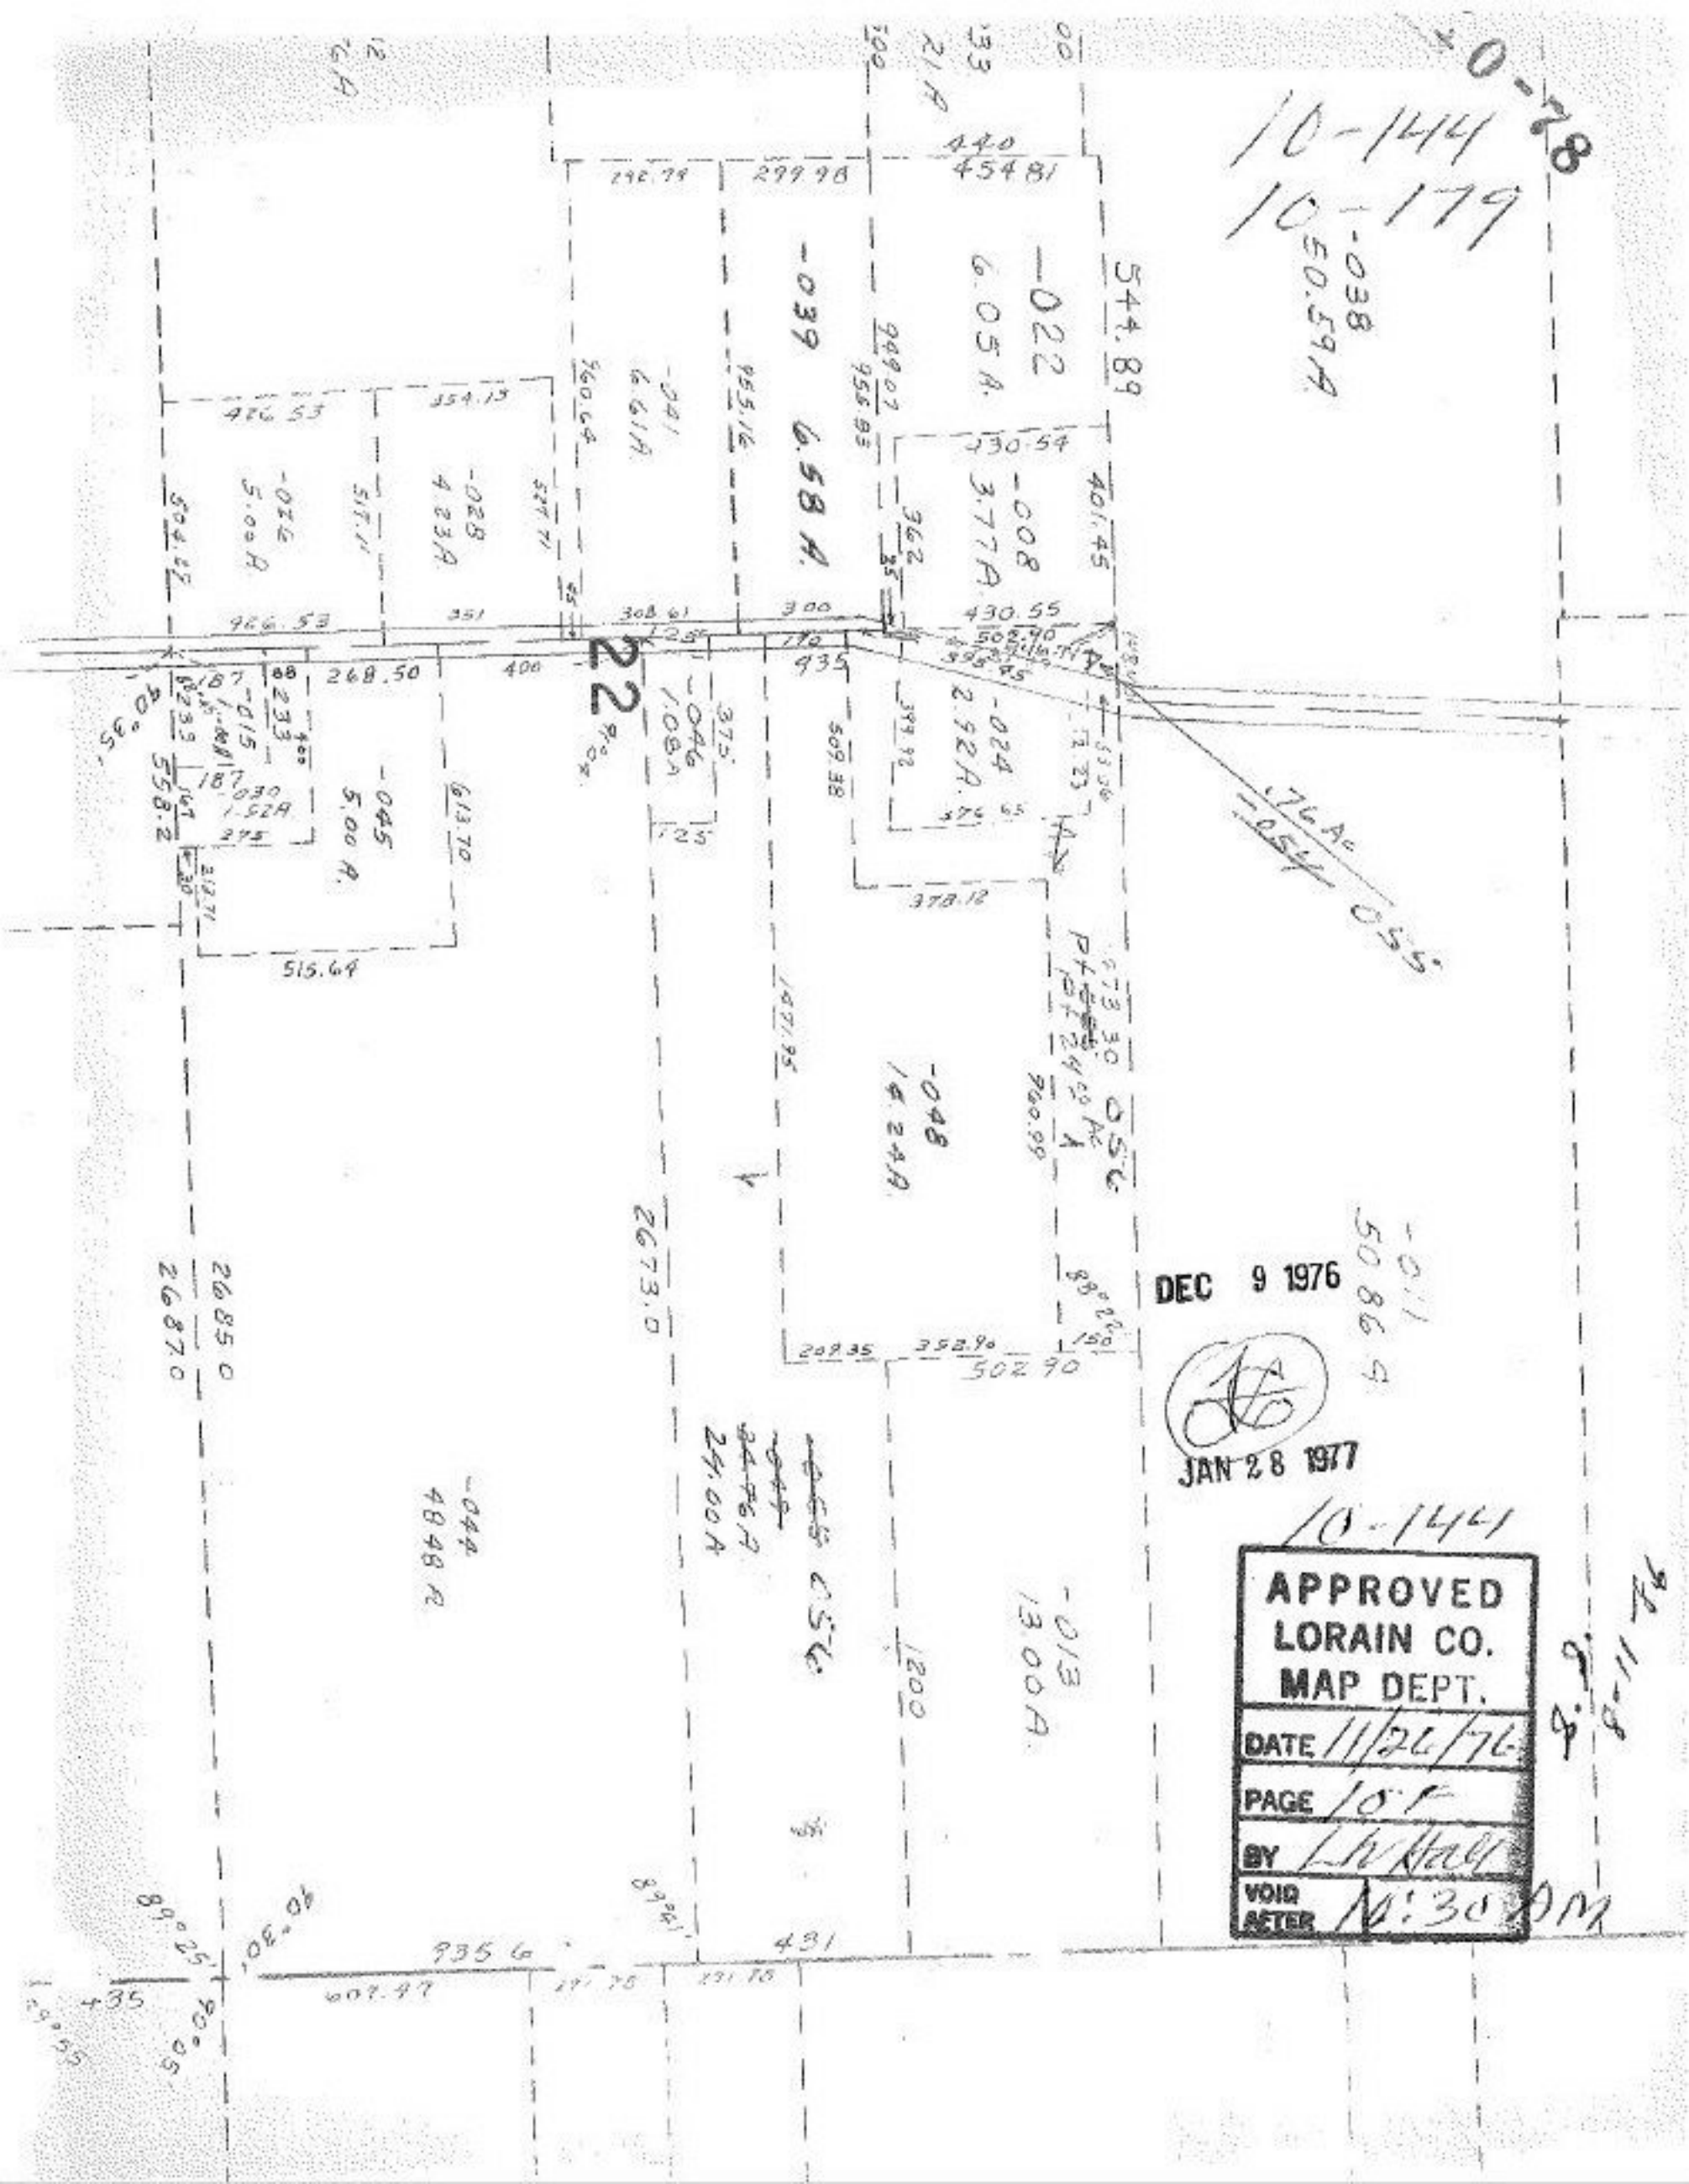
10-144
10-179
-038
50.59 A
-022
6.05 A.
-039
6.58 A.
-041
6.61 A
-008
3.77 A
-024
2.92 A.
-046
1.08 A
-045
5.00 A.
-048
14.24 A
-044
4848 A
-013
13.00 A
544.89
426.53
354.13
430.54
401.45
430.55
268.50
515.64
378.12
502.90
935.6
431
DEC 9 1976
JAN 28 1977
10-144
APPROVED
LORAIN CO.
MAP DEPT.
DATE 11/26/76
PAGE 10 F
BY
VOID AFTER 10:30 AM