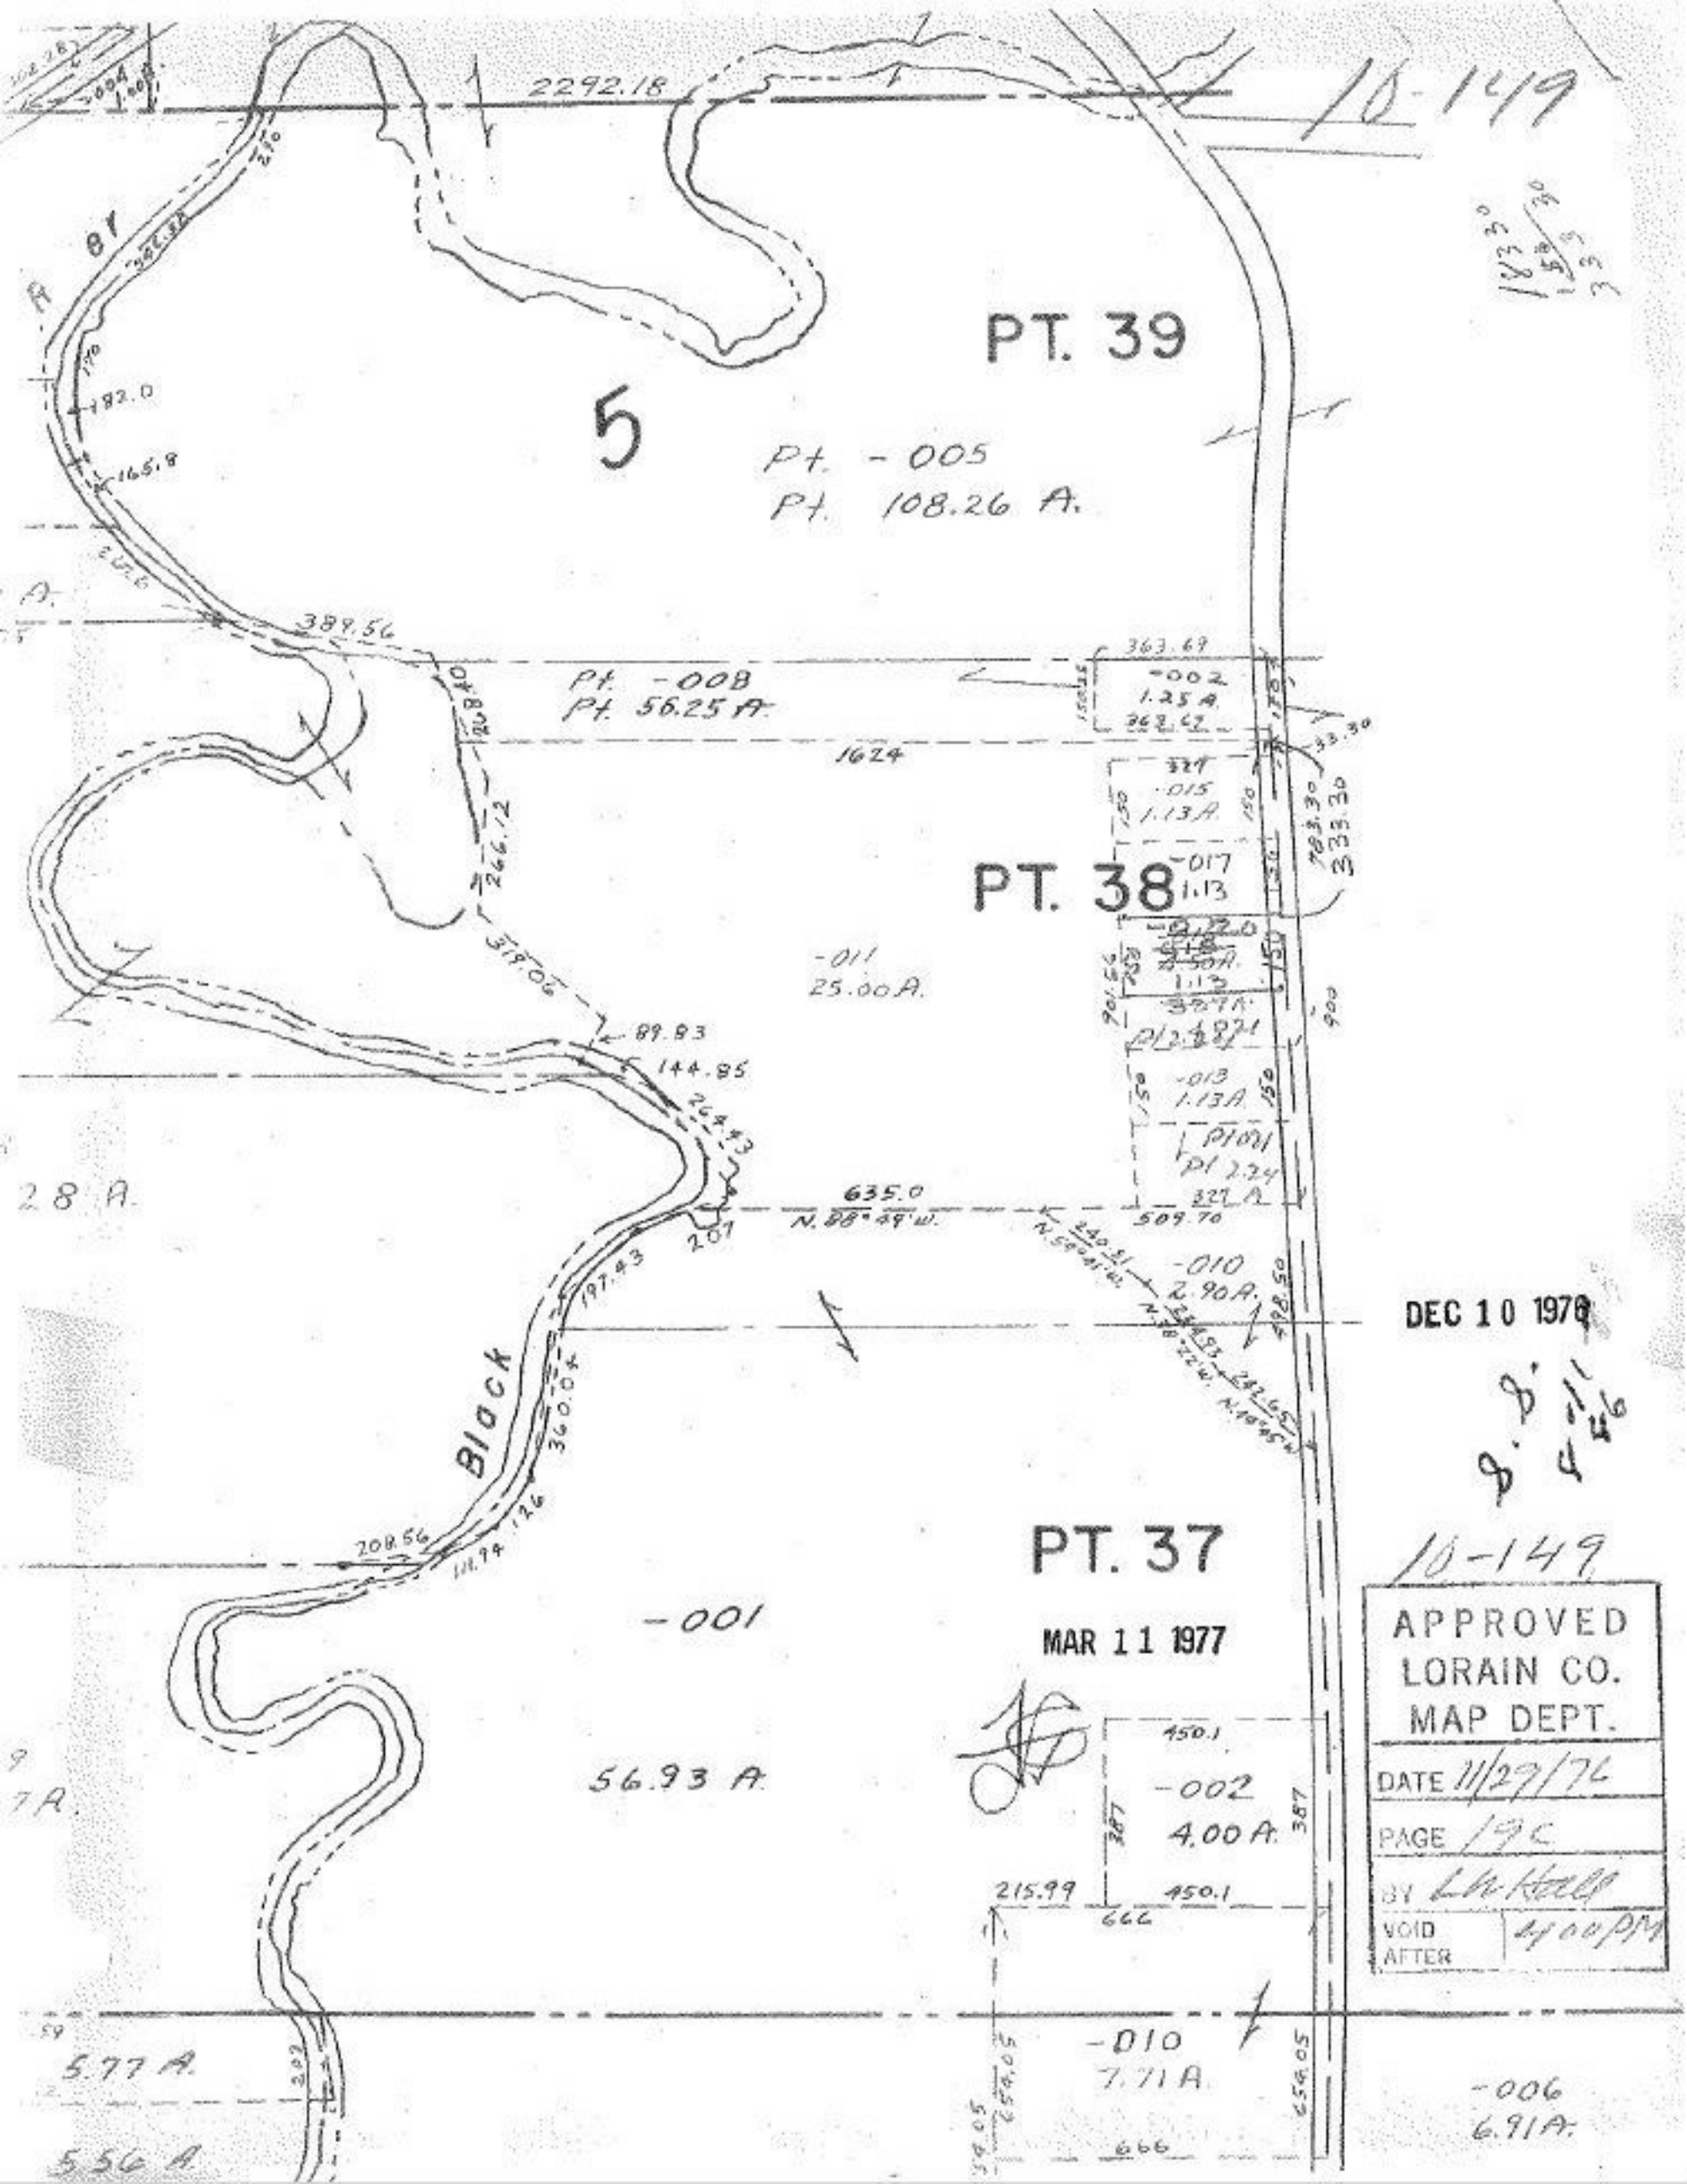
10-149
2292.18
PT. 39
5
Pt. -005
Pt. 108.26 A.
389.56
Pt. -008
Pt. 56.25 A.
1624
363.69
-002
1.25 A.
-015
1.13 A.
-017
1.13
PT. 38
-011
25.00 A.
-013
1.13 A.
-010
2.90 A.
635.0
N. 88° 49' W.
Black
PT. 37
-001
56.93 A.
-002
4.00 A.
-010
7.71 A.
-006
6.91 A.
5.77 A.
5.56 A.
DEC 10 1976
MAR 11 1977
10-149
APPROVED
LORAIN CO.
MAP DEPT.
DATE 11/29/76
PAGE 19C
BY L.H. Hall
VOID AFTER 4:00 PM