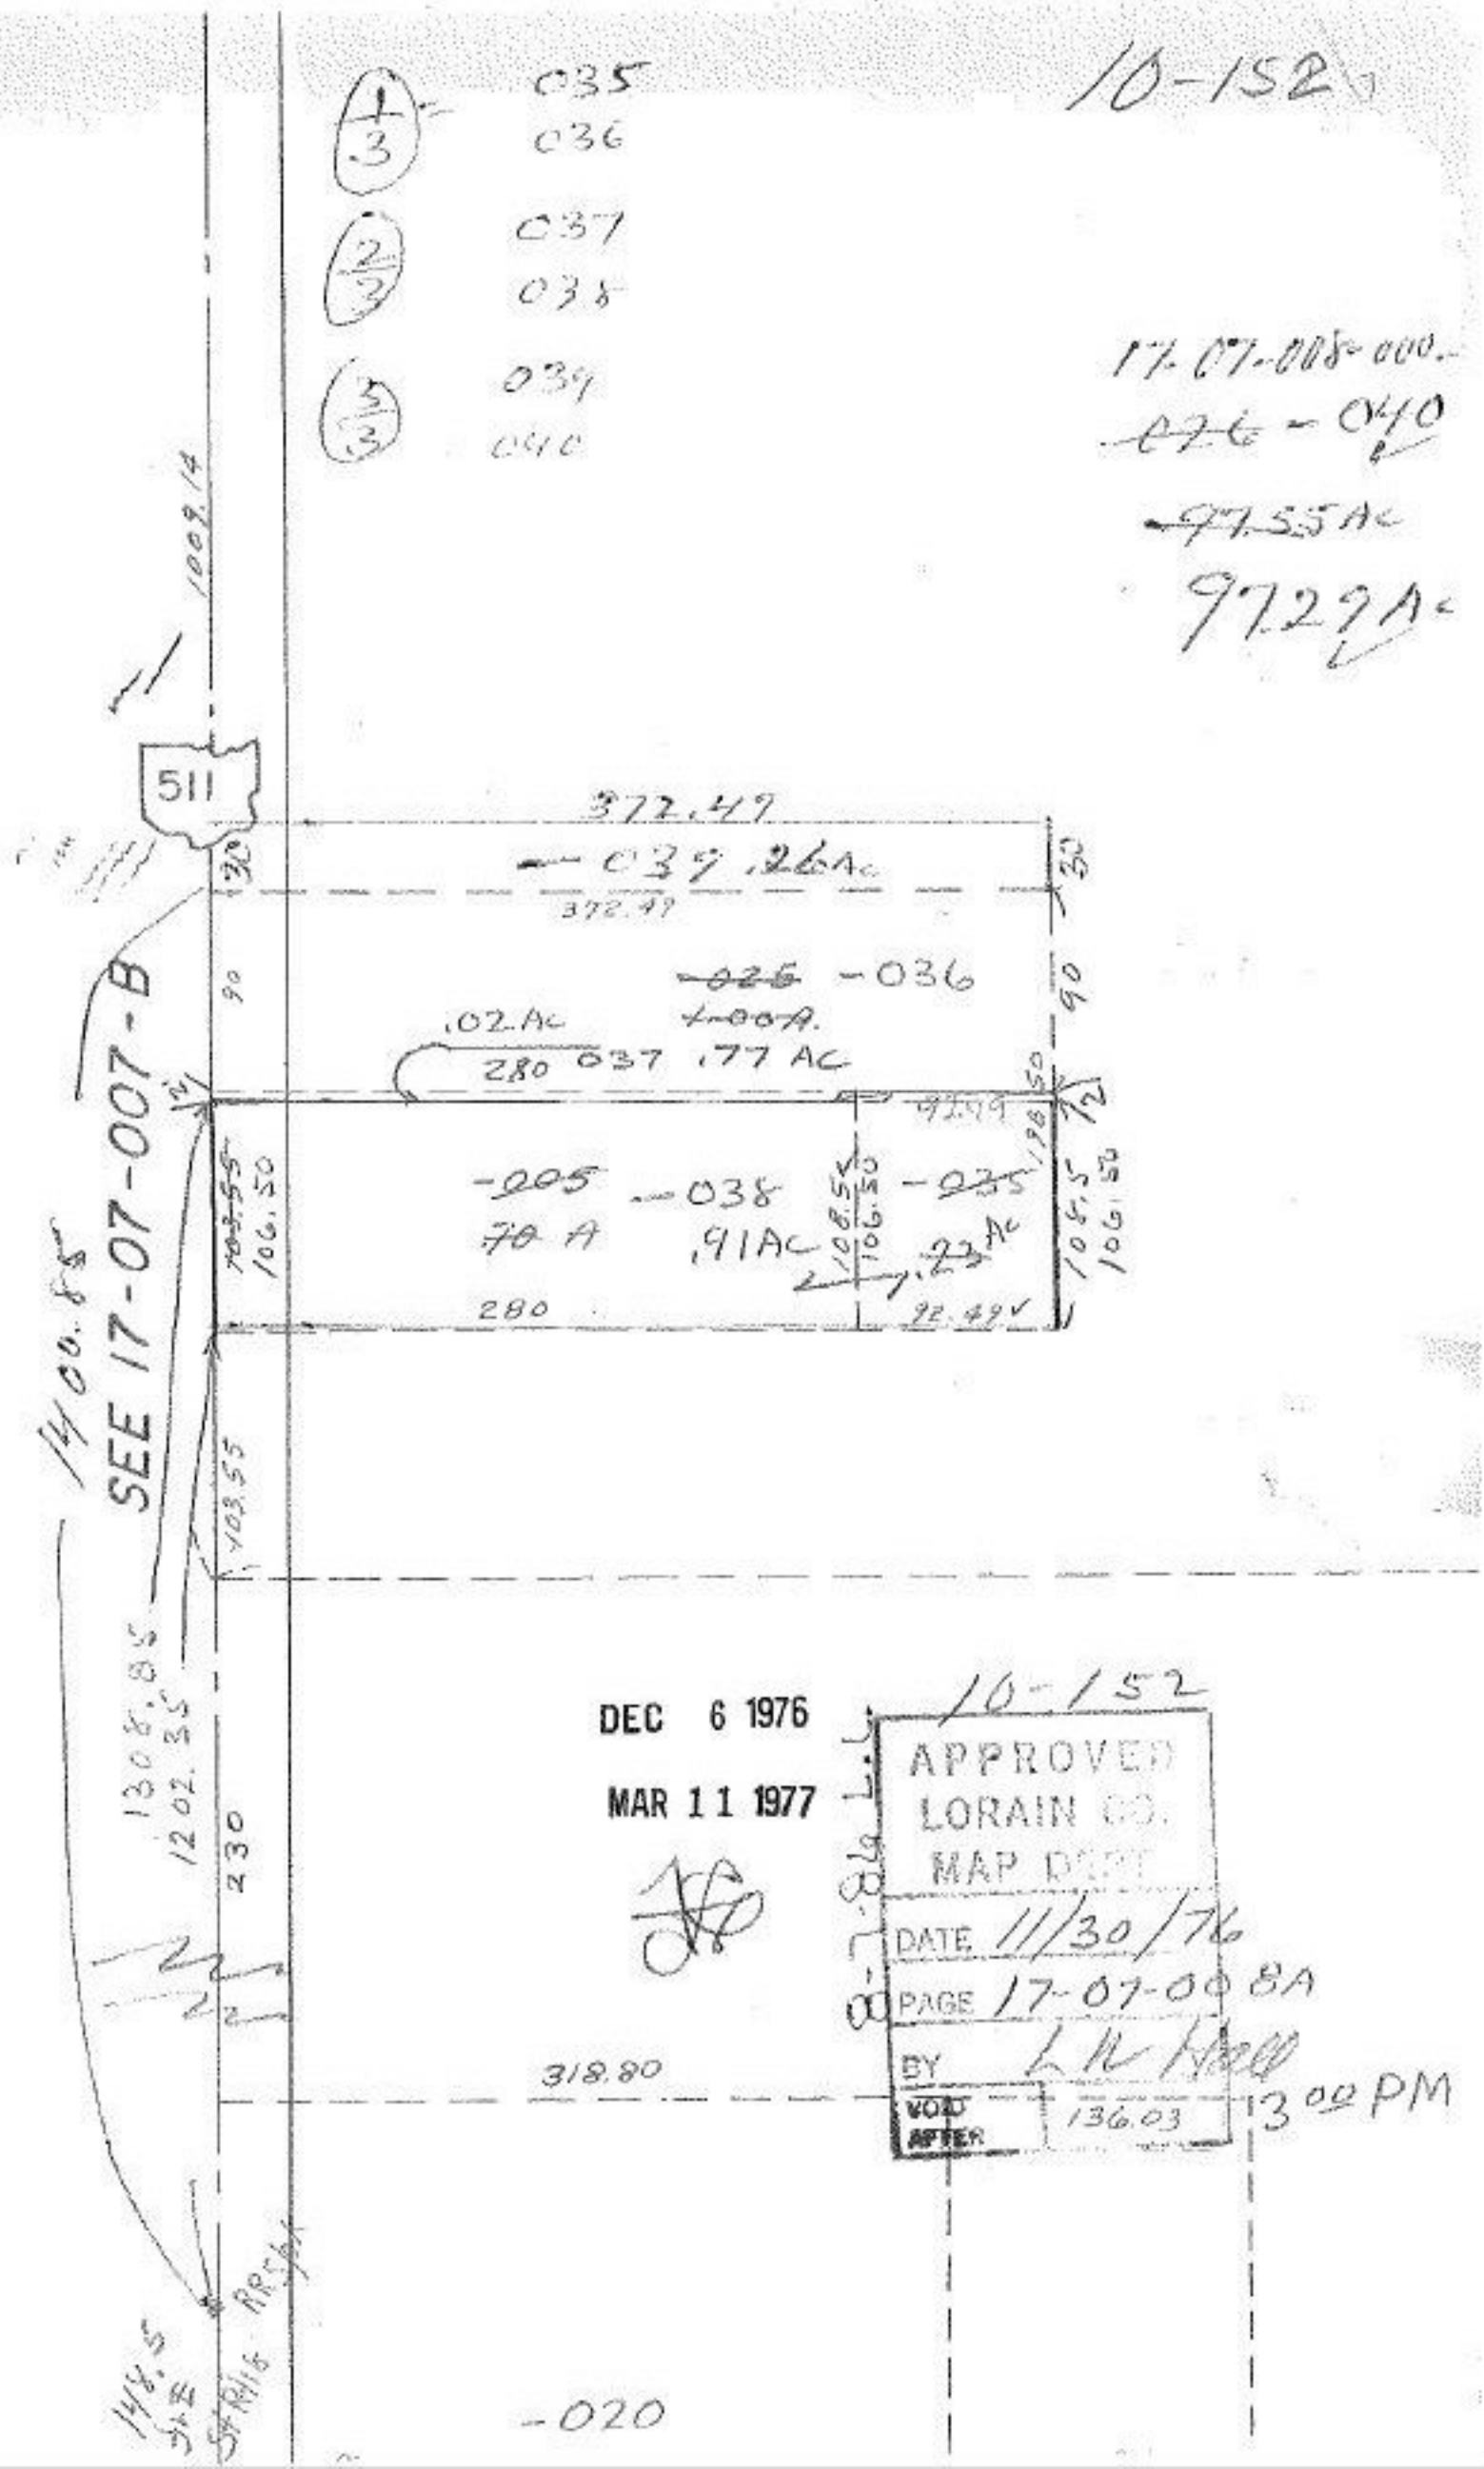
10-152
035
036
037
038
039
040
17-07-008-000
~~026~~ - 040
~~97.55 Ac~~
97.29 Ac
1009.14
511
372.49
-039 .26 Ac
372.49
~~026~~ -036
~~1.00 A.~~
.02 Ac
280 037 .77 AC
-~~005~~ -038
~~70 A~~ .91 AC
-~~035~~
~~.23~~ Ac
280
92.49
SEE 17-07-007-B
1400.85
1308.85
1202.35
230
318.80
-020
DEC 6 1976
MAR 11 1977
10-152
APPROVED
LORAIN CO.
MAP DEPT
DATE 11/30/76
PAGE 17-07-008A
BY
VOID AFTER 136.03
3 00 PM