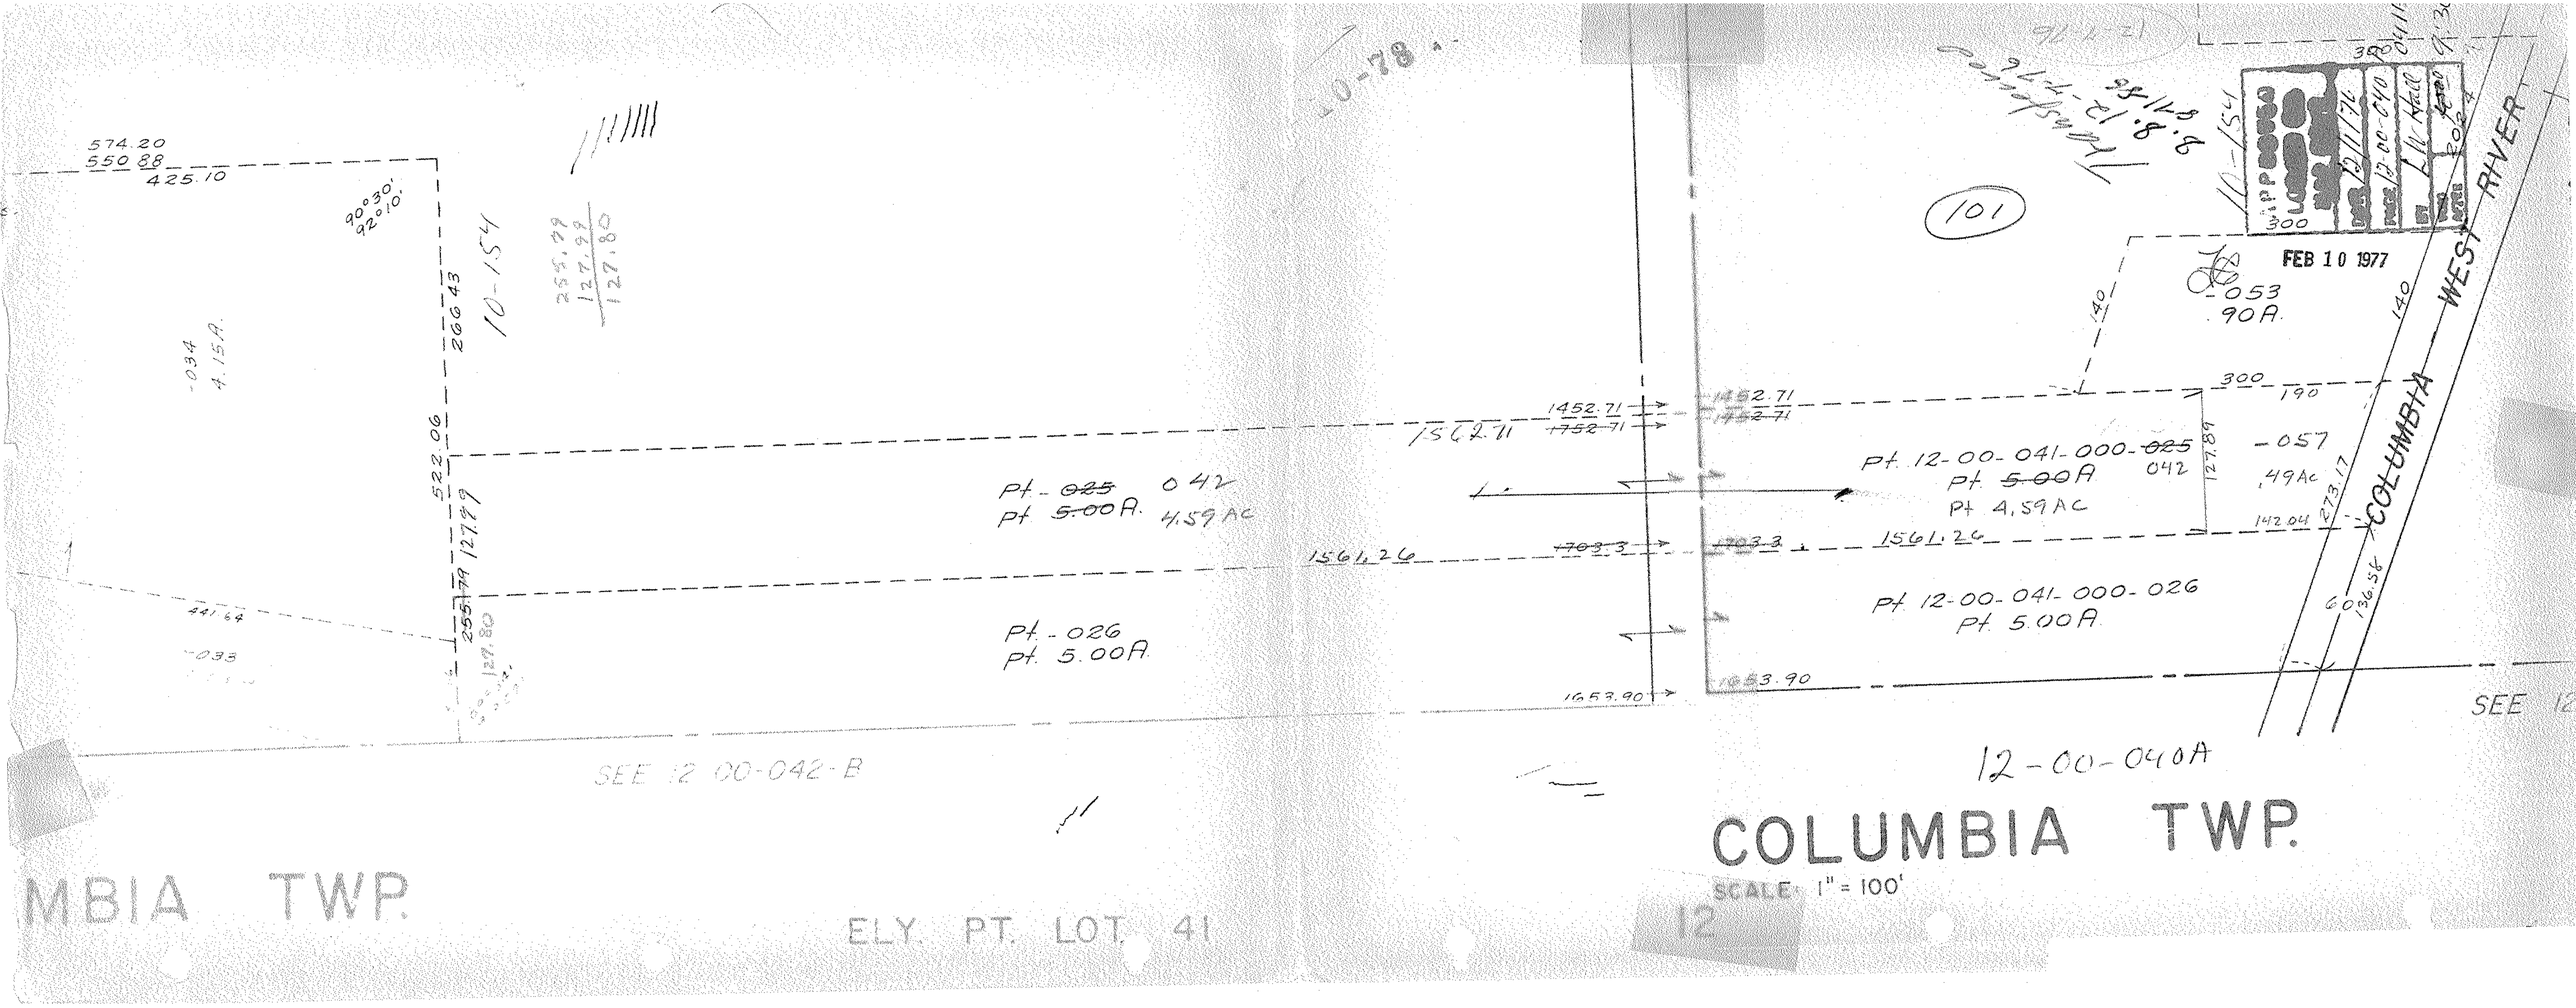

574.20
550.88
425.10
90°30'
92°10'
266.43
10-154
255.79
127.99
127.80
-034
4.15A.
522.06
127.99
255.79
127.80
441.64
-033
Pt. - ~~025~~ 042
Pt. ~~5.00~~A. 4.59AC
Pt. - 026
Pt. 5.00A.
1562.71
1452.71
1752.71
1561.26
1703.3
1653.90
Pt. 12-00-041-000-~~025~~ 042
Pt. ~~5.00~~A
Pt. 4.59AC
Pt. 12-00-041-000-026
Pt. 5.00A.
-053
.90A.
-057
.49Ac
127.89
142.04
273.17
136.58
140
300
190
101
10-154
FEB 10 1977
COLUMBIA WEST RIVER
SEE 12-00-042-B
12-00-040A
SEE 12
COLUMBIA TWP.
SCALE 1" = 100'
MBIA TWP.
ELY. PT. LOT 41
12