10-159

See 9F
Also

10-159

Pt. ~~[illegible]~~
Pt. ~~[illegible]~~ A
90.25

-031

DEC 6 1976

JAN 20 1977

10-159
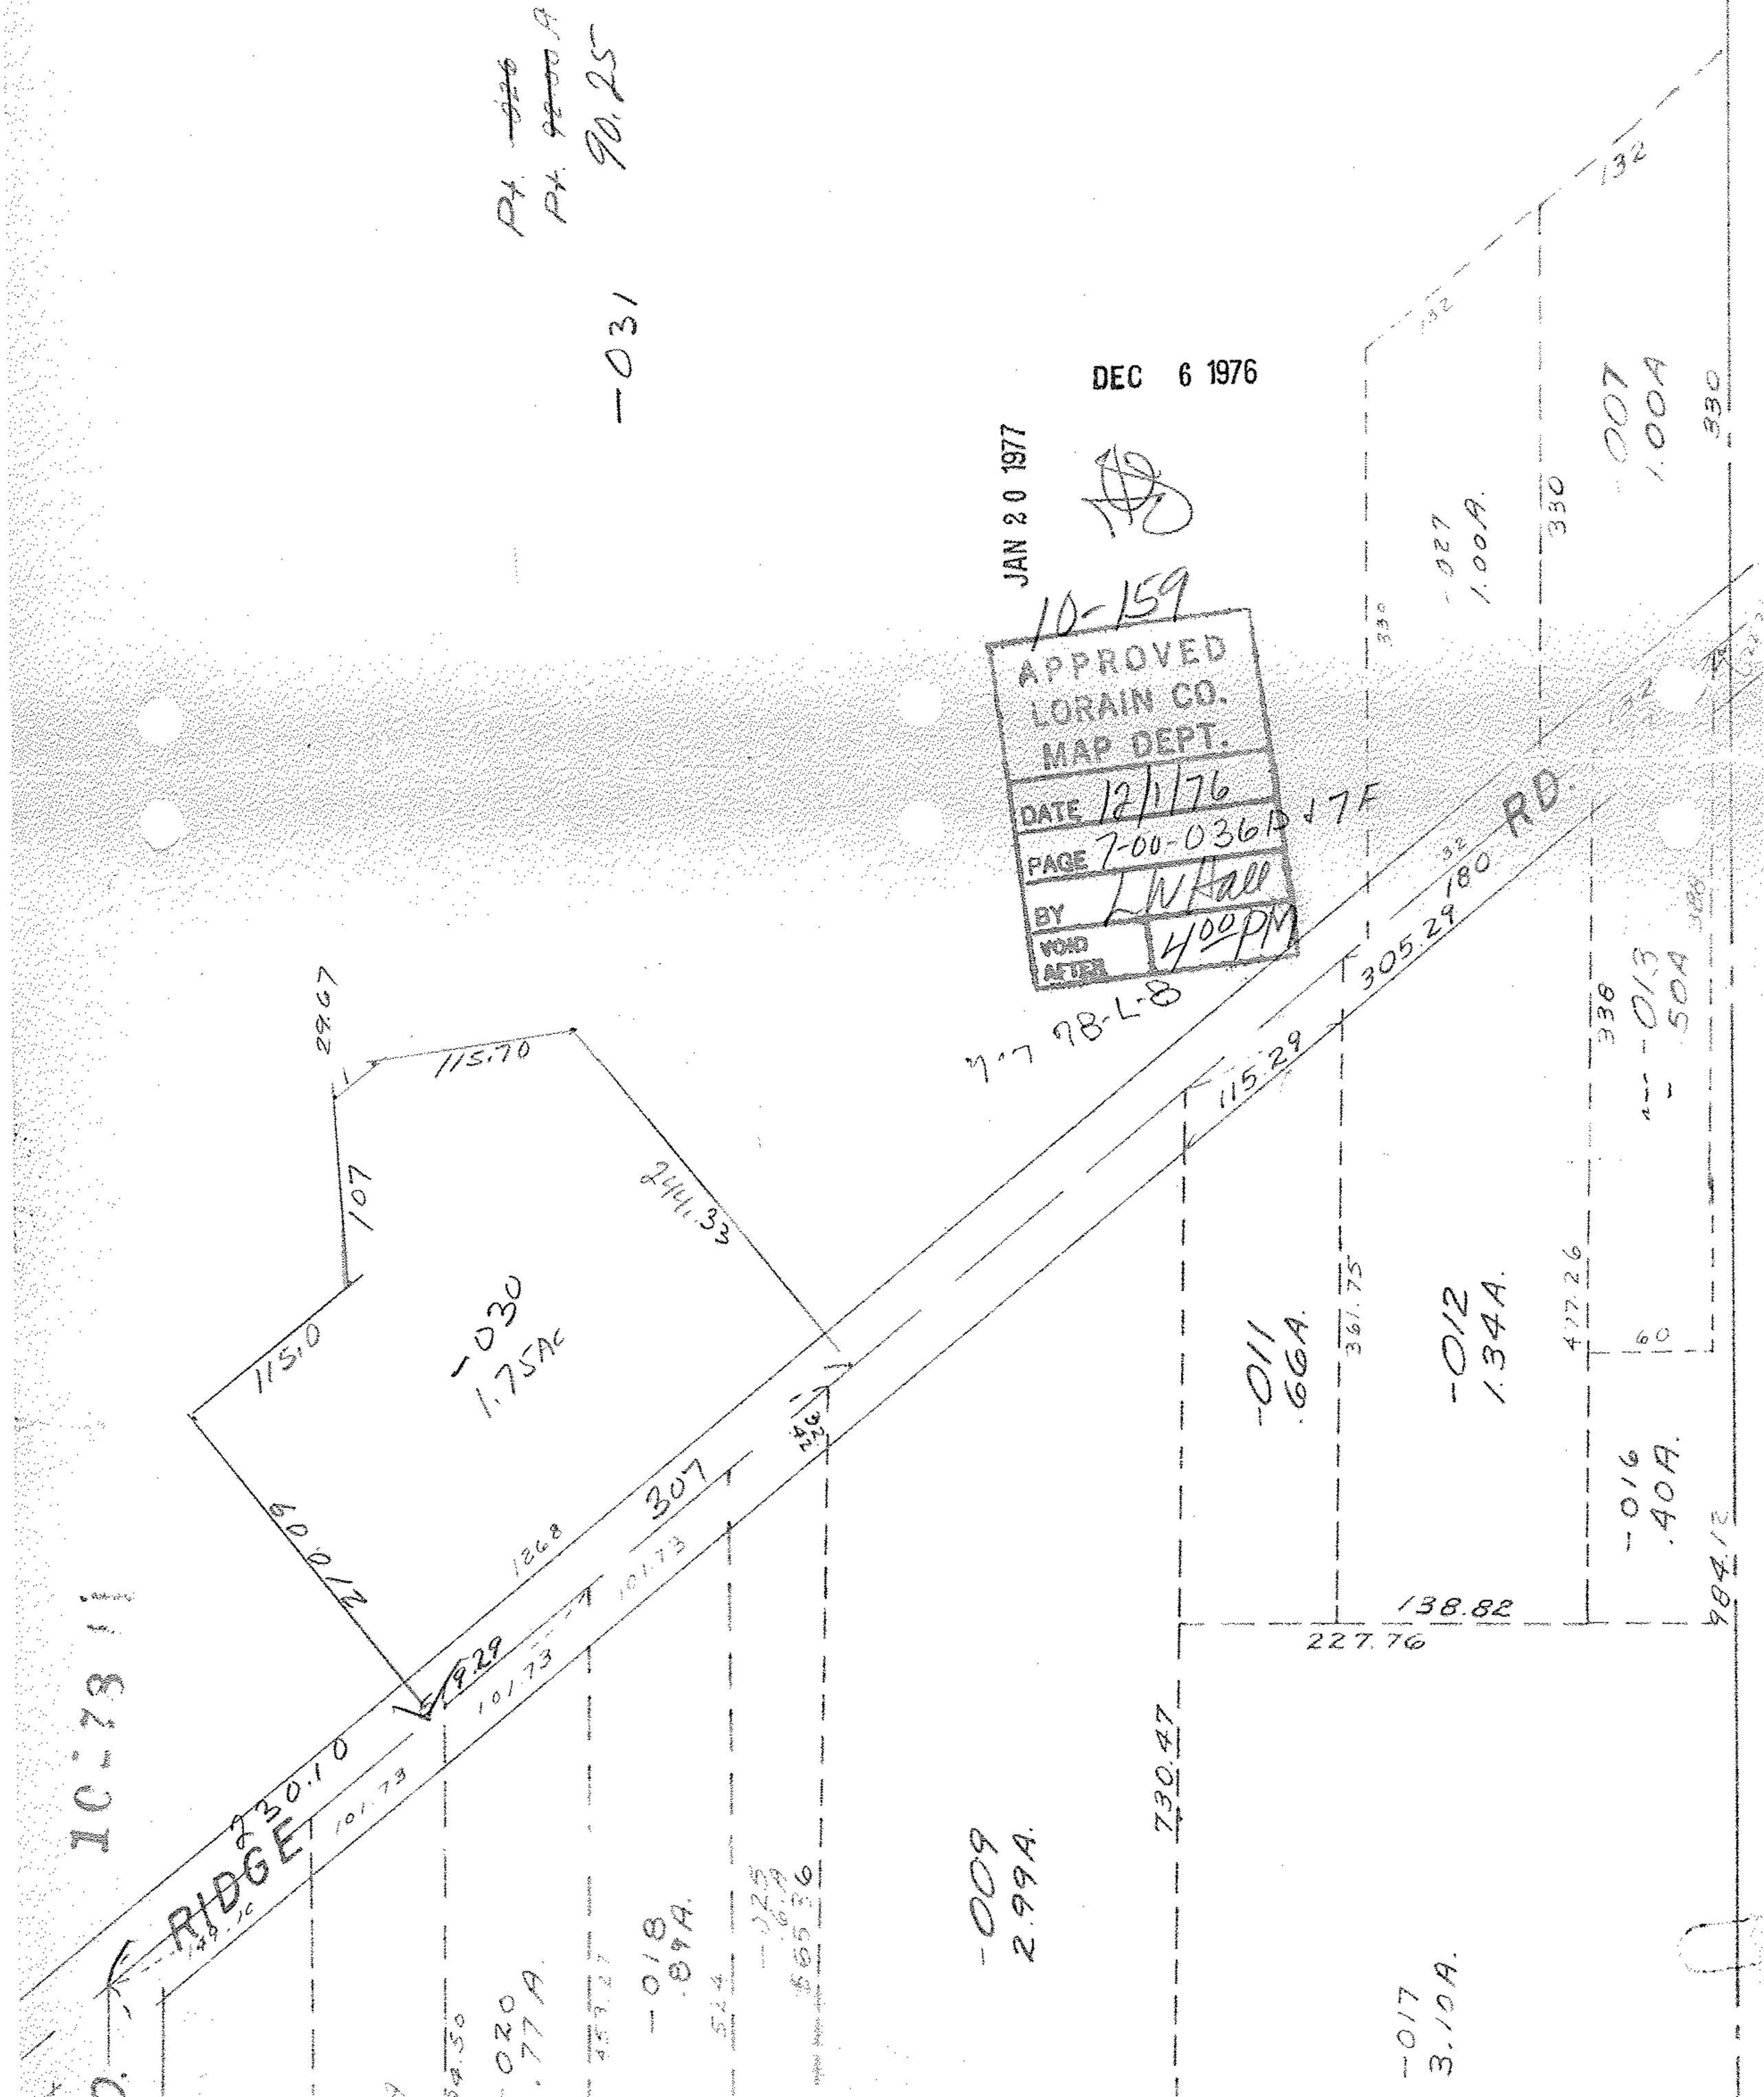
APPROVED
LORAIN CO.
MAP DEPT.
DATE 12/1/76
PAGE 7-00-036D & 7F
BY L W Hall
VOID AFTER 4:00 PM