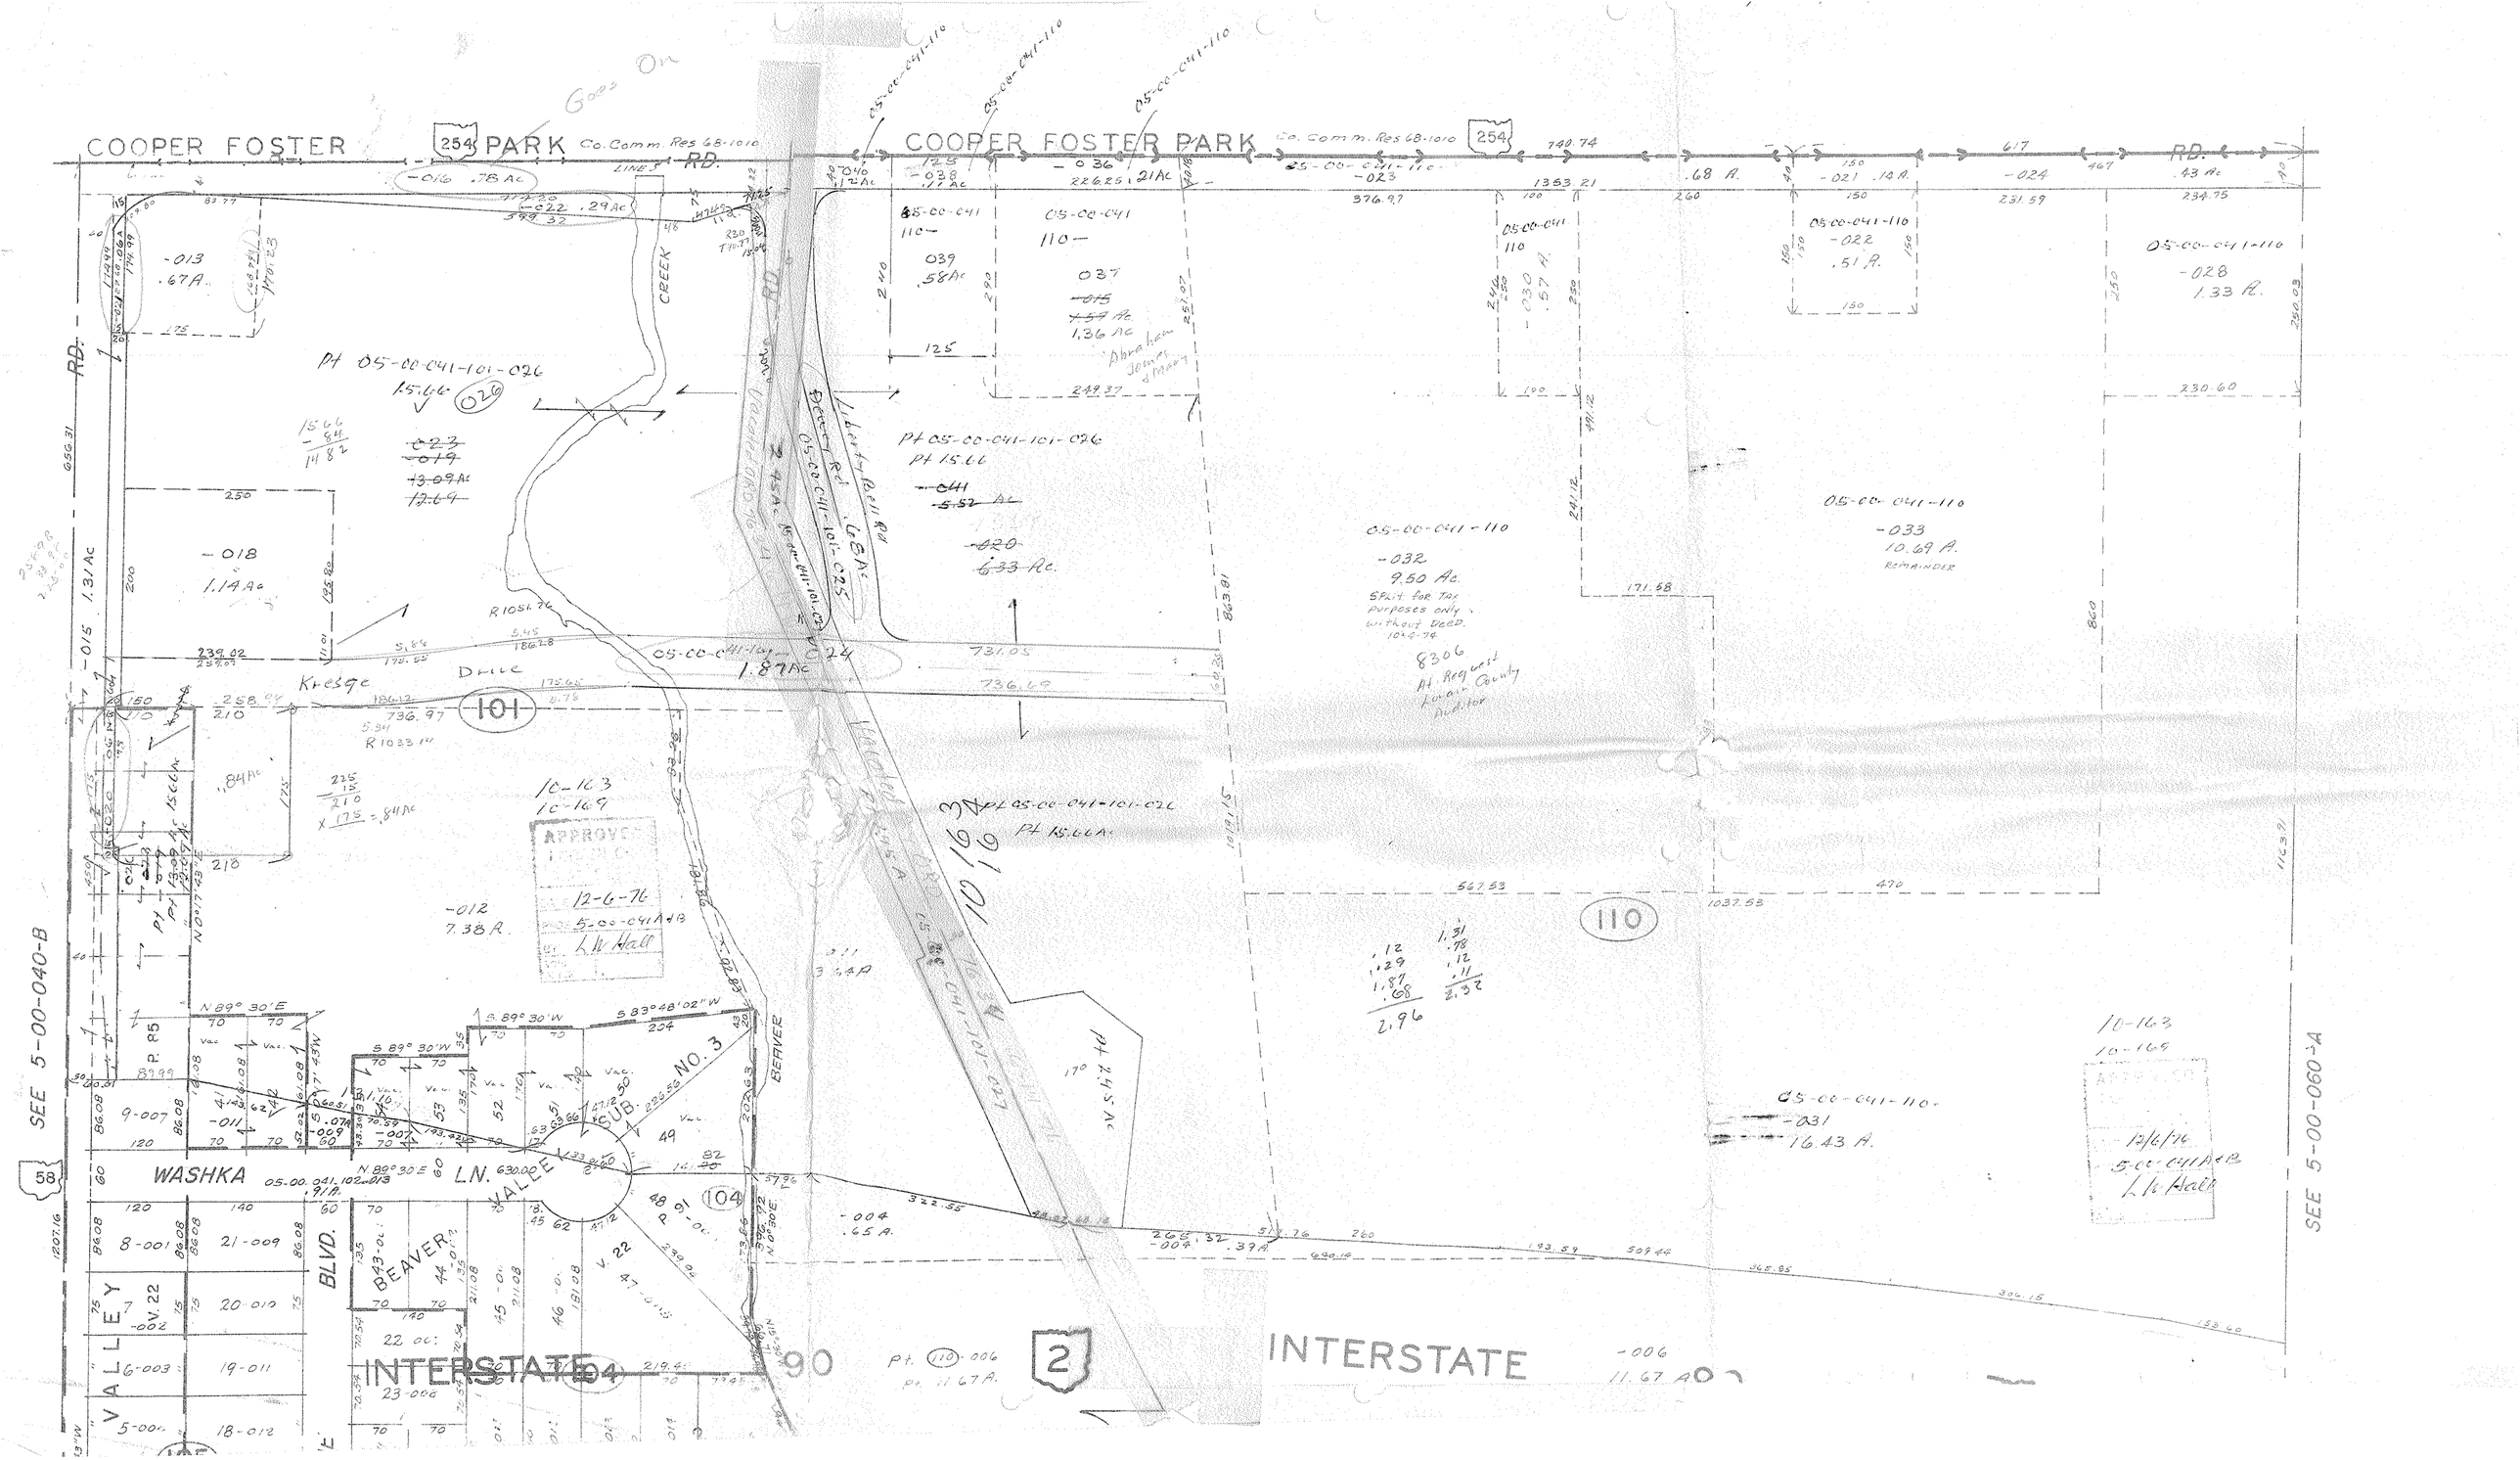
COOPER FOSTER PARK RD.
Co. Comm. Res 68-1010
254
05-00-041-110
05-00-041-101-026
Pt 05-00-041-101-026
15.66
Kresge Drive
101
110
104
WASHKA LN.
VALLEY BLVD.
BEAVER
INTERSTATE 90
INTERSTATE 2
SEE 5-00-040-B
SEE 5-00-060-A
APPROVED
12-6-76
5-00-041 A&B
L.W. Hall