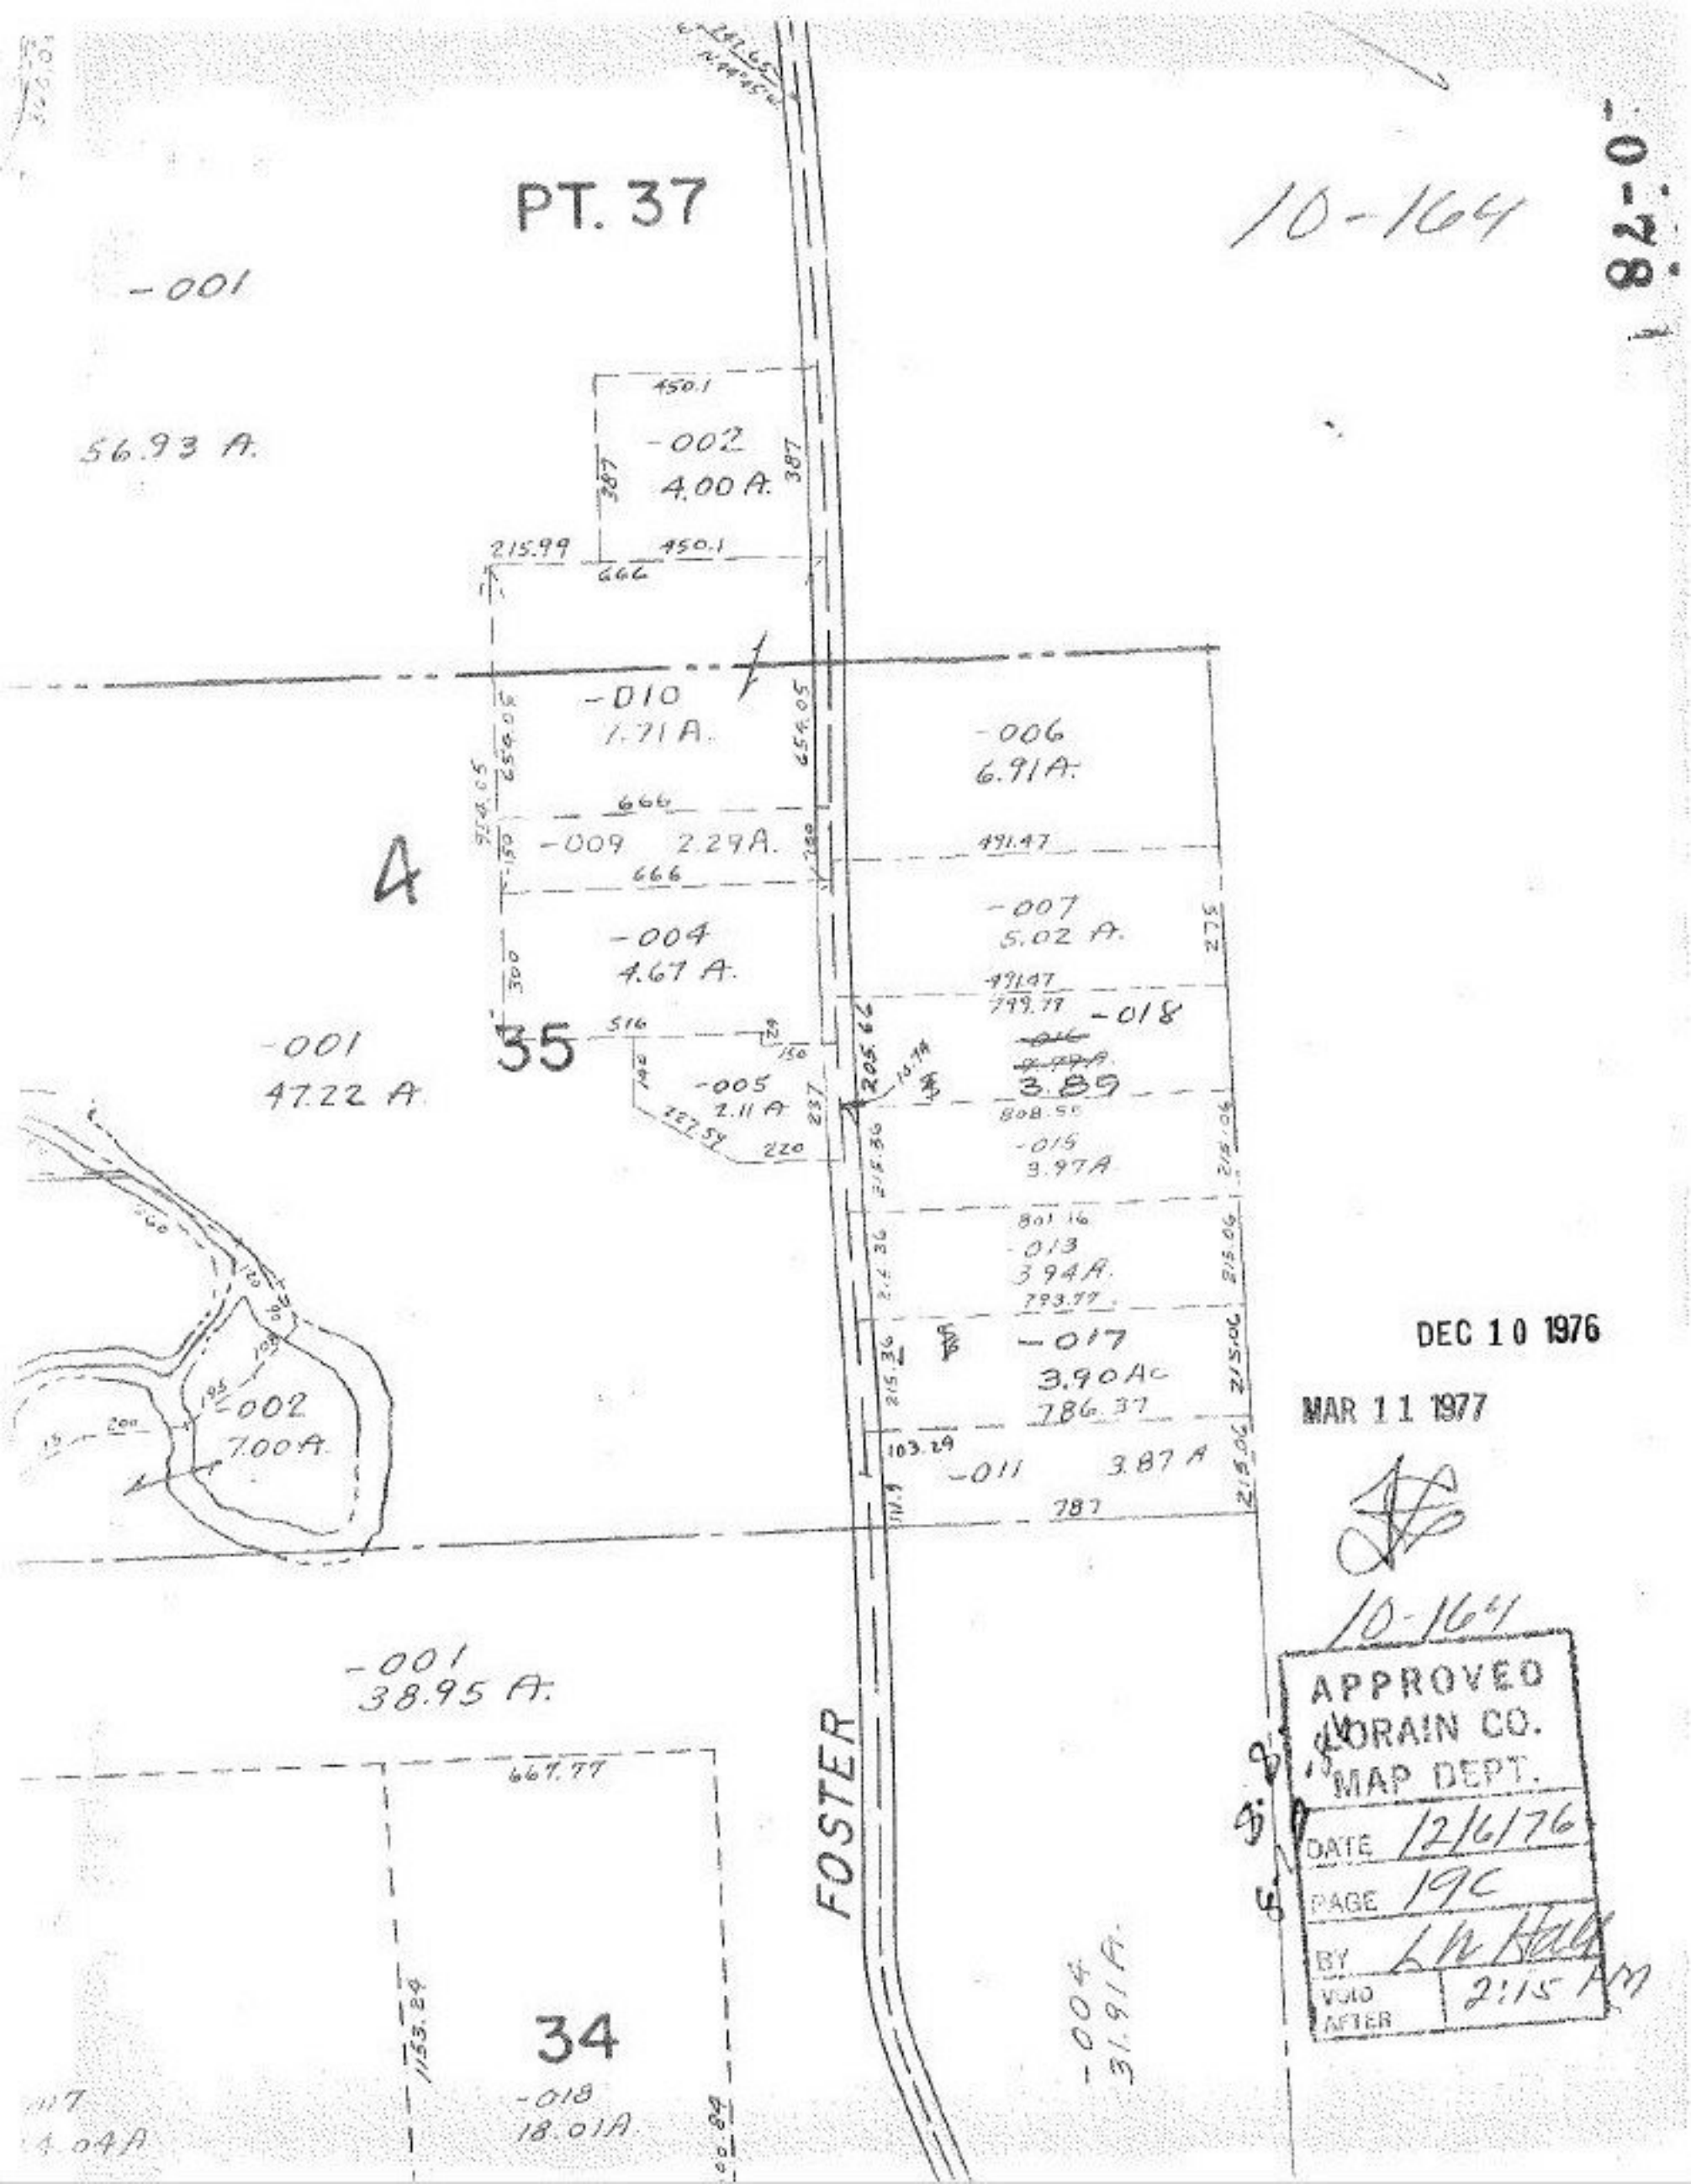
PT. 37
10-164
-001
56.93 A.
-002
4.00 A.
450.1
387
215.99
666
-010
1.71 A.
654.05
-006
6.91 A.
-009 2.29 A.
491.47
A
-007
5.02 A.
-004
4.67 A.
275
-018
3.89
35
-001
47.22 A.
516
-005
2.11 A.
227.59
220
237
205.66
808.55
-015
3.97 A.
801.16
-013
3.94 A.
793.77
-017
3.90 Ac
786.37
-002
7.00 A.
103.29
-011
3.87 A
787
-001
38.95 A.
667.77
FOSTER
34
-018
18.01 A.
1153.24
-004
31.91 A.
DEC 10 1976
MAR 11 1977
10-164
APPROVED
LORAIN CO.
MAP DEPT.
DATE 12/6/76
PAGE 19C
BY L.W. Hall
VOID AFTER 2:15 PM