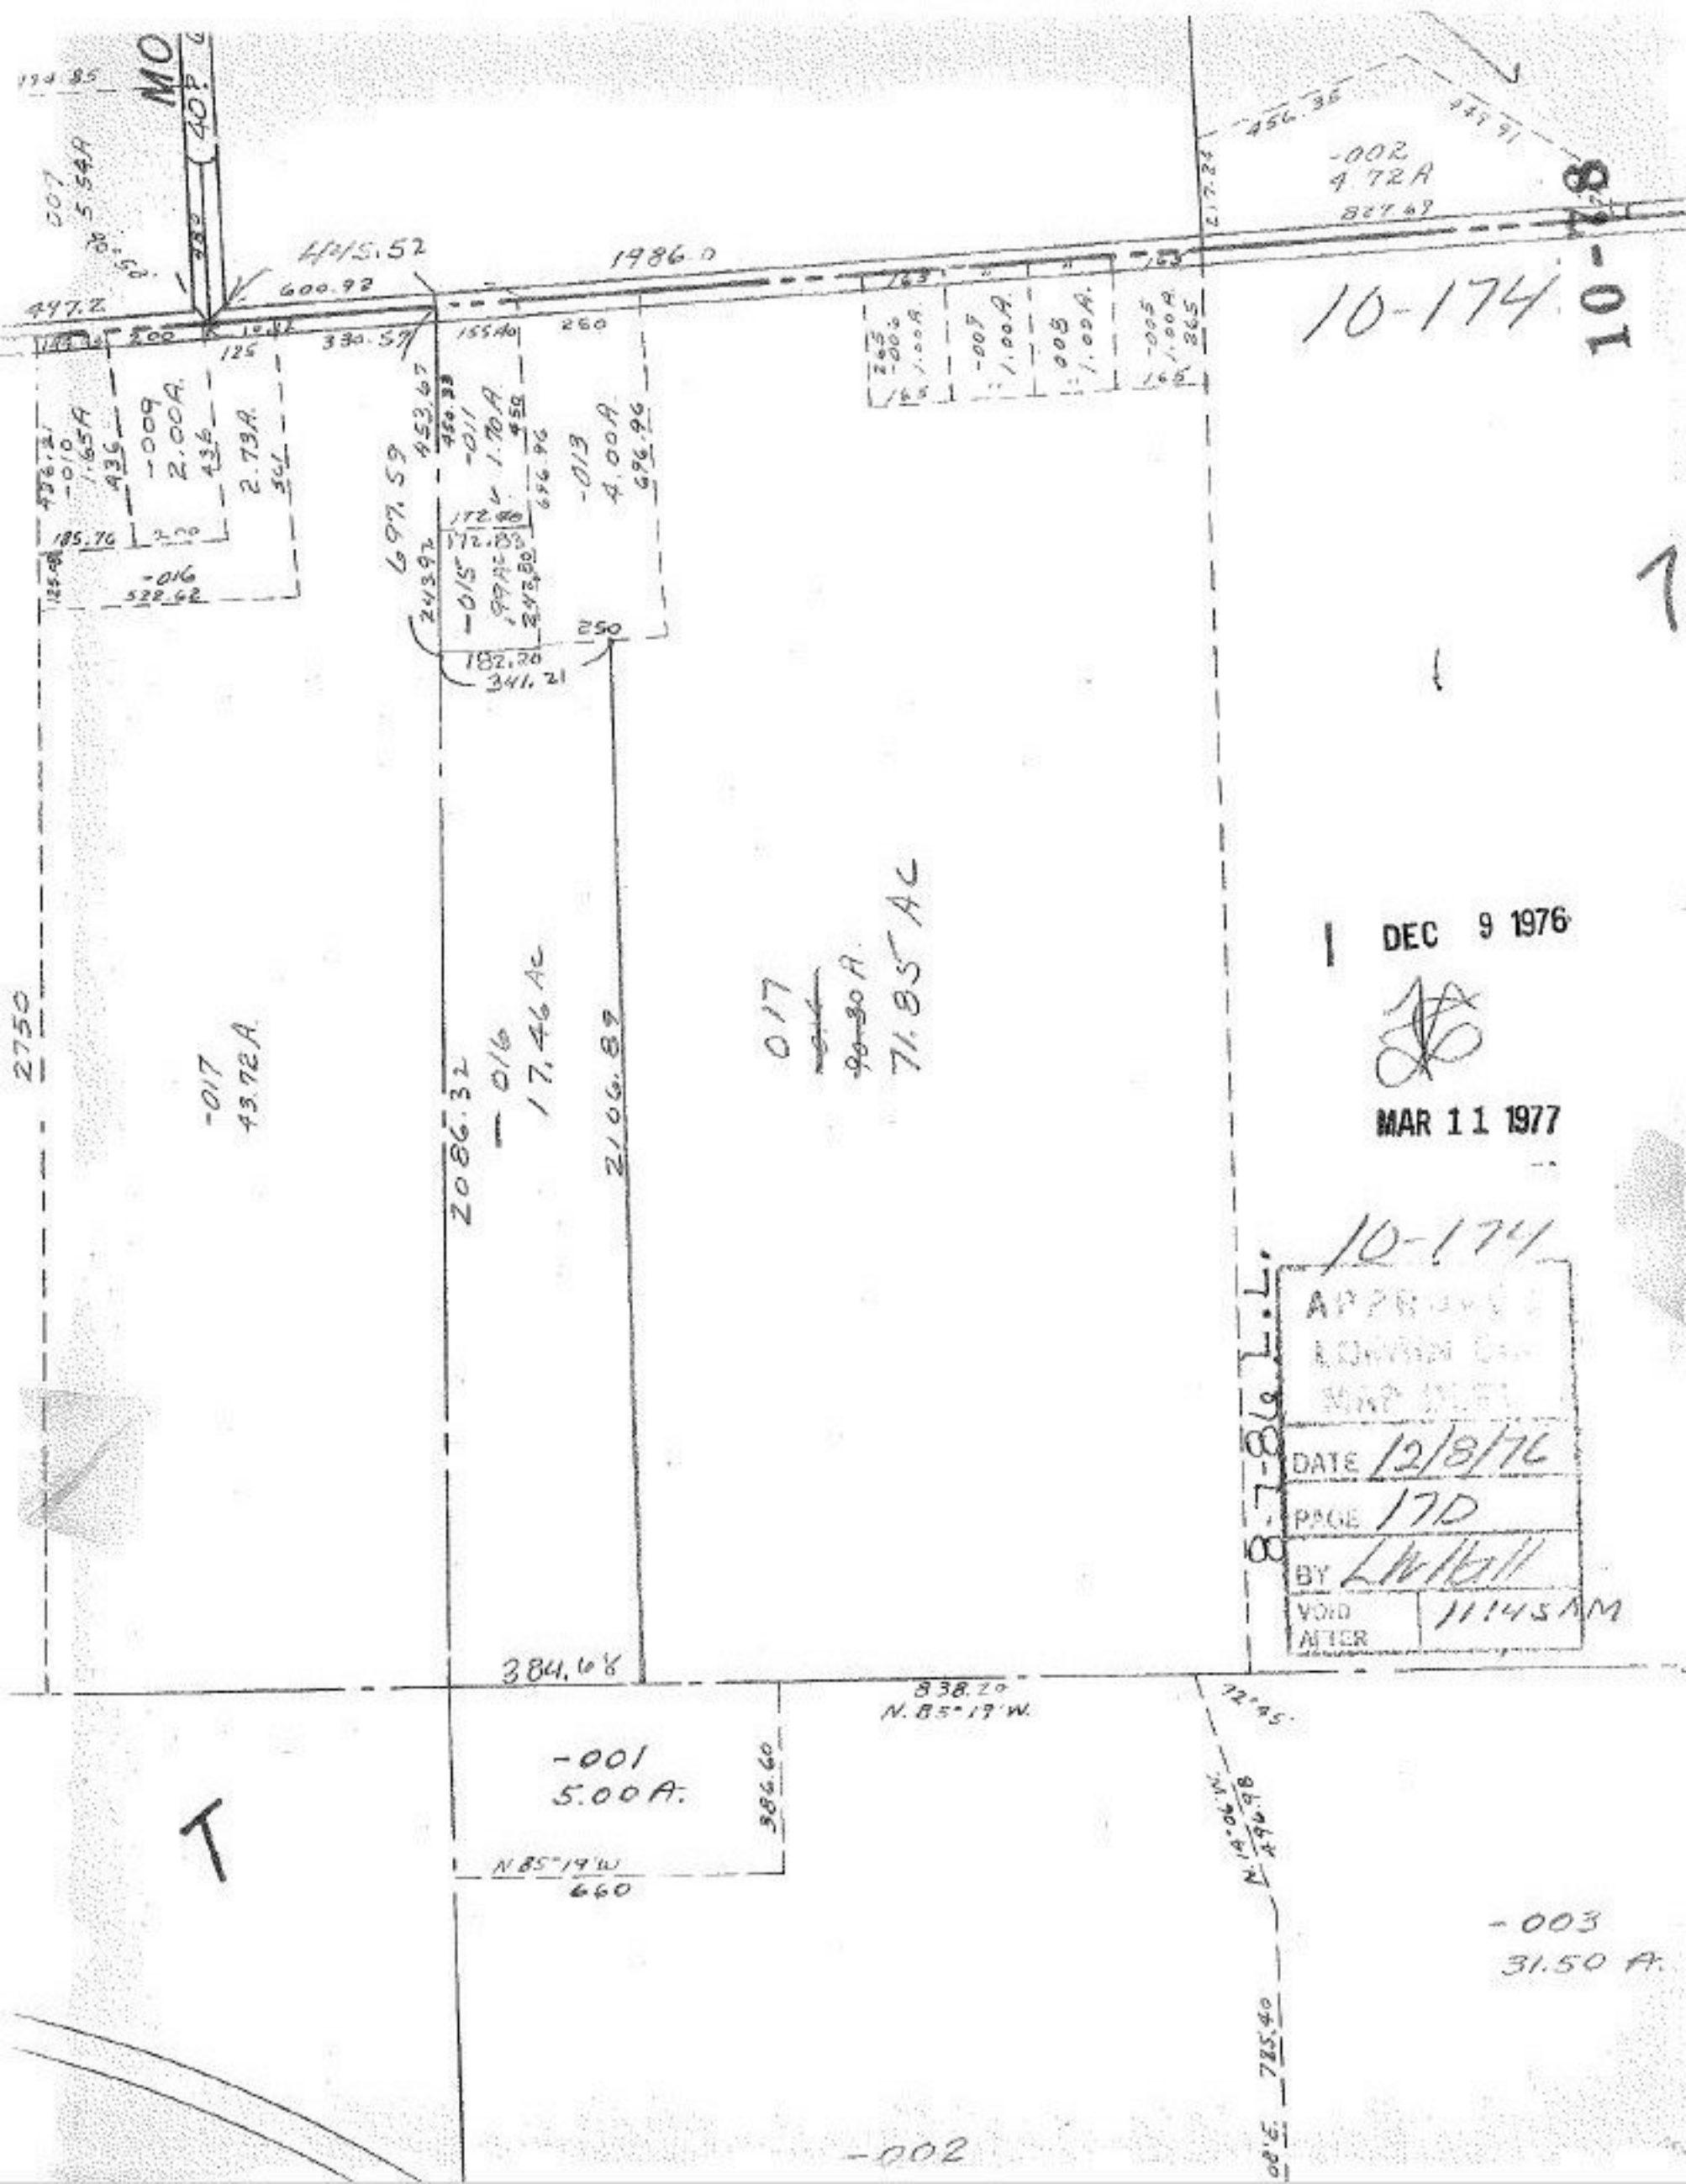

10-174
10-78
DEC 9 1976
MAR 11 1977
10-174
APPROVED
DATE 12/8/76
PAGE 17D
BY LWHall
VOID AFTER 11:45 AM
8-7-86 L.L.
-002
4.72A
827.69
1986.0
445.52
600.92
330.57
-009
2.00A.
2.73A.
-016
522.62
697.59
-011
1.70A.
-013
4.00A.
-015
182.20
341.21
2750
-017
43.72A
2086.32
-016
17.46 Ac
2106.89
017
71.85 AC
384.68
838.20
N.85°19'W.
-001
5.00A.
386.60
N85°19'W
660
-003
31.50 A.
785.40
-002