10-78

10-177

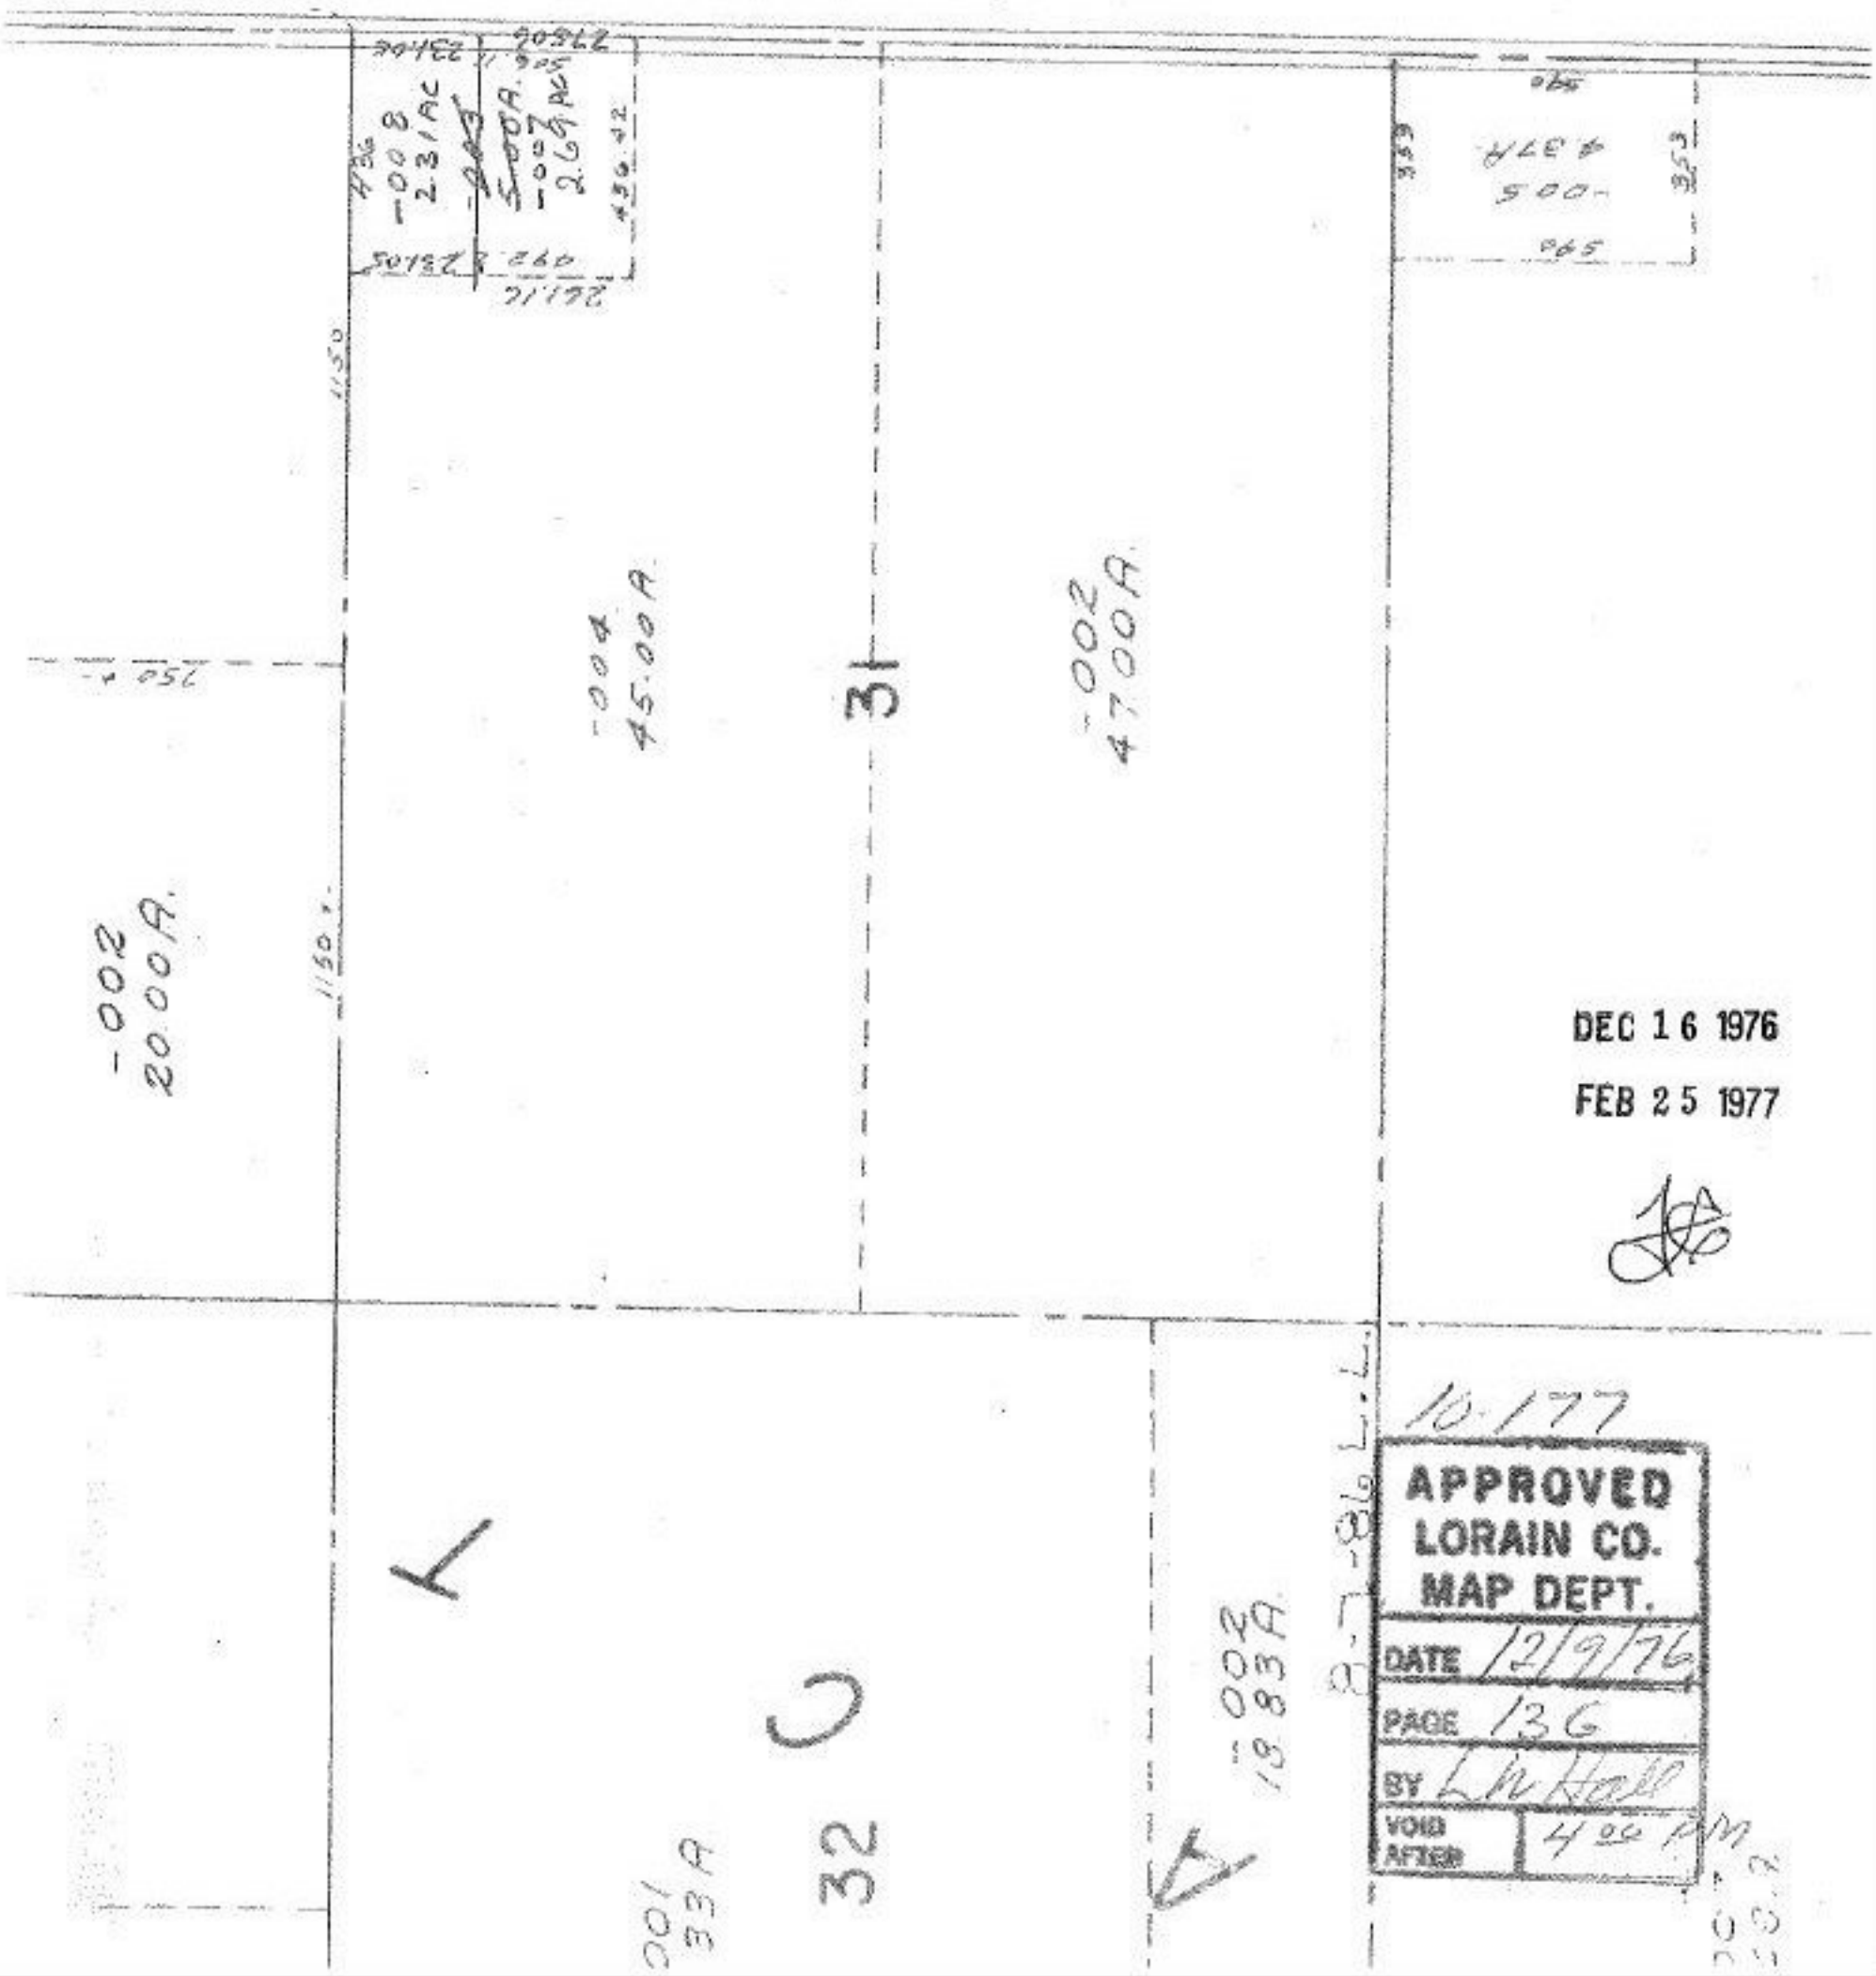

DEC 16 1976

FEB 25 1977

10-177

APPROVED
LORAIN CO.
MAP DEPT.

DATE 12/9/76

PAGE 136

BY L.H. Hall

VOID AFTER 4:00 PM