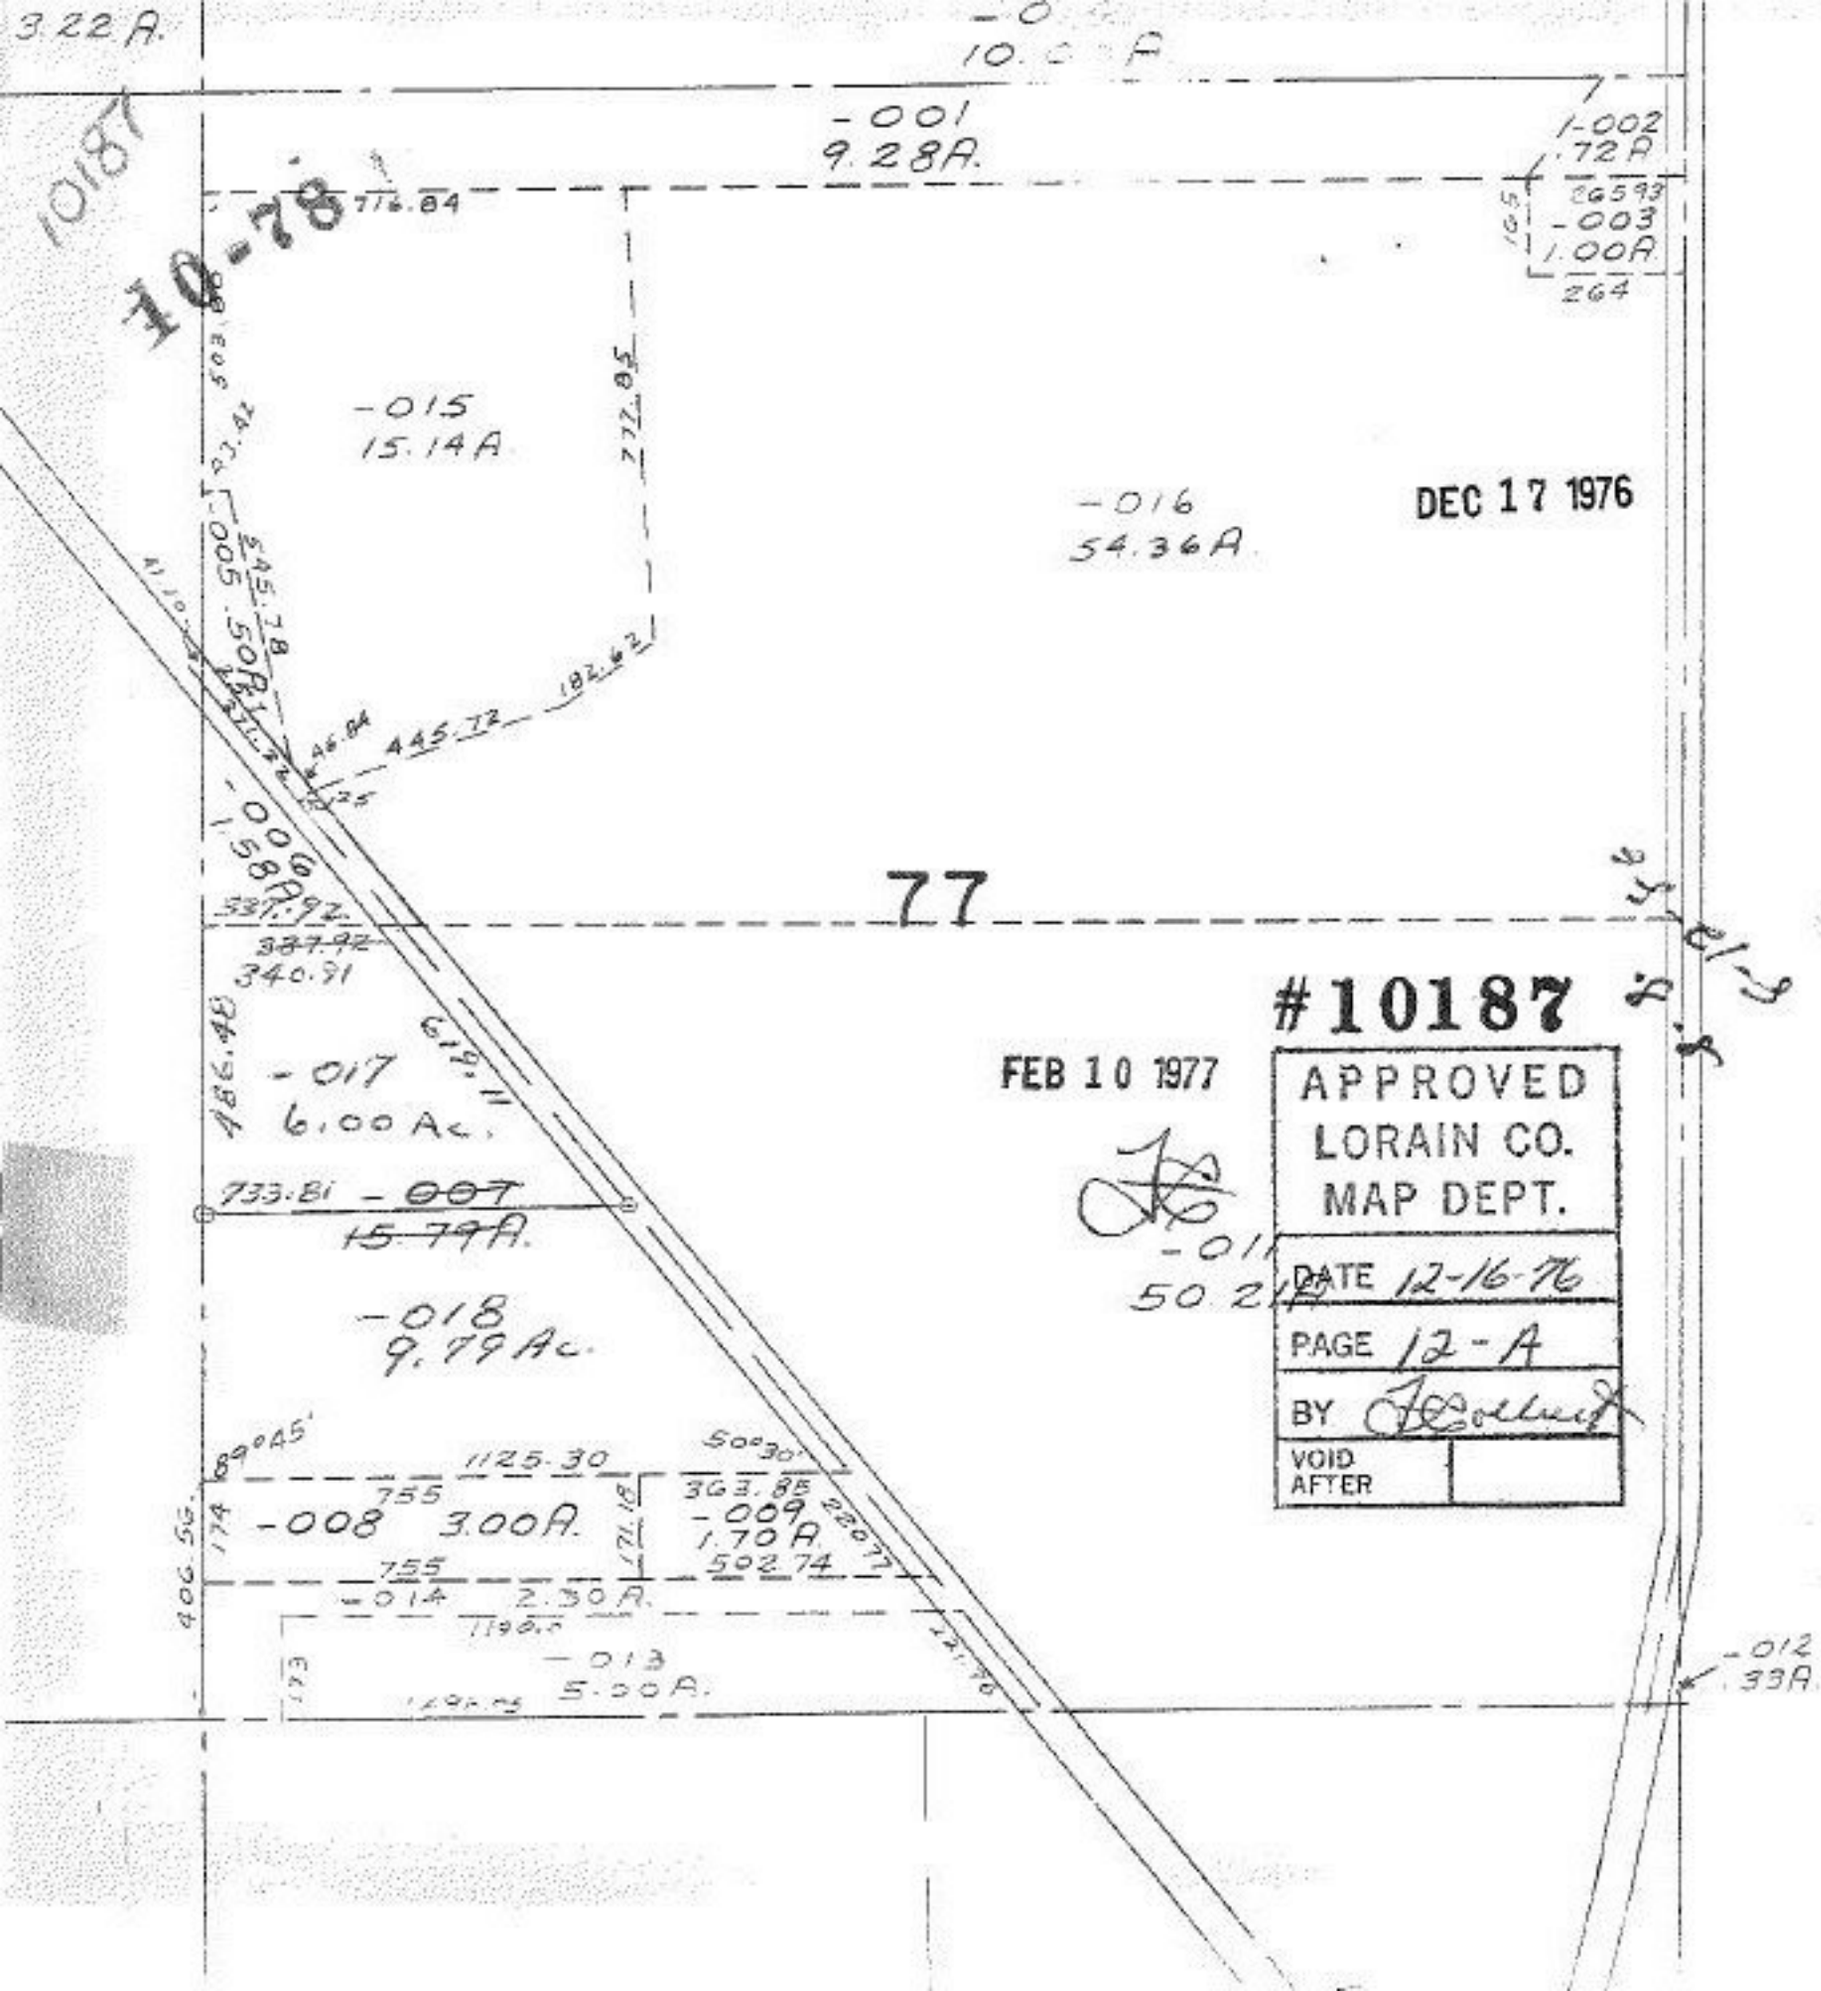

#10187

FEB 10 1977

APPROVED
LORAIN CO.
MAP DEPT.

DATE 12-16-76

PAGE 12-A

BY [signature]

VOID AFTER