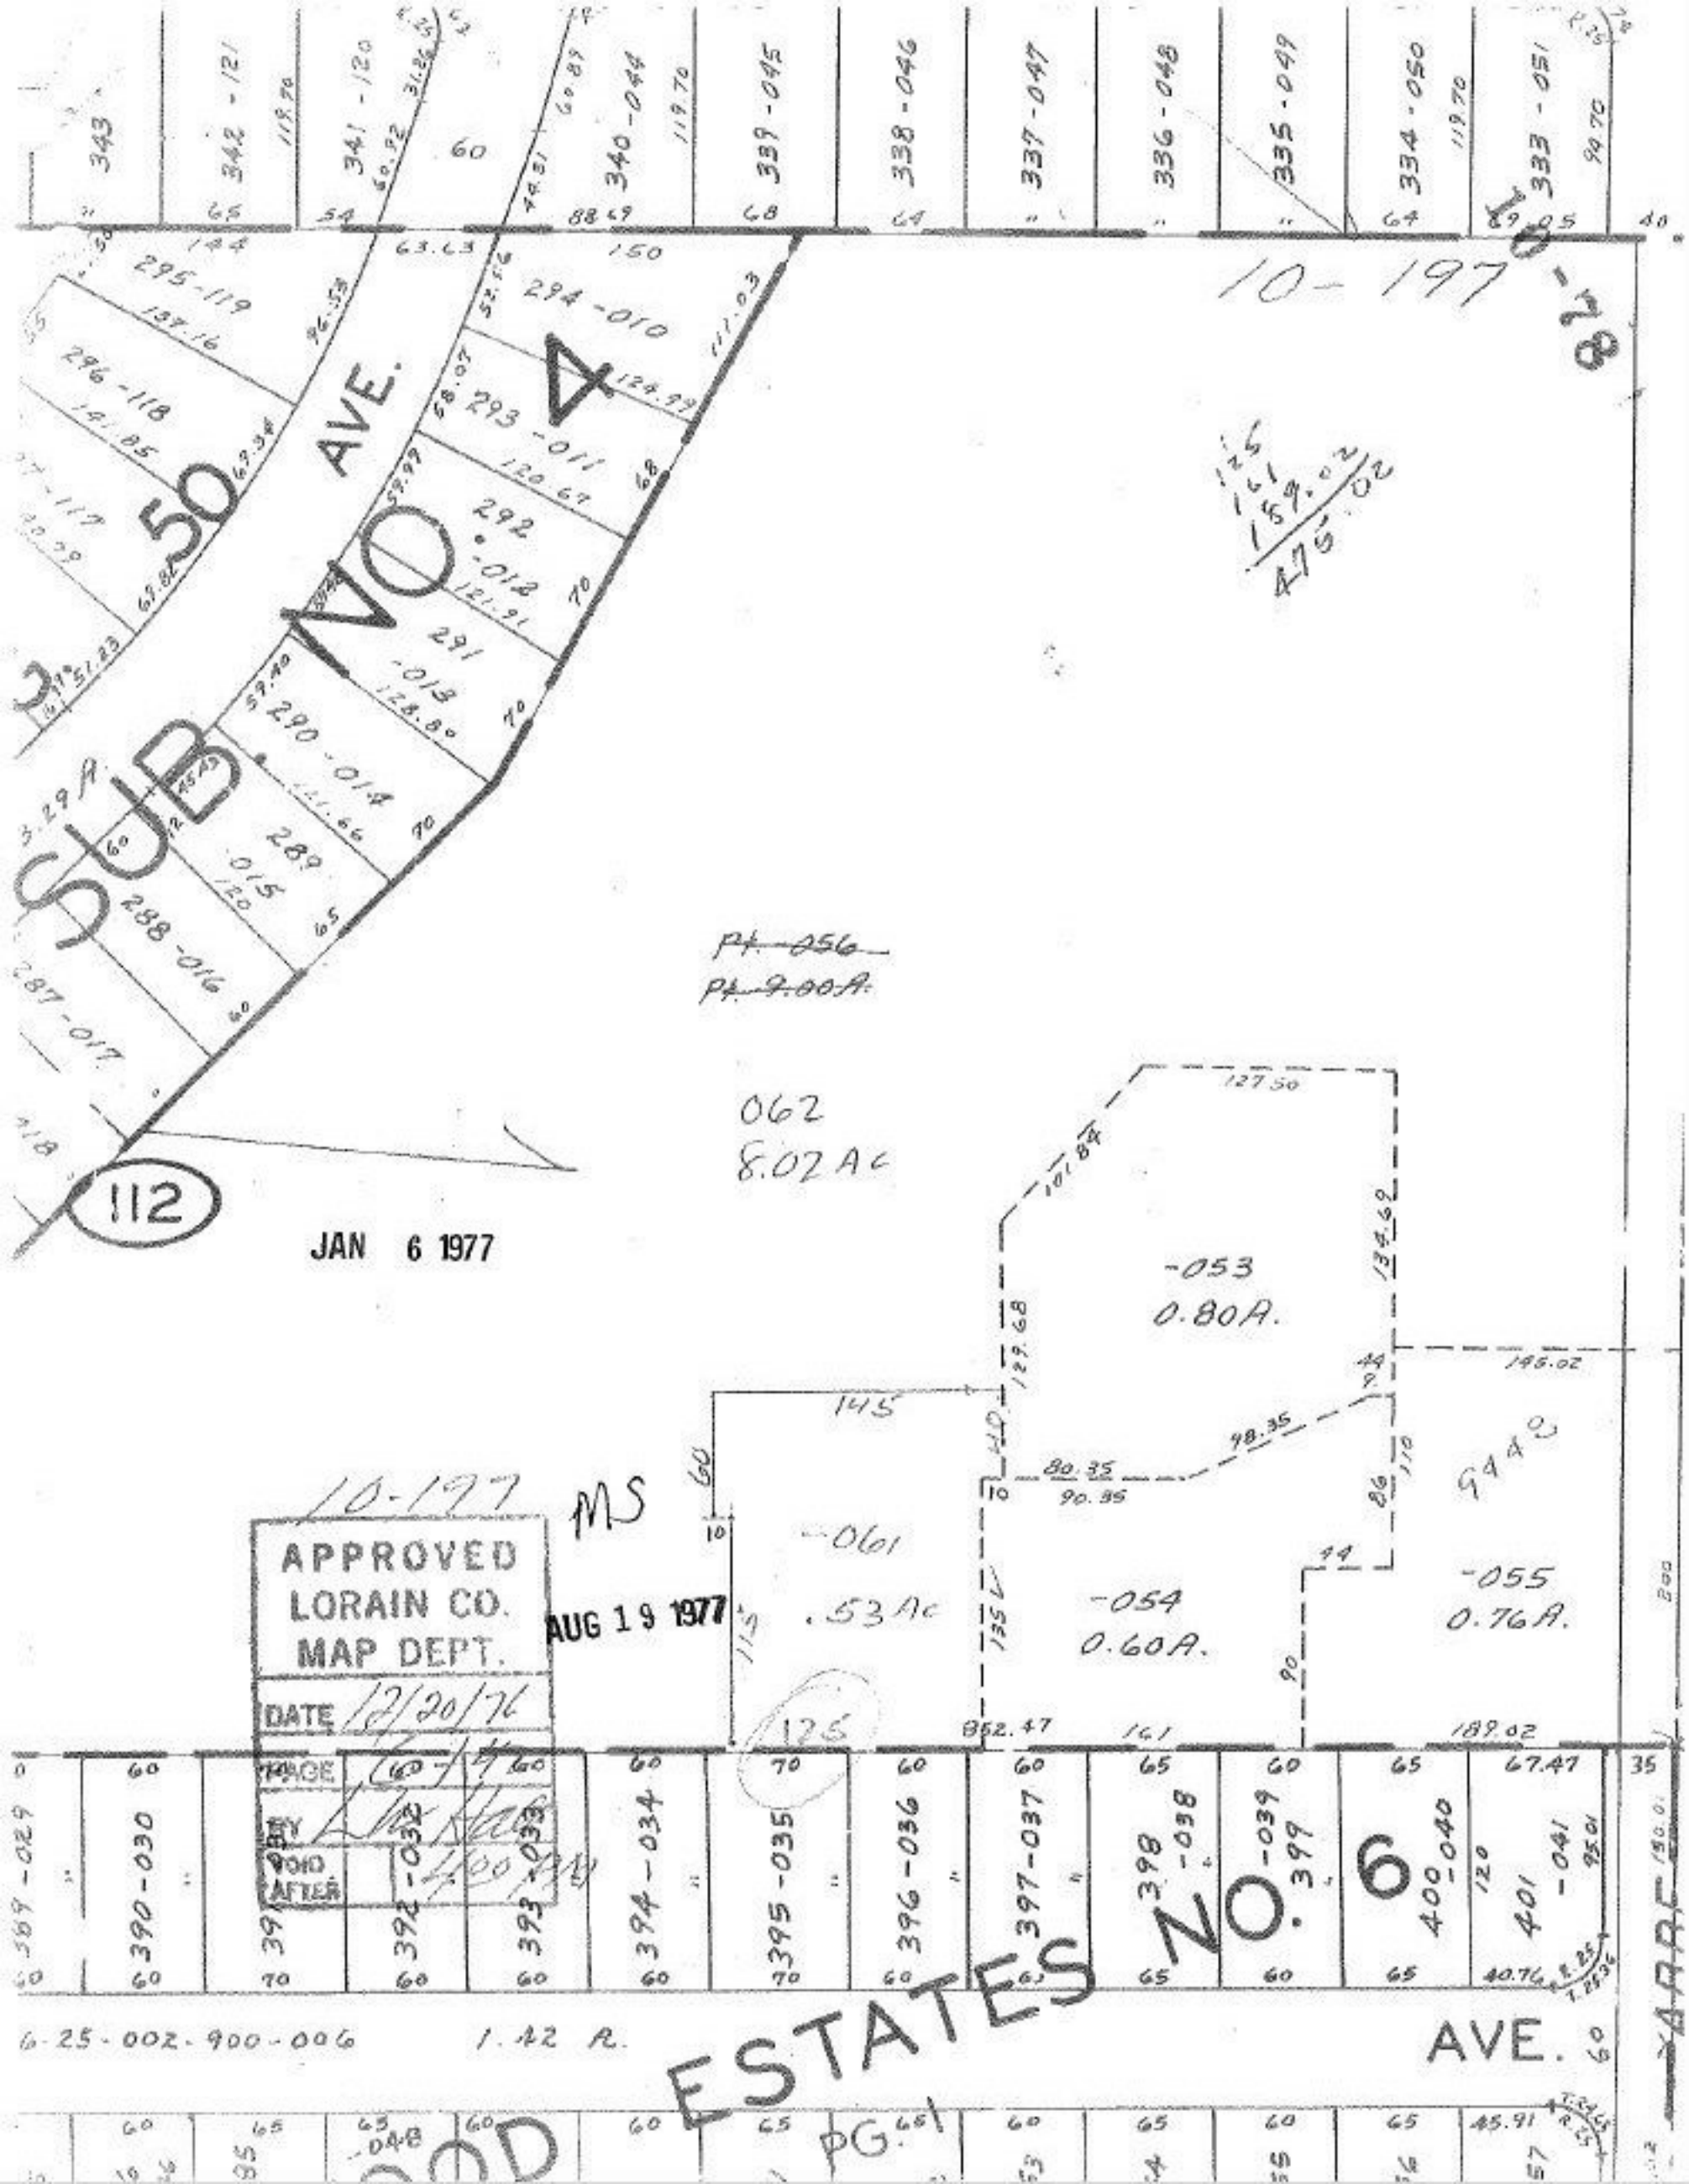

10-197
10-78
SUB NO. 4
AVE.
50
3.29 A.
112
JAN 6 1977
Pt. 056
Pt. 9.00 A.
062
8.02 Ac
-053
0.80 A.
-061
.53 Ac
-054
0.60 A.
-055
0.76 A.
10-197
MS
AUG 19 1977
APPROVED
LORAIN CO.
MAP DEPT.
DATE 12/20/76
PAGE
BY
VOID AFTER
6-25-002-900-006
1.42 A.
ESTATES NO. 6
AVE.
PG. 1