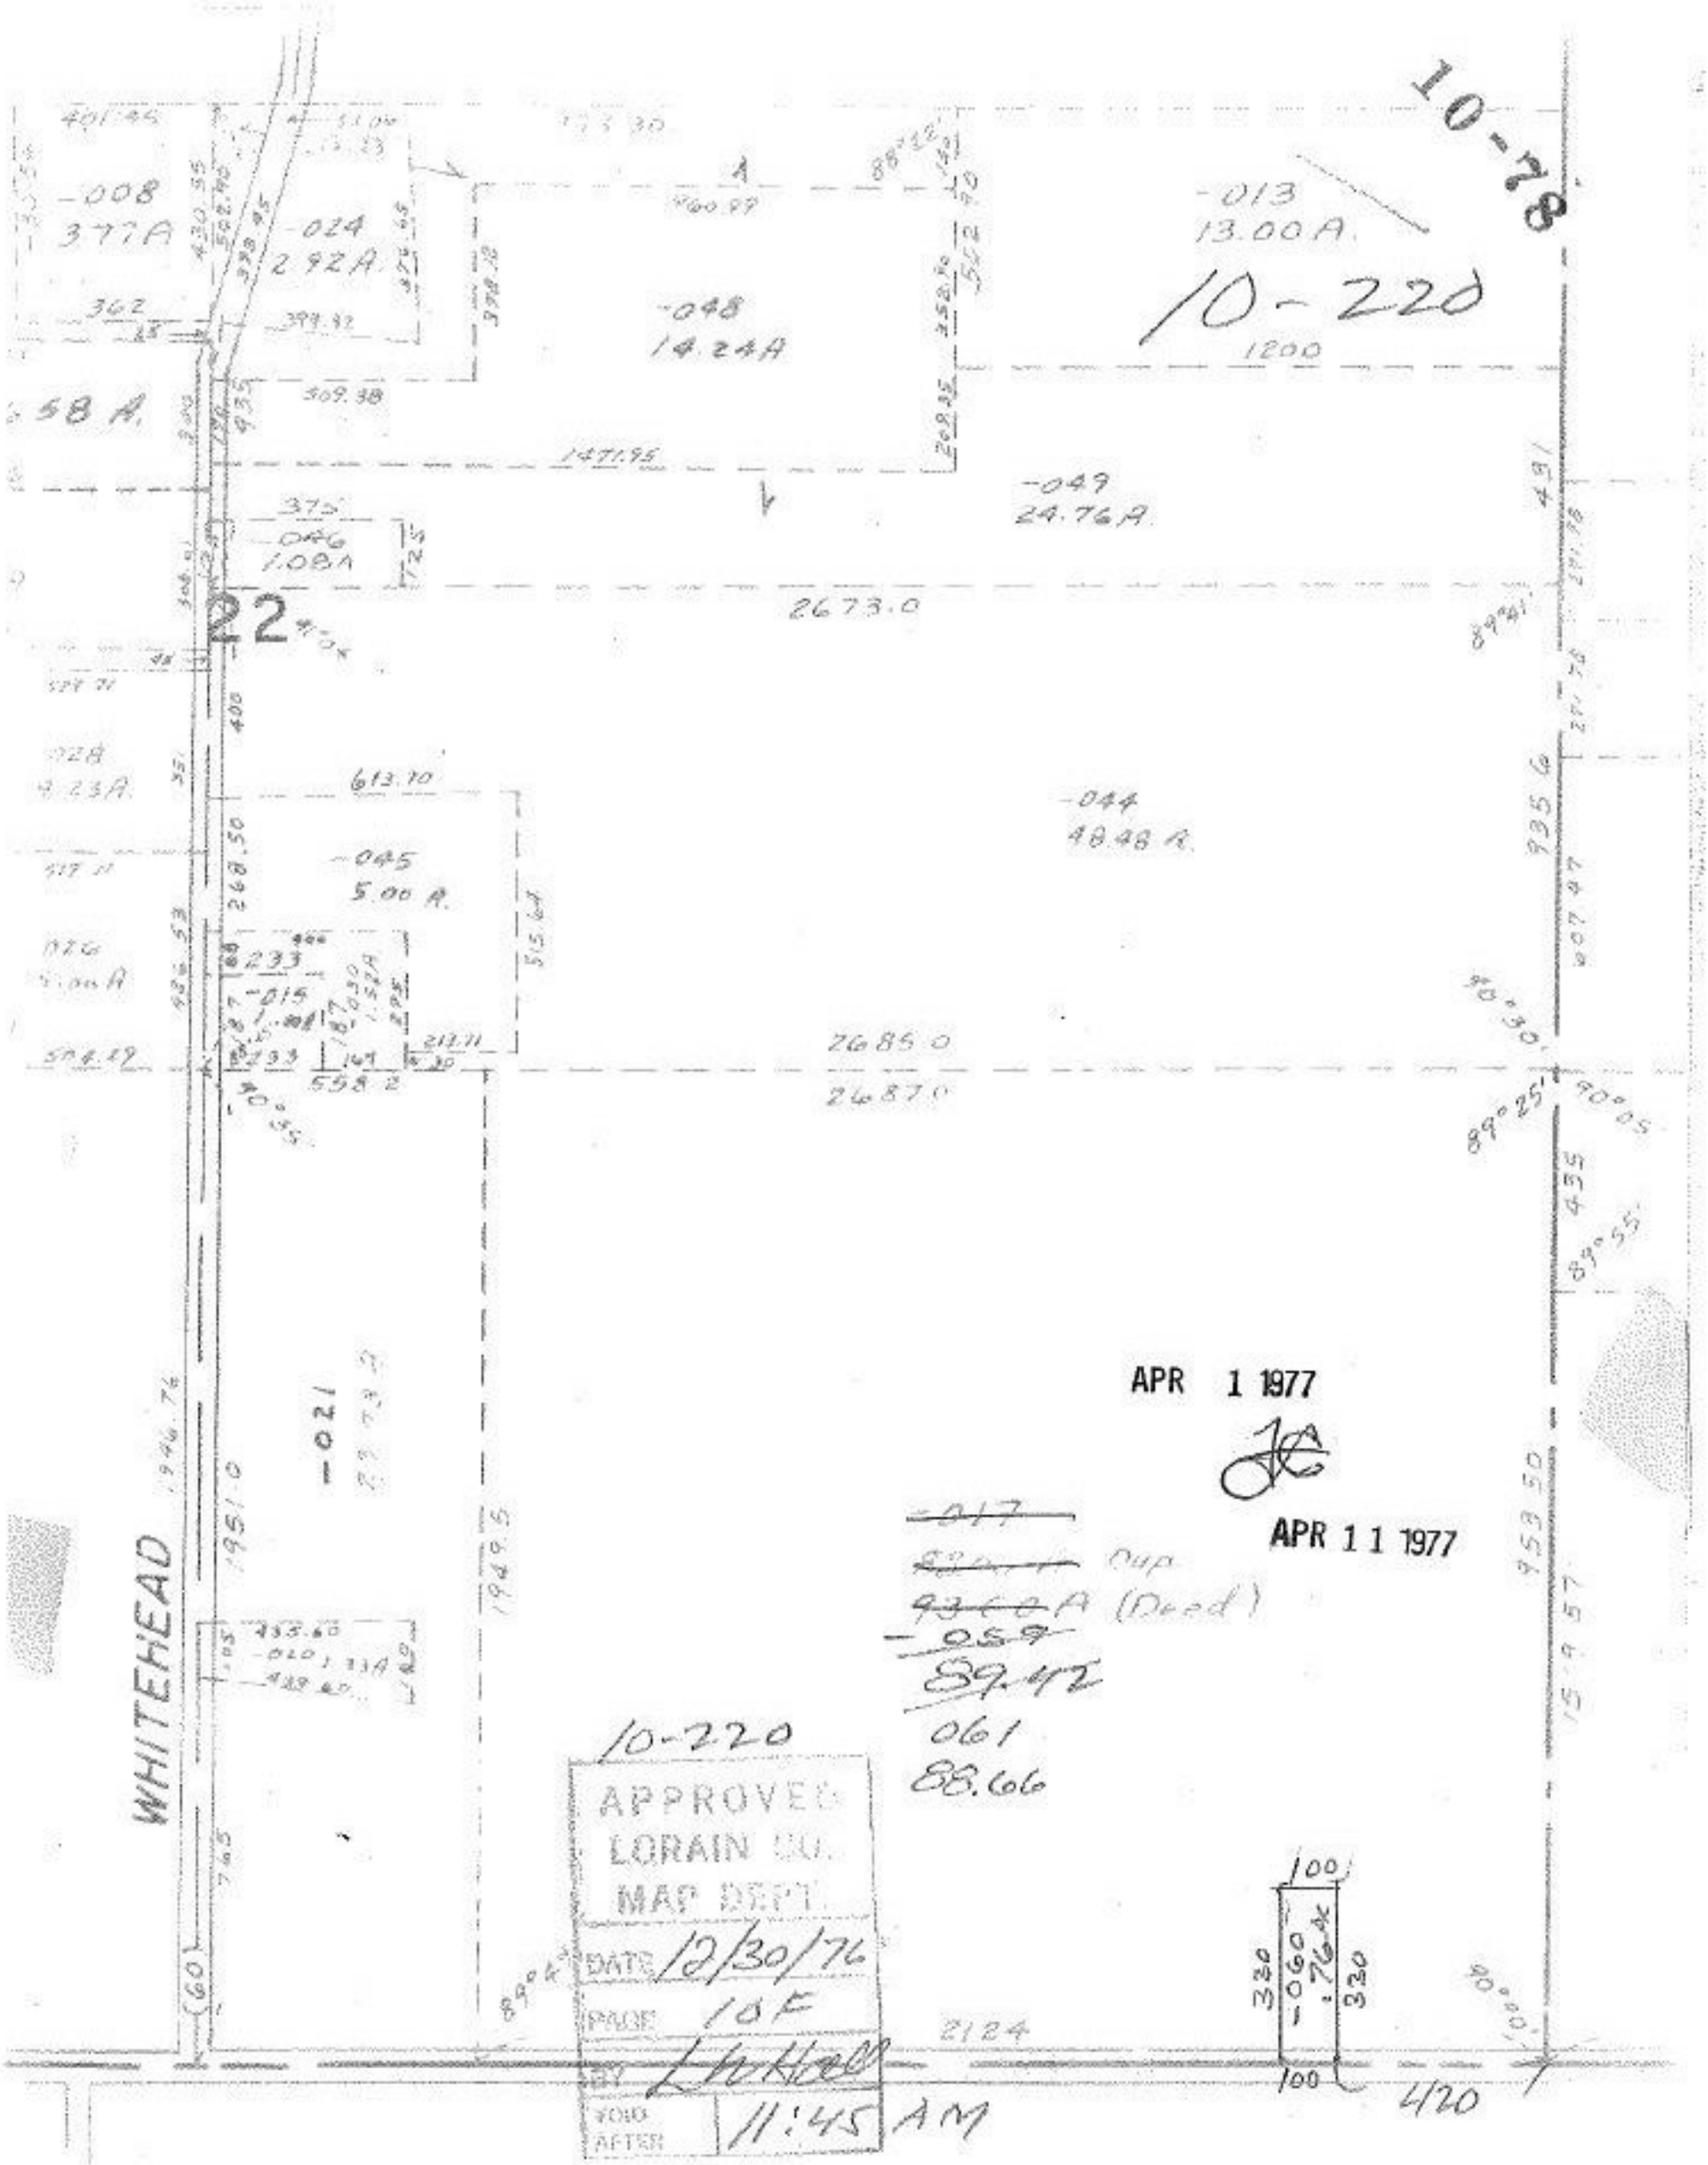
10-78
10-220
-008
377A
-024
2.92A
-048
14.24A
-013
13.00A
1200
-049
24.76A
-046
1.08A
22
2673.0
-044
48.48A
-045
5.00A
2685.0
2687.0
-021
WHITEHEAD
APR 1 1977
APR 11 1977
-017
Cup
A (Deed)
-059
89.42
061
88.66
10-220
APPROVED
LORAIN CO.
MAP DEPT.
DATE 12/30/76
PAGE 10F
BY
VOID AFTER 11:45 AM
2124
420