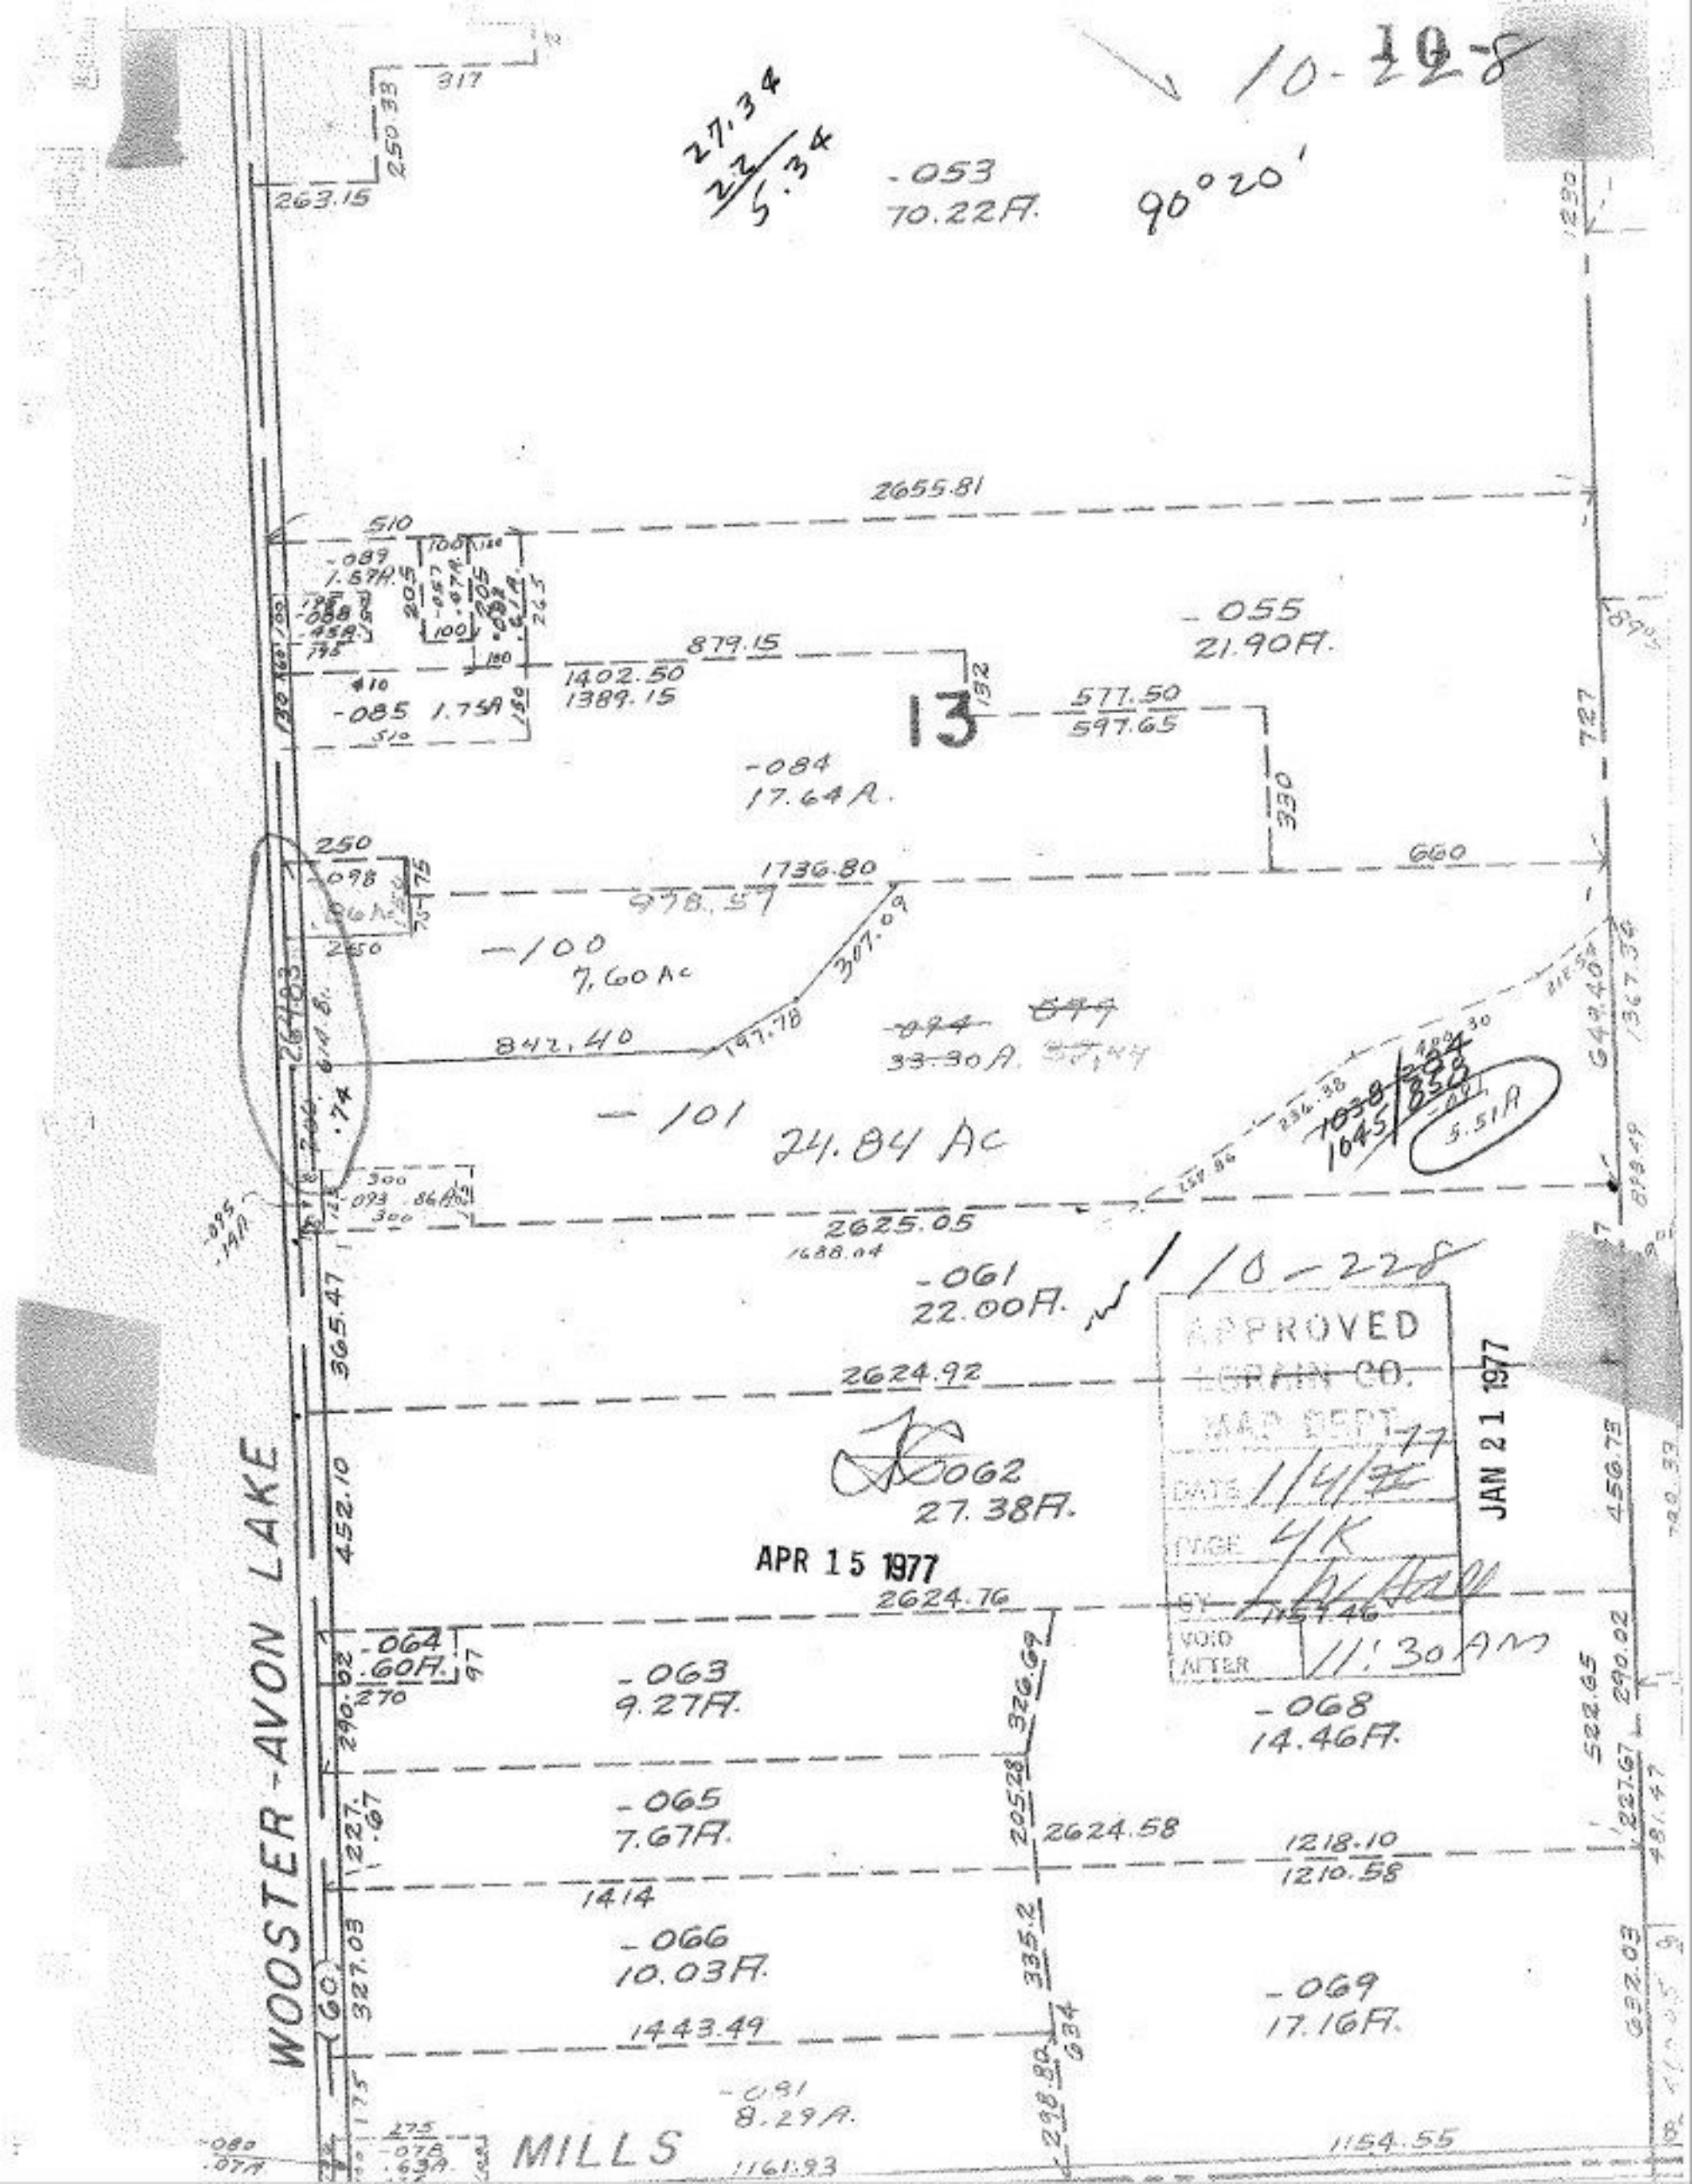
10-228
27.34
22
5.34
-053
70.22A.
90°20'
2655.81
-055
21.90A.
879.15
1402.50
1389.15
-085 1.75A
13
577.50
597.65
-084
17.64A.
330
660
1736.80
978.57
-100
7.60Ac
307.09
842.40
197.78
33.30A.
-101
24.84 Ac
5.51A
2625.05
1688.04
-061
22.00A.
10-228
APPROVED
LORAIN CO.
MAP DEPT.
DATE 1/4/77
PAGE 4K
BY
VOID AFTER 11:30 AM
JAN 21 1977
2624.92
-062
27.38A.
APR 15 1977
2624.76
-064
.60A.
-063
9.27A.
-068
14.46A.
-065
7.67A.
2624.58
1218.10
1210.58
1414
-066
10.03A.
-069
17.16A.
1443.49
-081
8.29A.
1154.55
1161.93
WOOSTER-AVON LAKE
MILLS