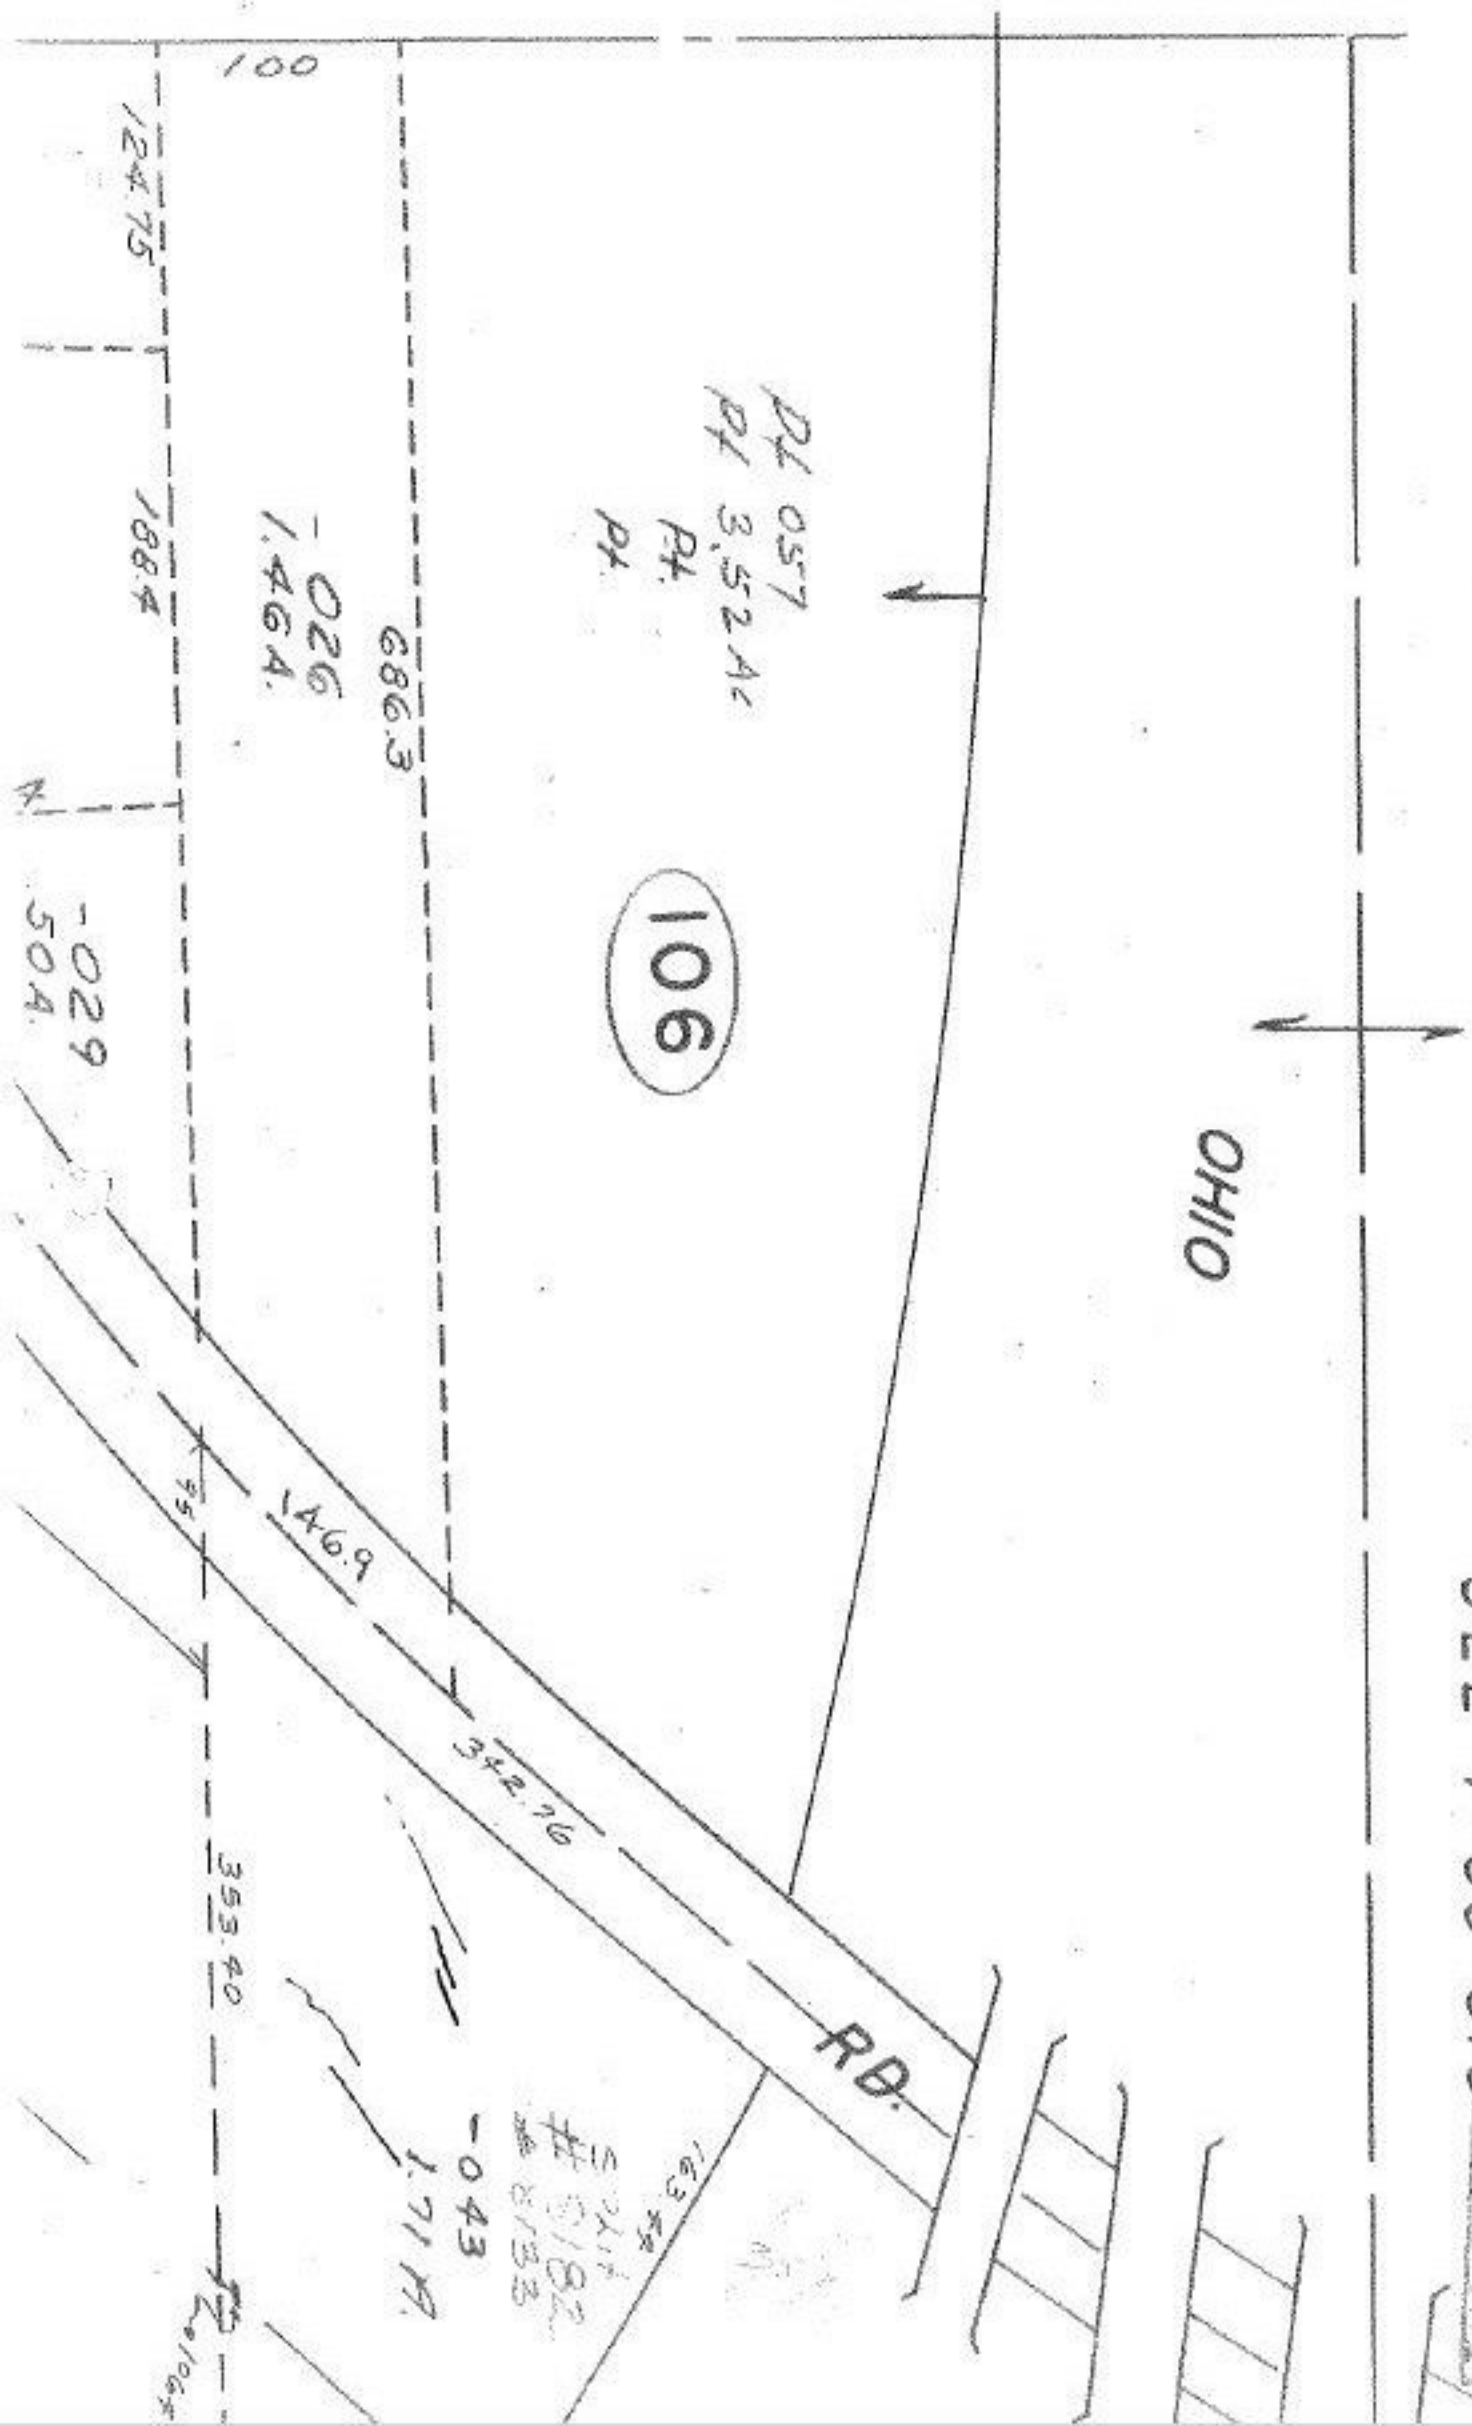


SEE 7-00-010-A

JAN 6 1977

JAN 20 1977

~~JAN 20 1976~~

10-229

APPROVED
LORAIN CO.
MAP DEPT.
DATE 1/4/77
PAGE 7-00-010C
BY L.H. Hall
VOID
METER 12.00