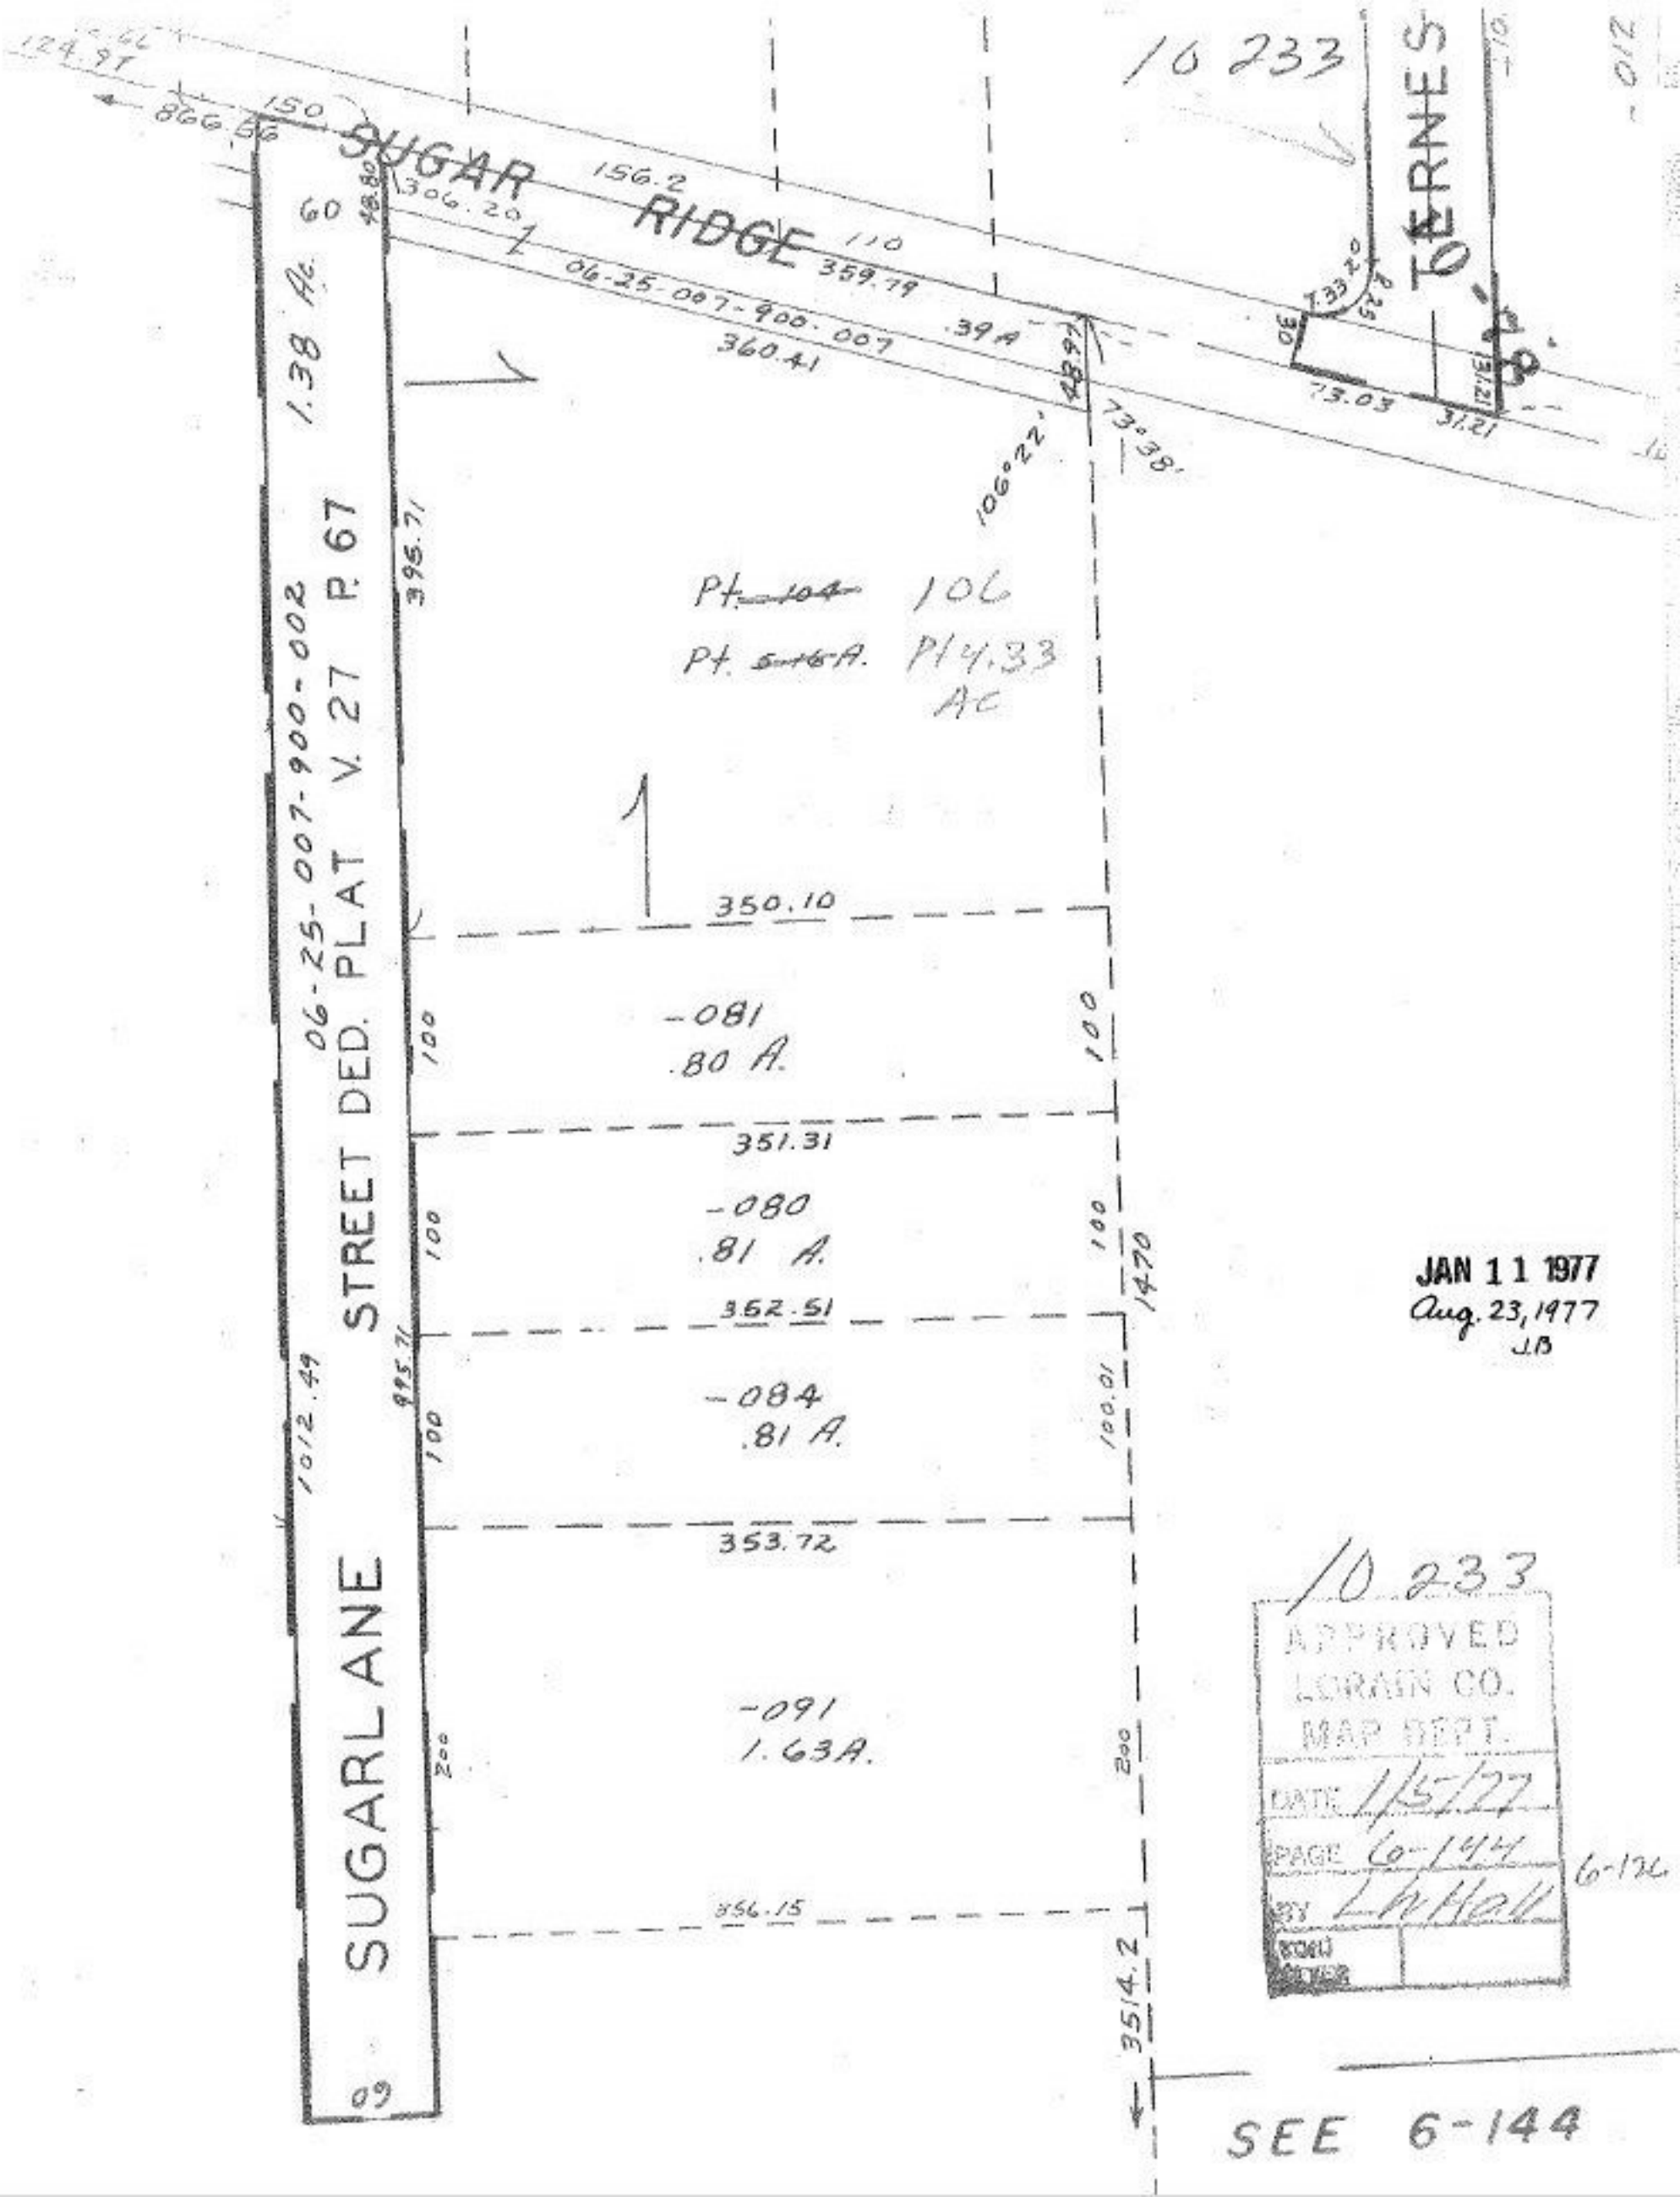


JAN 11 1977
Aug. 23, 1977
J.B

10 233
APPROVED
LORAIN CO.
MAP DEPT.
DATE 1/5/77
PAGE 6-144
BY L.H. Hall
6-126