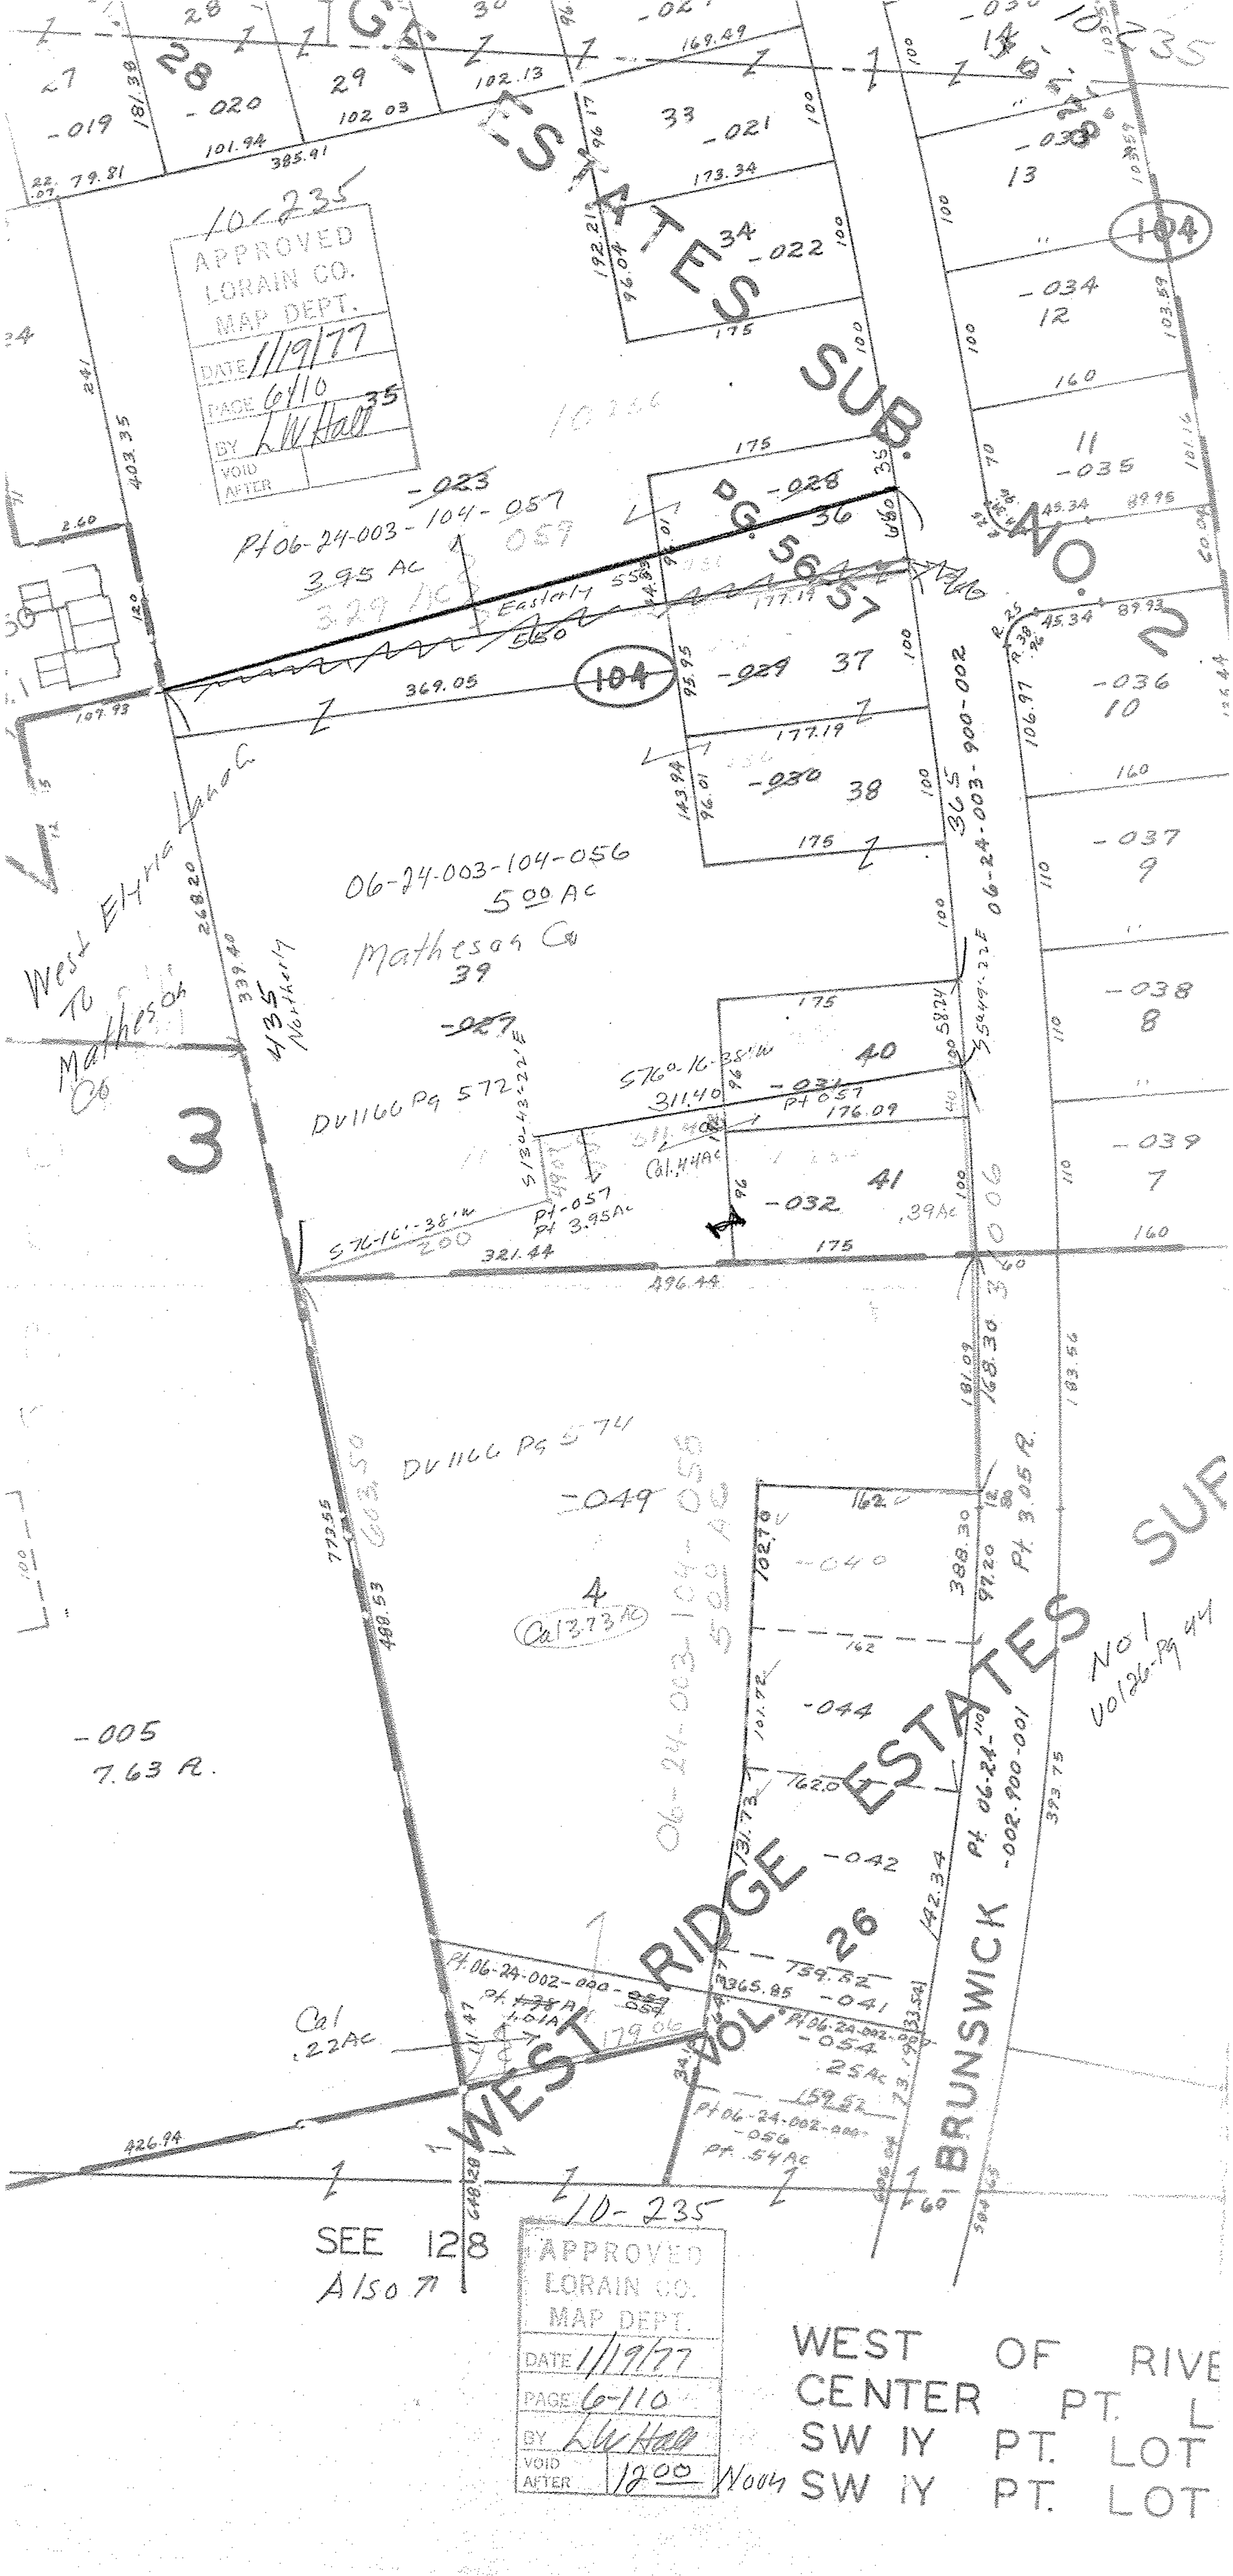

APPROVED
LORAIN CO.
MAP DEPT.
DATE 1/19/77
PAGE 6/10
BY LW Hall
VOID AFTER
10-235
ESTATES SUB. NO. 2
PG. 56 57
104
Pt 06-24-003-104-057
3.95 AC
Easterly 550
06-24-003-104-056
5.00 AC
Matheson Co
West Elyria Land Co
To Matheson Co
435 Northerly
DV1166 Pg 572
DV1166 Pg 574
06-24-003-104-055
5.00 AC
Cal 3.73 AC
-005
7.63 A.
Cal .22 AC
WEST RIDGE ESTATES SUB
VOL 26
BRUNSWICK
No 1 Vol 26 Pg 44
Pt 06-24-002-900-001
Pt 06-24-002-000-056
Pt .54 AC
SEE 128
Also
APPROVED
LORAIN CO.
MAP DEPT.
DATE 1/19/77
PAGE 6-110
BY LW Hall
VOID AFTER 12.00 Noon
WEST OF RIVE
CENTER PT. L
SW IY PT. LOT
SW IY PT. LOT