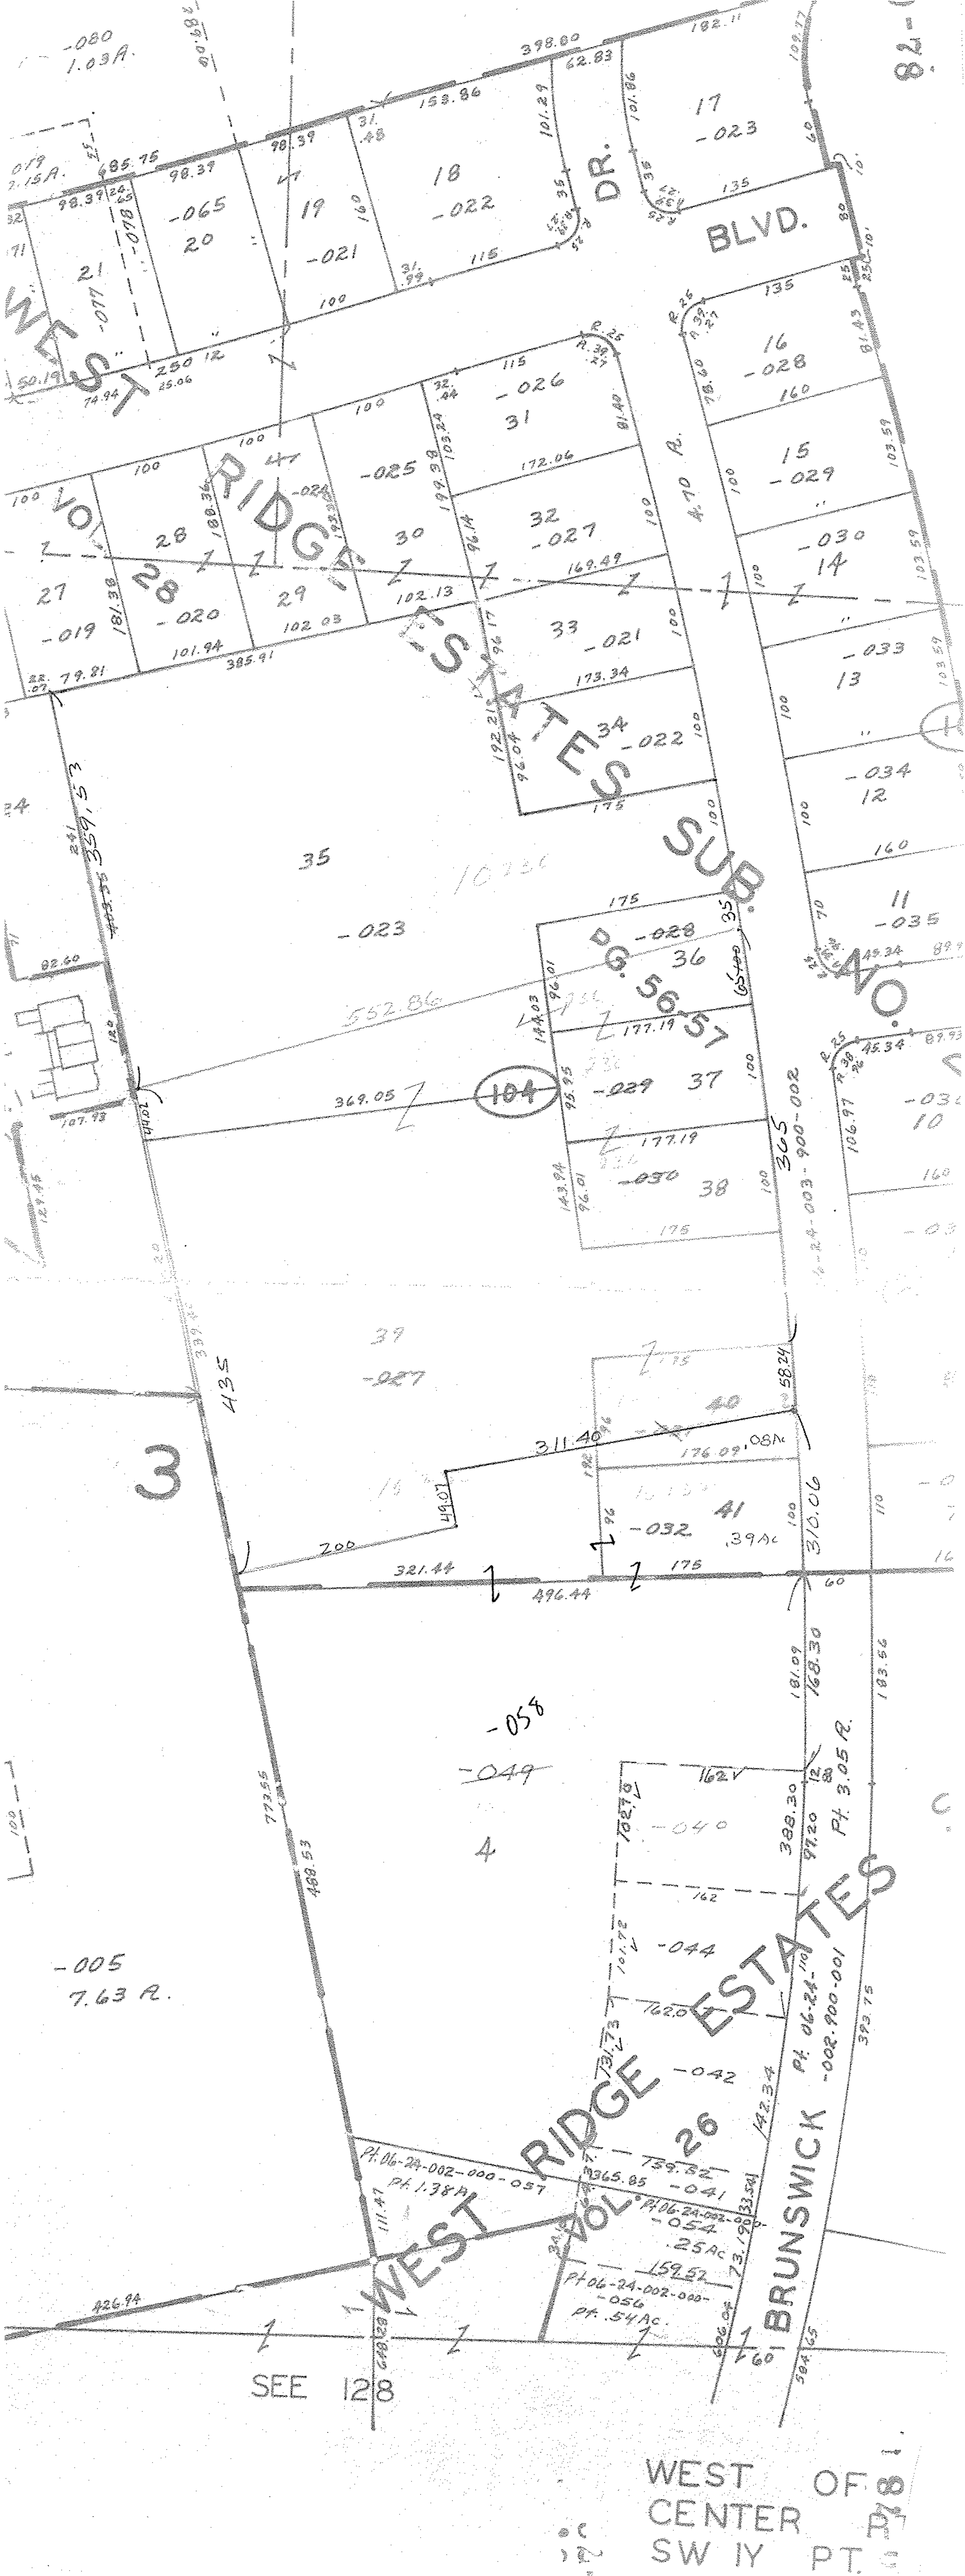
-080
1.03A.
398.80
62.83
182.11
109.17
82-
17
-023
101.86
DR.
BLVD.
98.39
153.86
101.29
18
-022
-065
20
19
-021
-078
21
-077
WEST
250
25.06
74.94
50.19
135
16
-028
160
78.60
81.43
15
-029
-026
31
-025
30
-027
32
-024
28
-020
29
-019
27
-030
14
-033
13
-034
12
-035
11
-036
10
RIDGE
ESTATES
SUB.
NO.
VOL.
26
PG.
57
169.49
172.06
173.34
175
102.13
101.94
102.03
385.91
79.81
359.53
552.86
35
-023
36
-028
37
-029
38
-030
104
369.05
177.19
305.00
-002-900-002
-024-003-900-002
39
-027
40
311.40
176.09 .08Ac
41
-032
.39Ac
310.06
200
321.44
496.44
3
435
-058
-049
4
-005
7.63 R.
772.56
468.53
181.09
168.30
183.66
388.30
97.20
Pt. 3.05 R.
162
-040
-044
-042
-041
731.73
142.34
Pt. 06-24-002-000-001
373.15
Pt. 06-24-002-000-057
Pt. 1.38 Ac
365.85
739.82
Pt. 06-24-002-000-054
.25Ac
159.52
Pt. 06-24-002-000-056
Pt. .54Ac.
426.94
448.28
606.06
384.65
SEE 128
WEST OF
CENTER
SW 1Y PT.