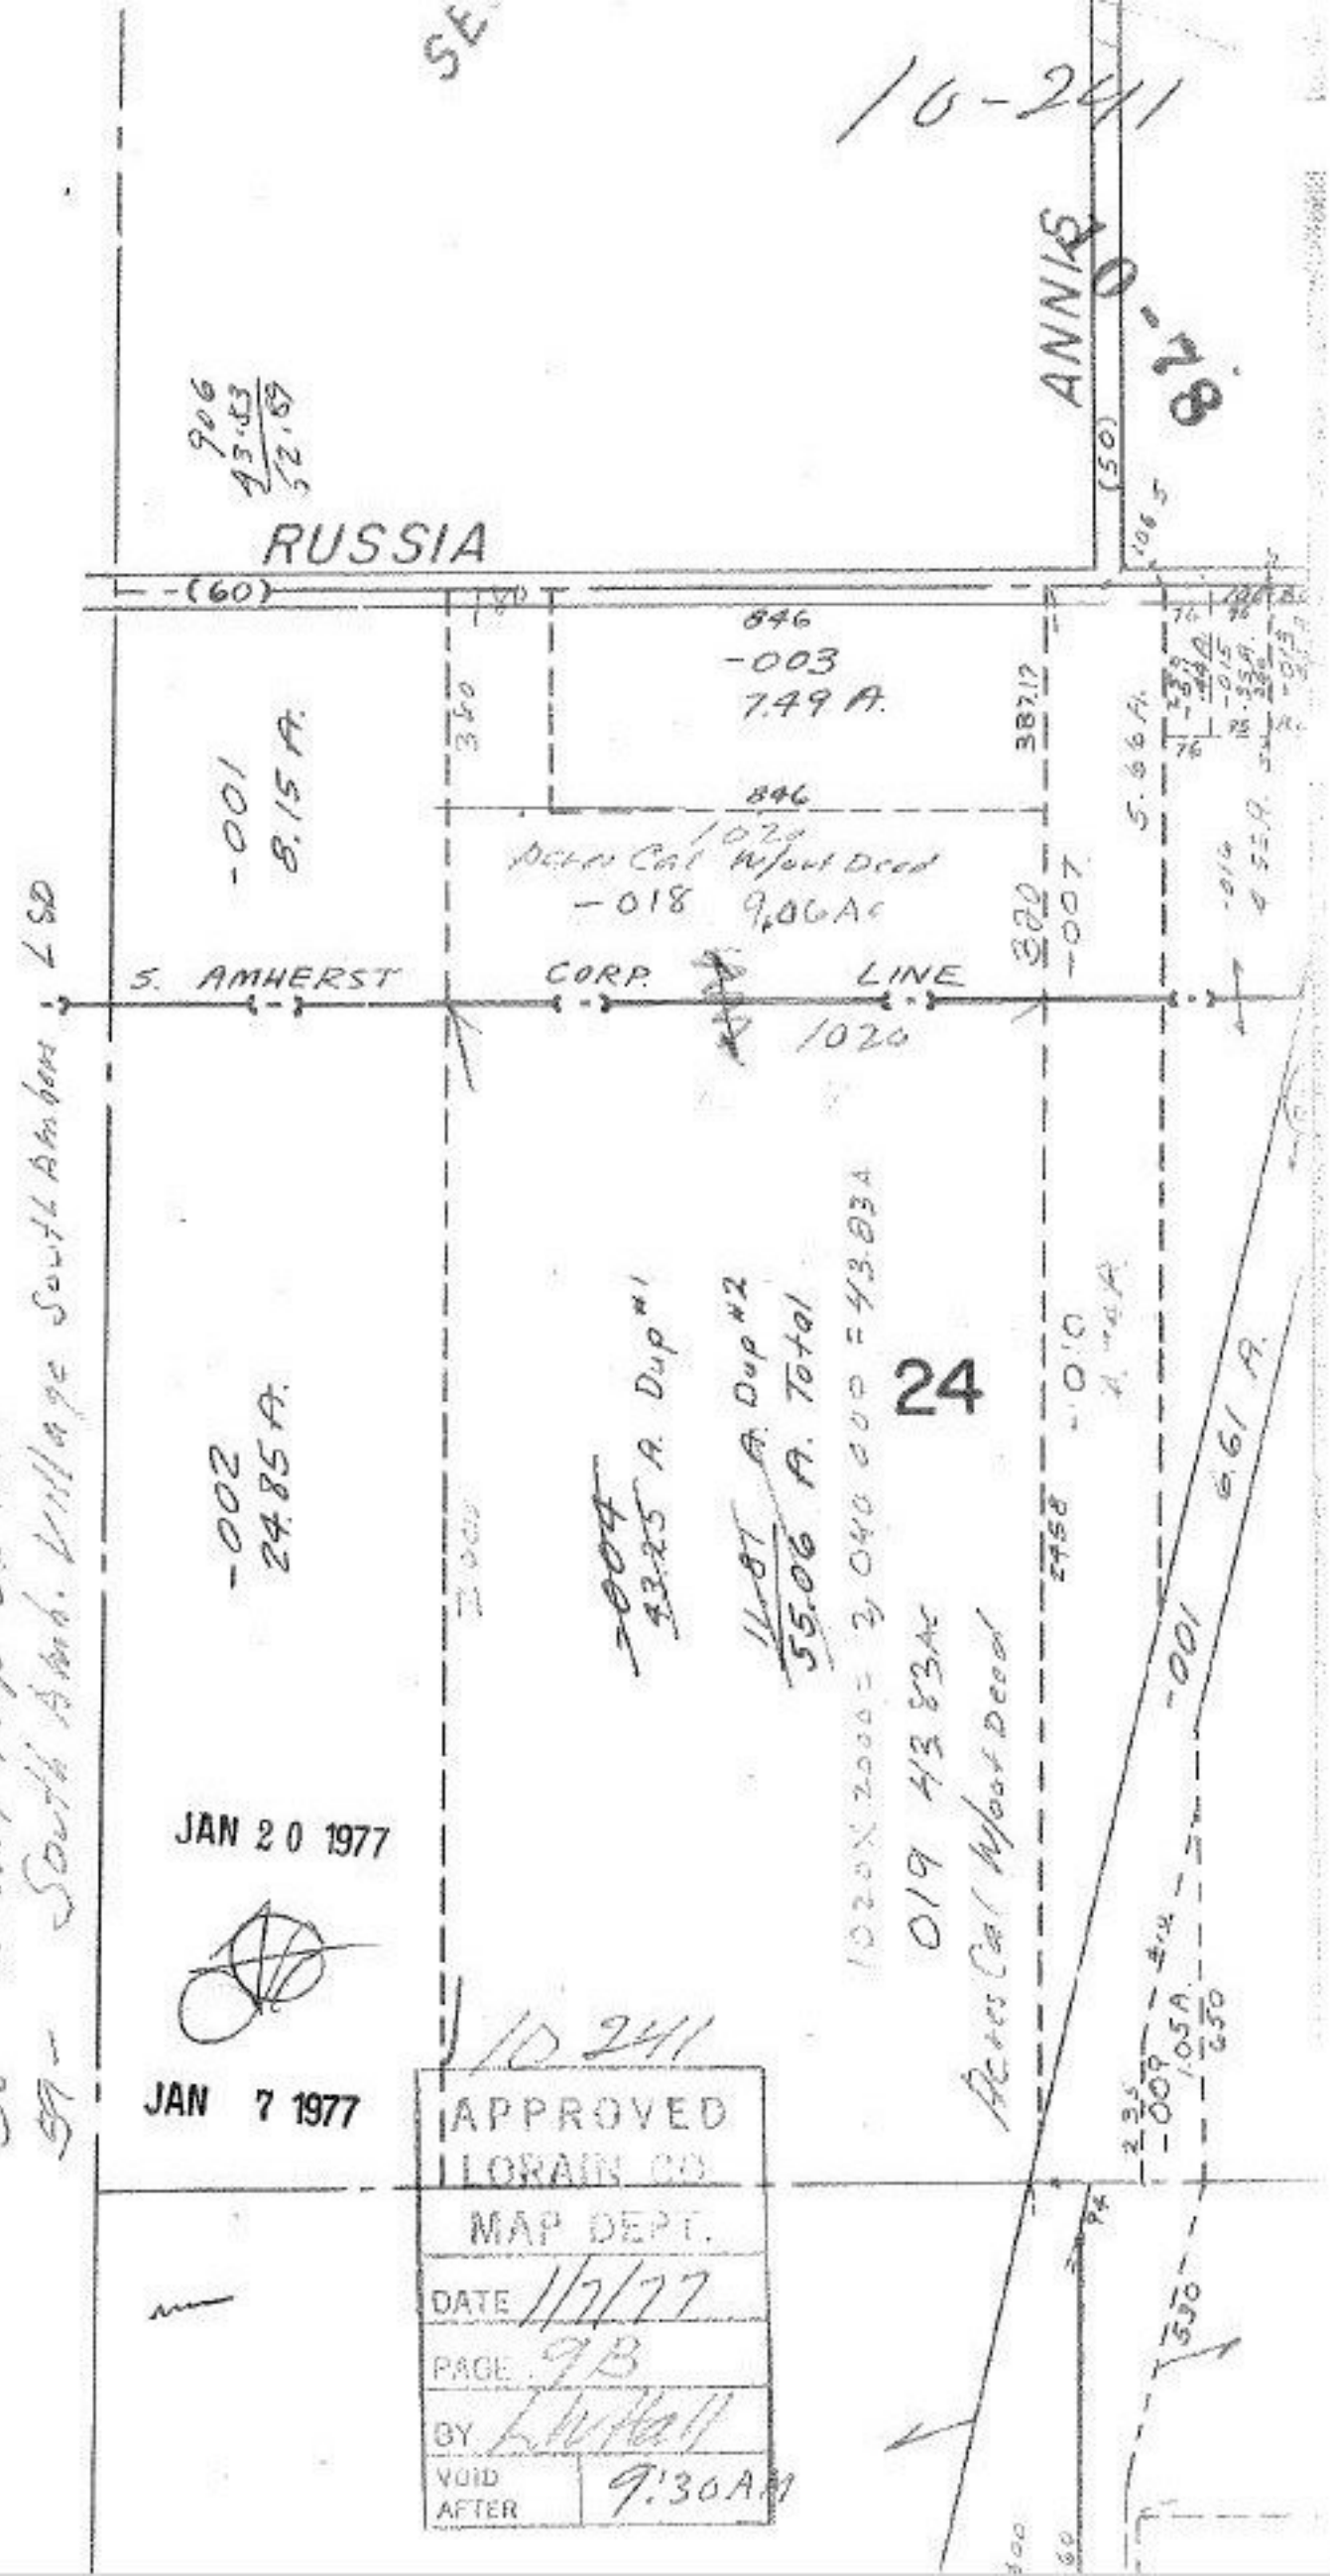Split Made To Assign Correct Acreage
& Correct Dist Nos 58 & 59
58 - Russia Twp Oberlin SD
59 - South Amh. Village South LSD