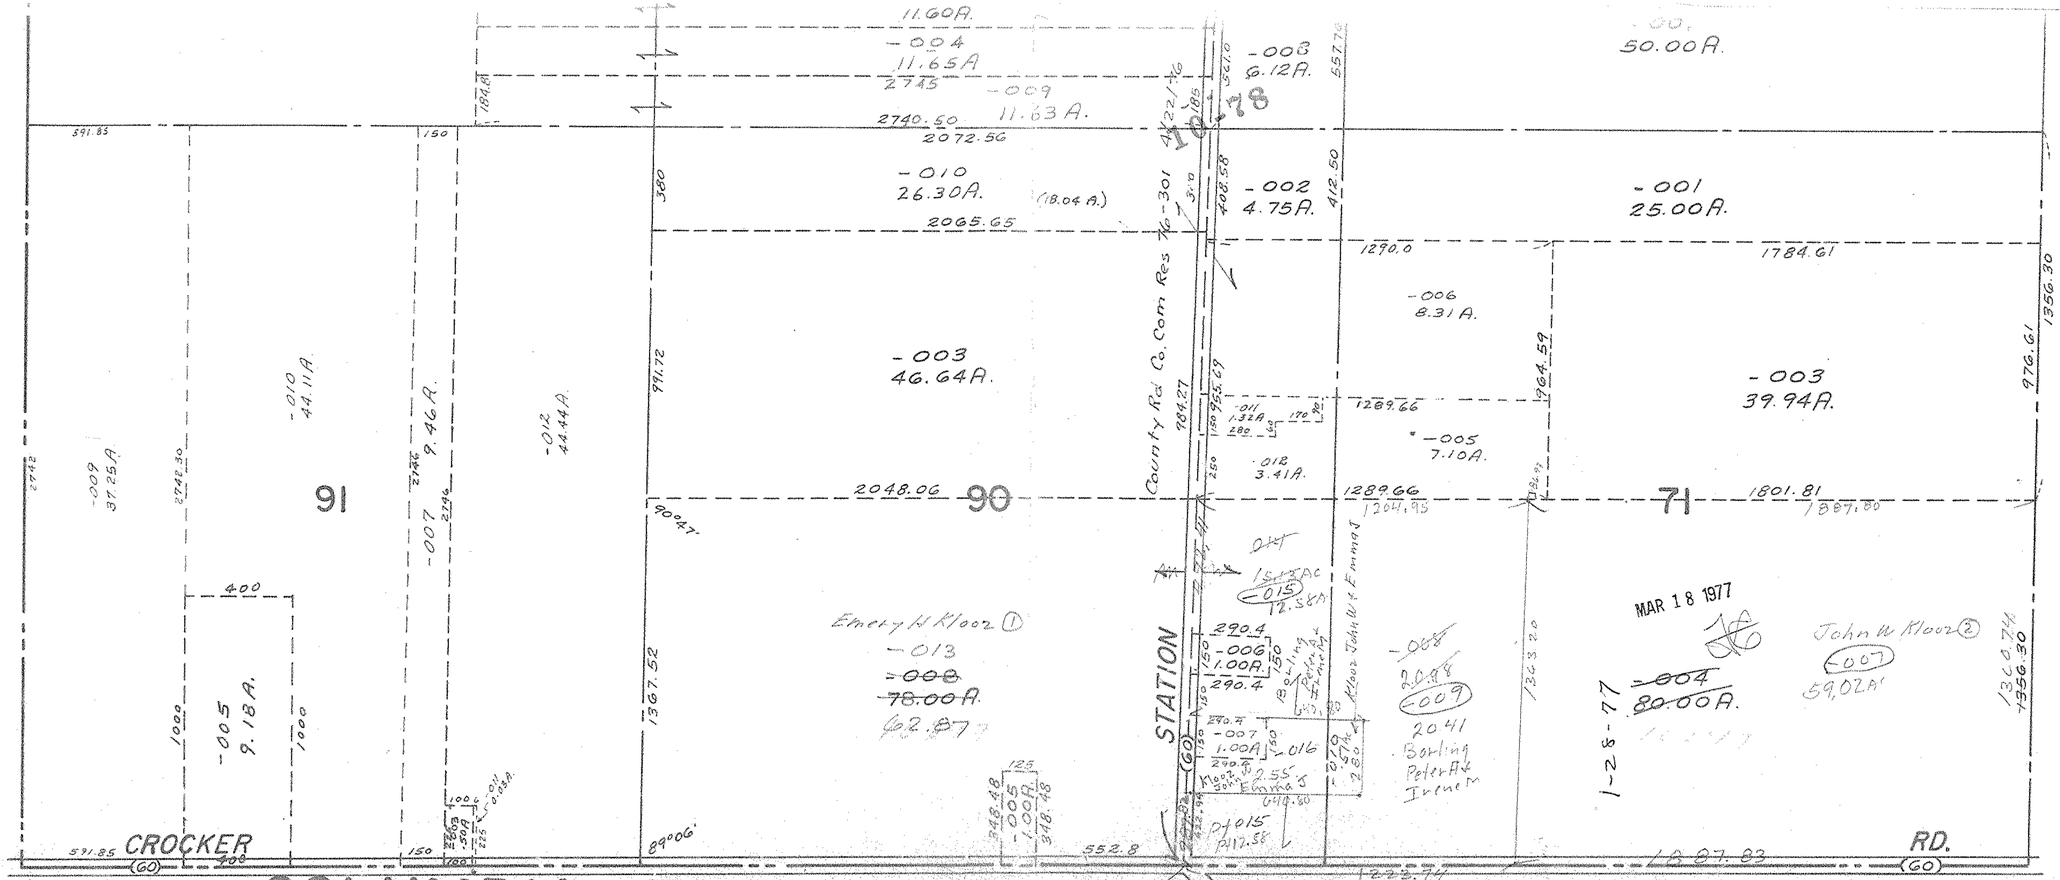
11.60A.
-004
11.65A
2745
-009
11.63A.
2740.50
2072.56
-010
26.30A.
(18.04 A.)
2065.65
-003
46.64A.
2048.06
90
-009
37.25A.
-010
44.11A
-007
9.46A.
-012
44.44A.
91
-005
9.18A.
400
1000
1000
591.85
CROCKER
(60)
89°06'
552.8
367.52
991.72
2742
2742.30
2746
2744
Emery N Kloos ①
-013
-008
78.00A.
Emery N Kloos
-015
12.56A
-006
1.00A.
-007
1.00A
-016
2.55
-005
1.00A.
348.48
125
-014
0.13A
-003
6.12A.
-002
4.75A.
-010
-011
1.32A
-012
3.41A.
-006
8.31A.
-005
7.10A.
-001
25.00A.
-003
39.94A.
50.00A.
-008
-009
2041
Barling
Peter A &
Irene M
Klaus John W & Emma
Barling
Peter A &
Irene M
Emma S
Kloos
Kloos John W & Emma
County Rd Co. Com Res 76-301
10-78
MAR 18 1977
1-28-77
-004
80.00A.
John W Kloos ②
-007
59.02A
-015
D/T
1 SEPTAC
-015
D/015
P/117.58
STATION
(60)
RD.
(60)
1784.61
1289.66
1290.0
1289.66
1204.95
1801.81
1887.80
1764.59
1343.20
1356.30
976.61
1356.30
1340.74
557.70
408.58
412.50
394.27
955.69
170.72
280
250
222.74
1807.83
591.85
150
360
180.68
5.10
22.46
18.85
Copyright 1962
9-17-76
12-E
COLUMBIA TWP.
SCALE: 1" = 400'
LOTS 71 THRU 75, 86 THRU 95