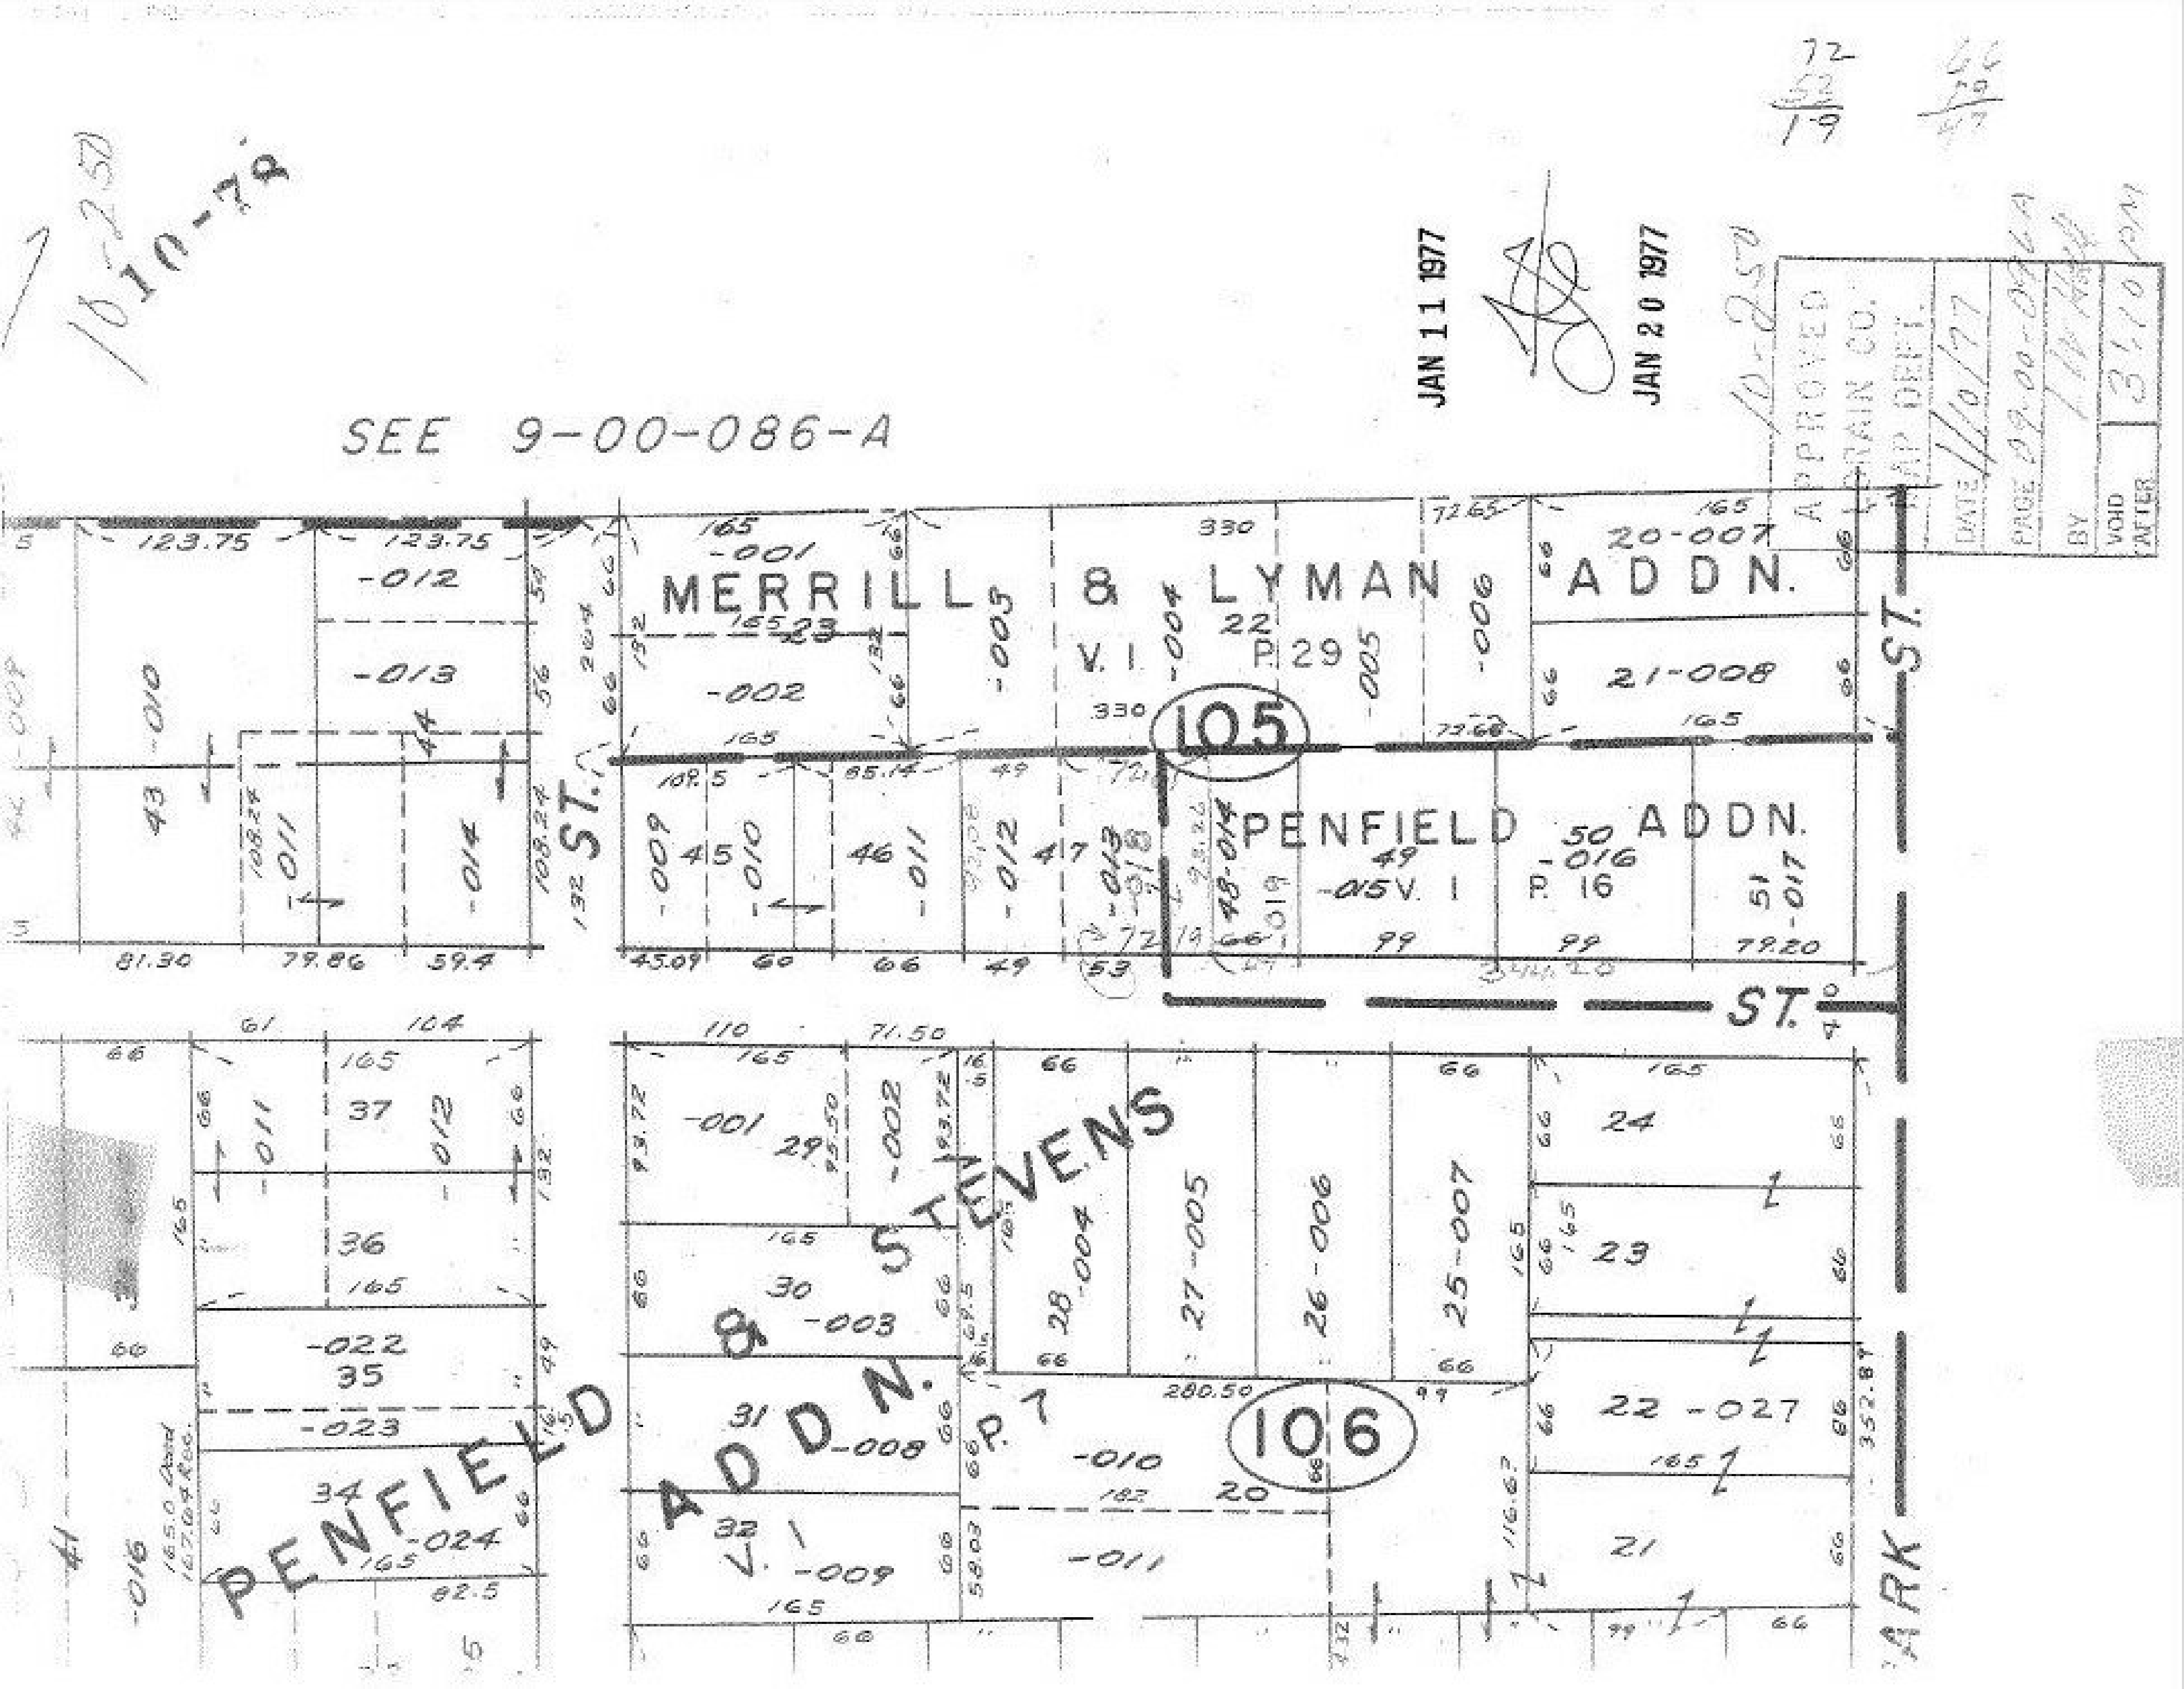

1010-7R
SEE 9-00-086-A
JAN 11 1977
JAN 20 1977
APPROVED
DRAIN CO.
MAP DEPT.
DATE 1/10/77
PAGE 09-00-086-A
BY
VOID AFTER
MERRILL & LYMAN ADDN.
V. 1 P. 29
105
PENFIELD ADDN.
V. 1 P. 16
ST.
PENFIELD & STEVENS ADDN.
V. 1 P. 7
106
20-007
21-008
22-027
27-005
26-006
25-007
28-004