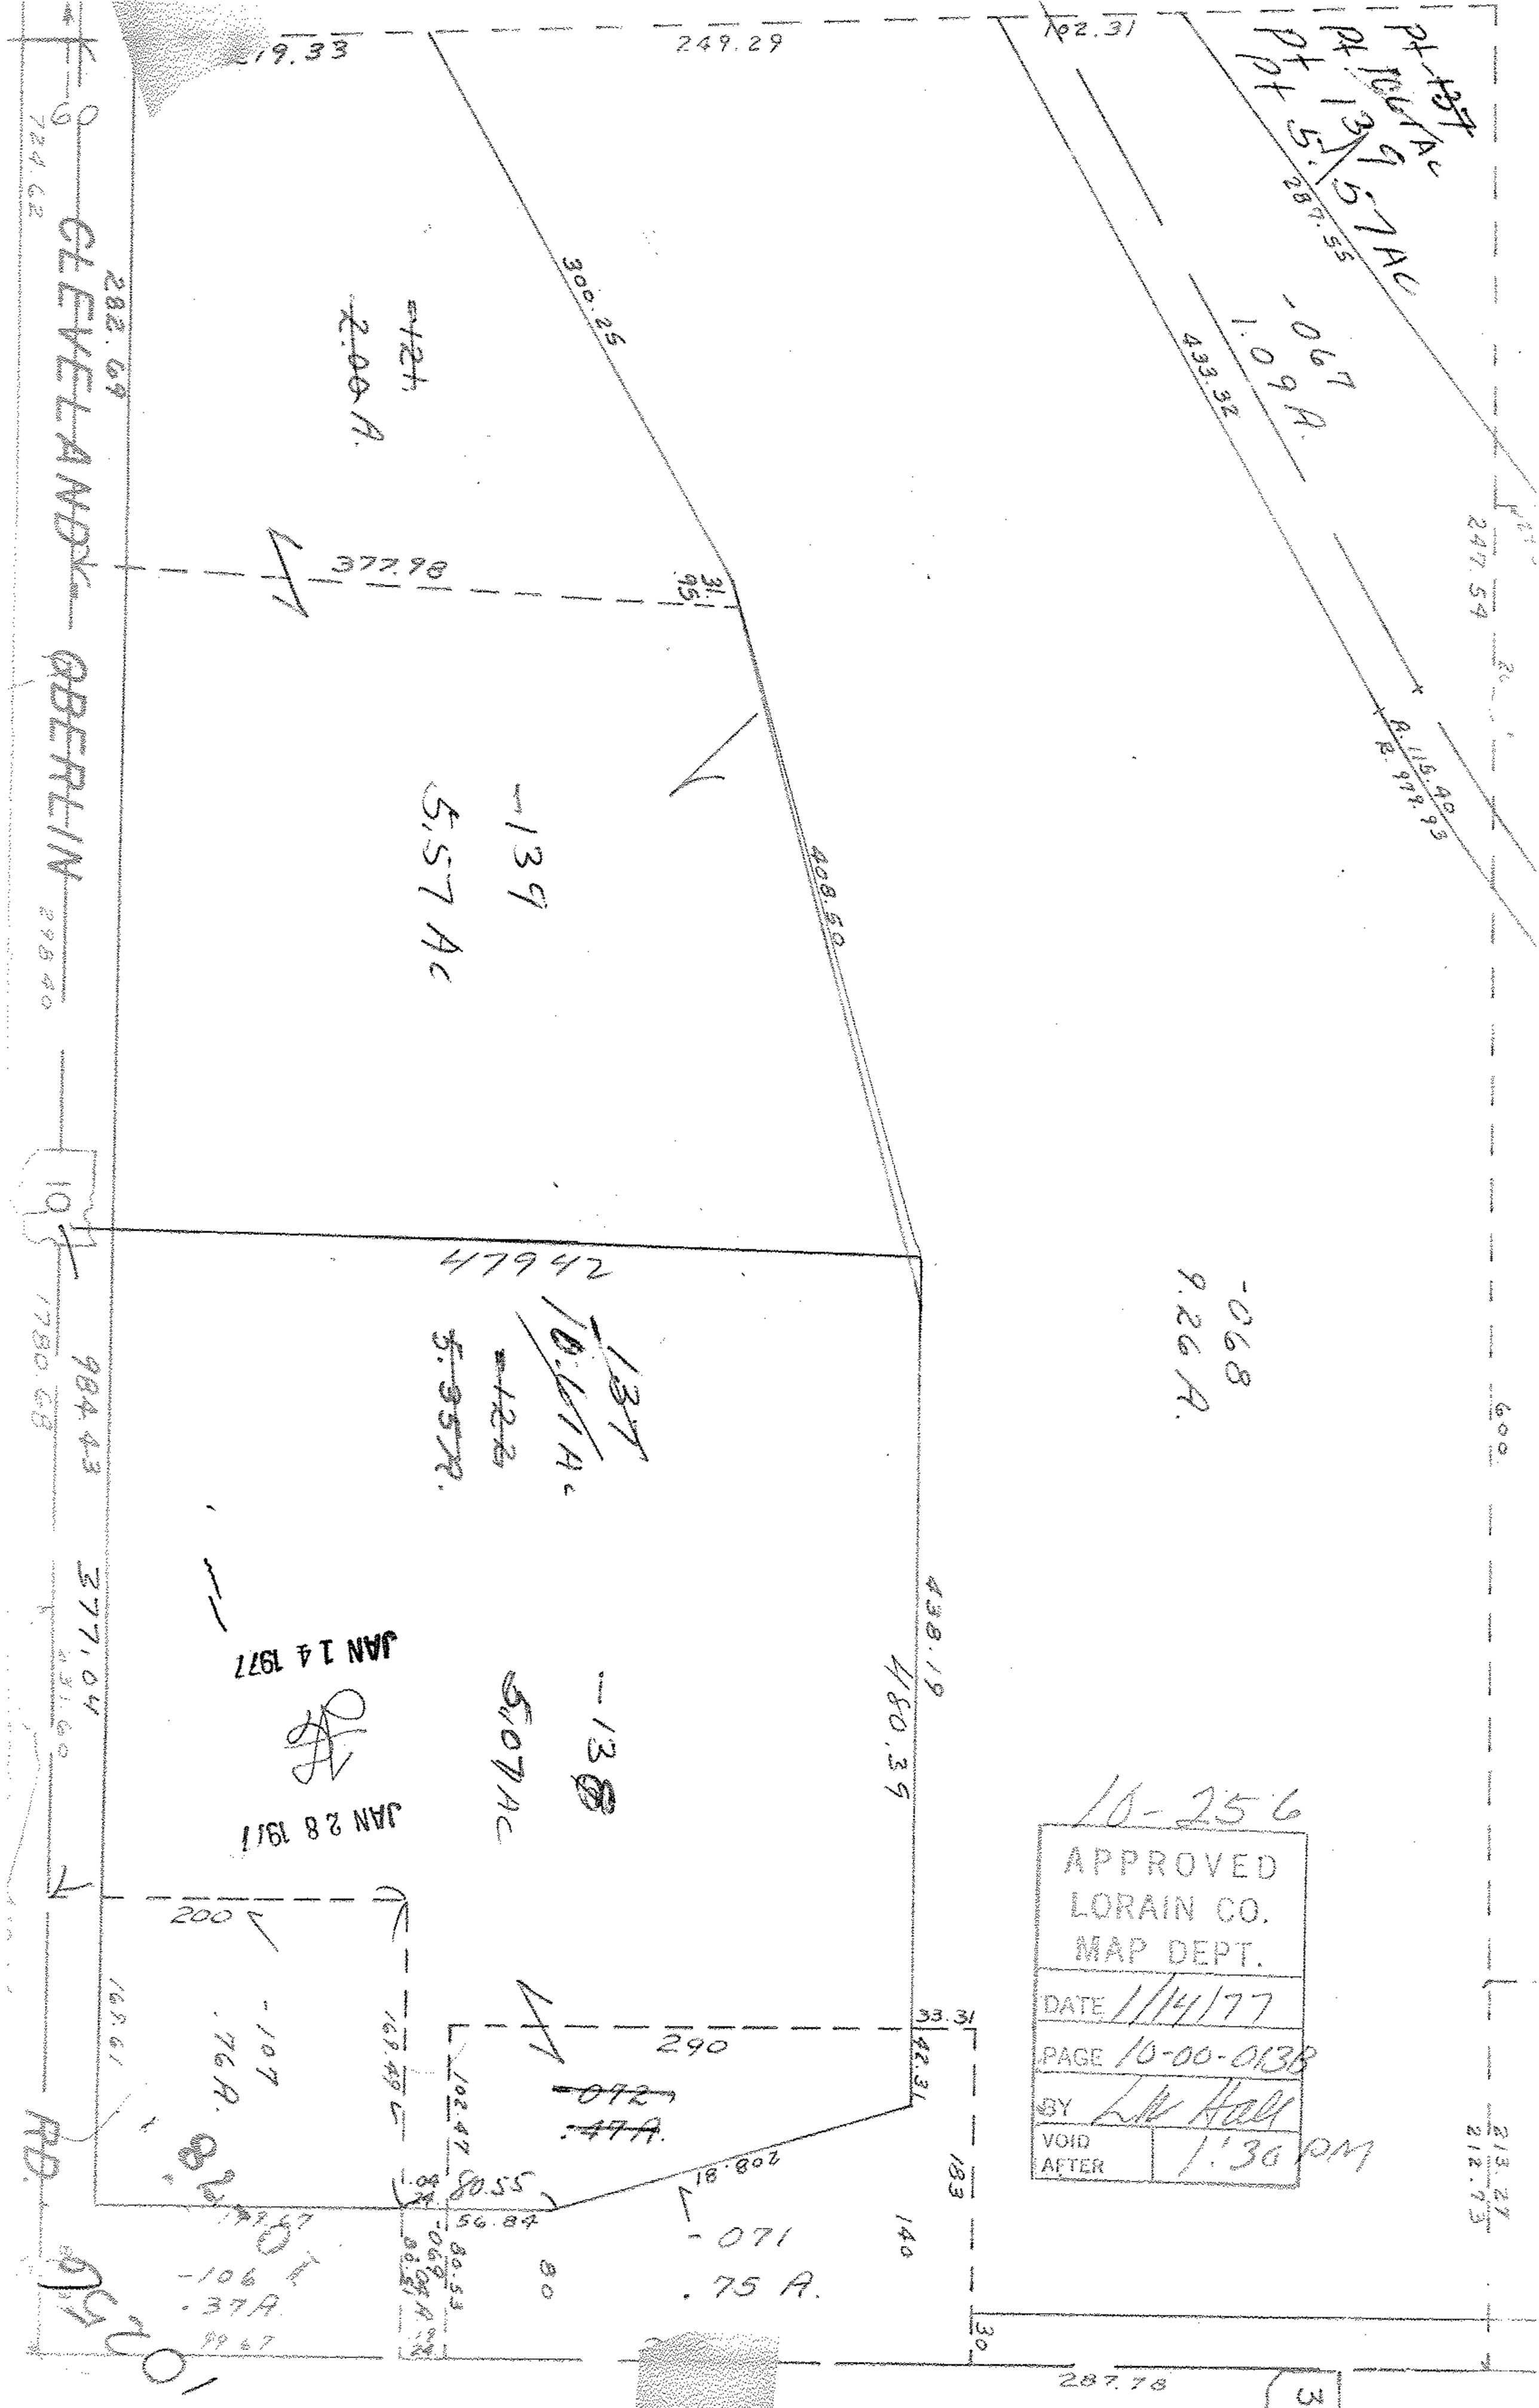
APPROVED
LORAIN CO.
MAP DEPT.
DATE 1/14/77
PAGE 10-00-0138
BY
VOID AFTER 1.30 pm
JAN 14 1977
JAN 28 1977
10-256
600
249.29
300.25
42.31
433.32
1.09 A.
-067
-069
-070
-071
-072
-077
-106
-137
-138
