10-259

10-78

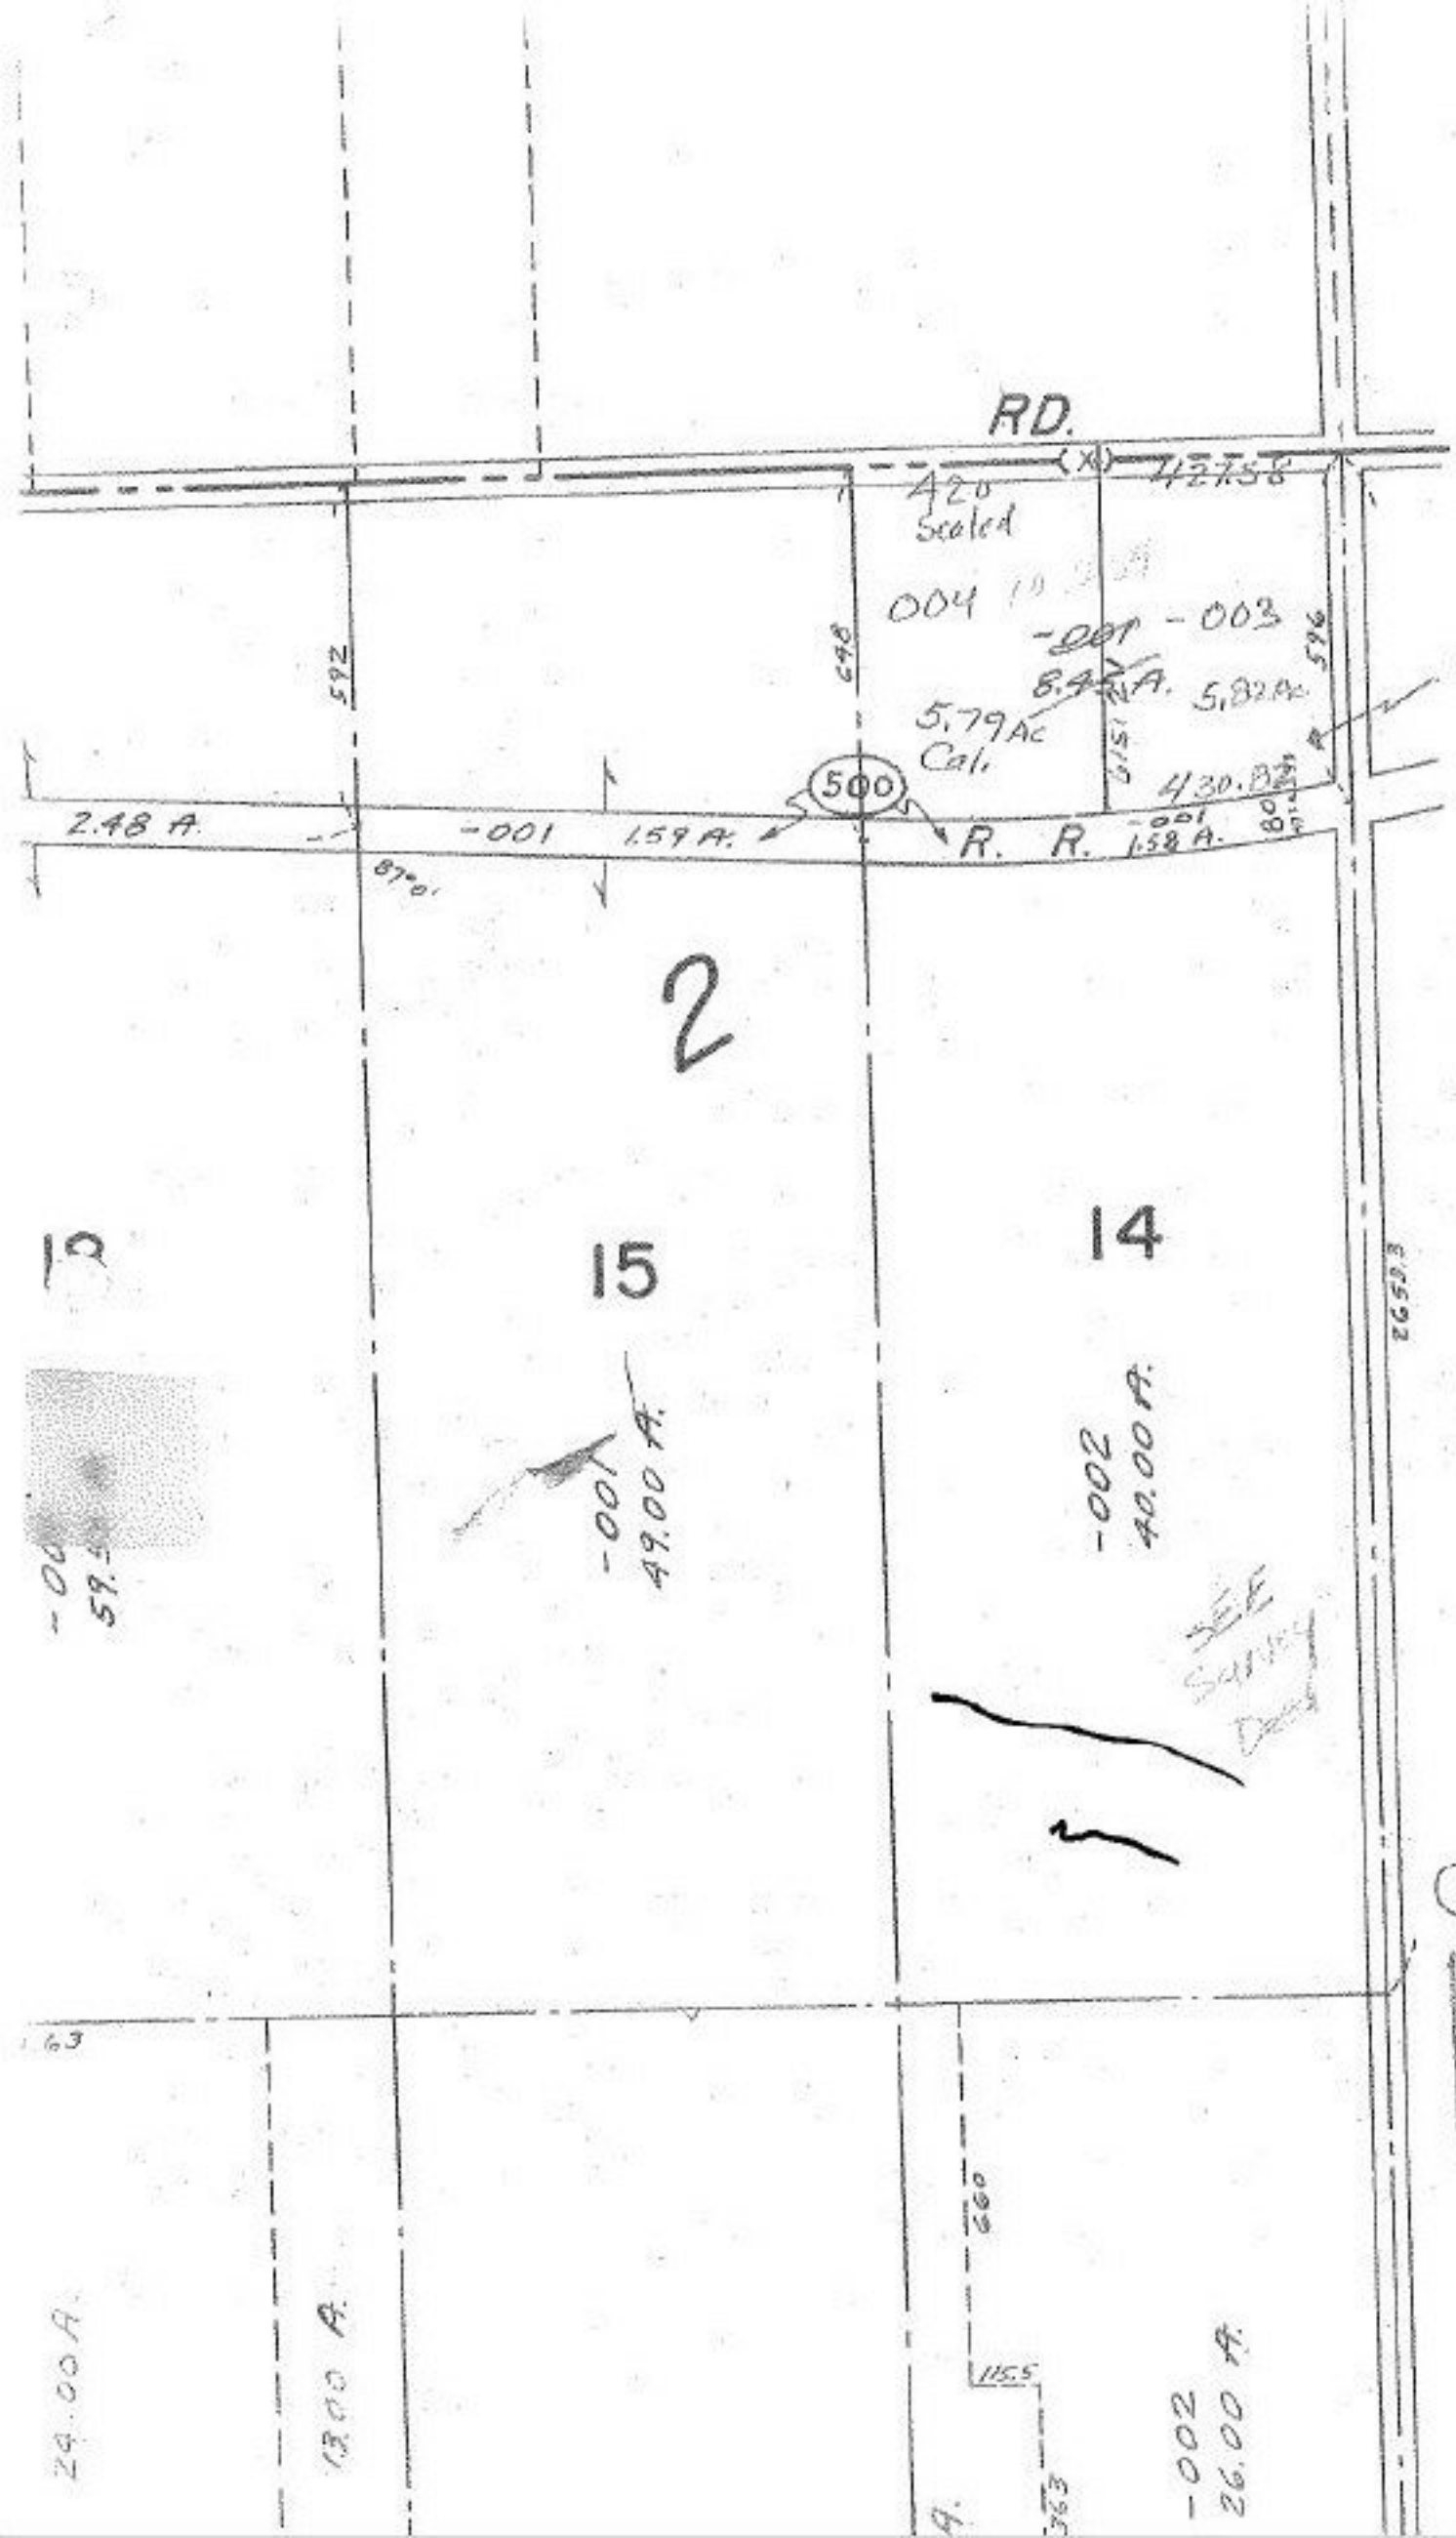


Surveyed by
W.L Fox
Dec 1976

420
x 600
252,000
43560 = 5.79 Ac

Calculation
of Remainder

MAR 25 1977

10-259

APPROVED
LORAIN CO.
MAP DEPT.

| | |
|---|---|
| DATE | 1/19/77 |
| PAGE | 21E |
| BY | L W Hall |
| VOID AFTER | 3:00 PM |

JAN 21 1977