10267
10-781

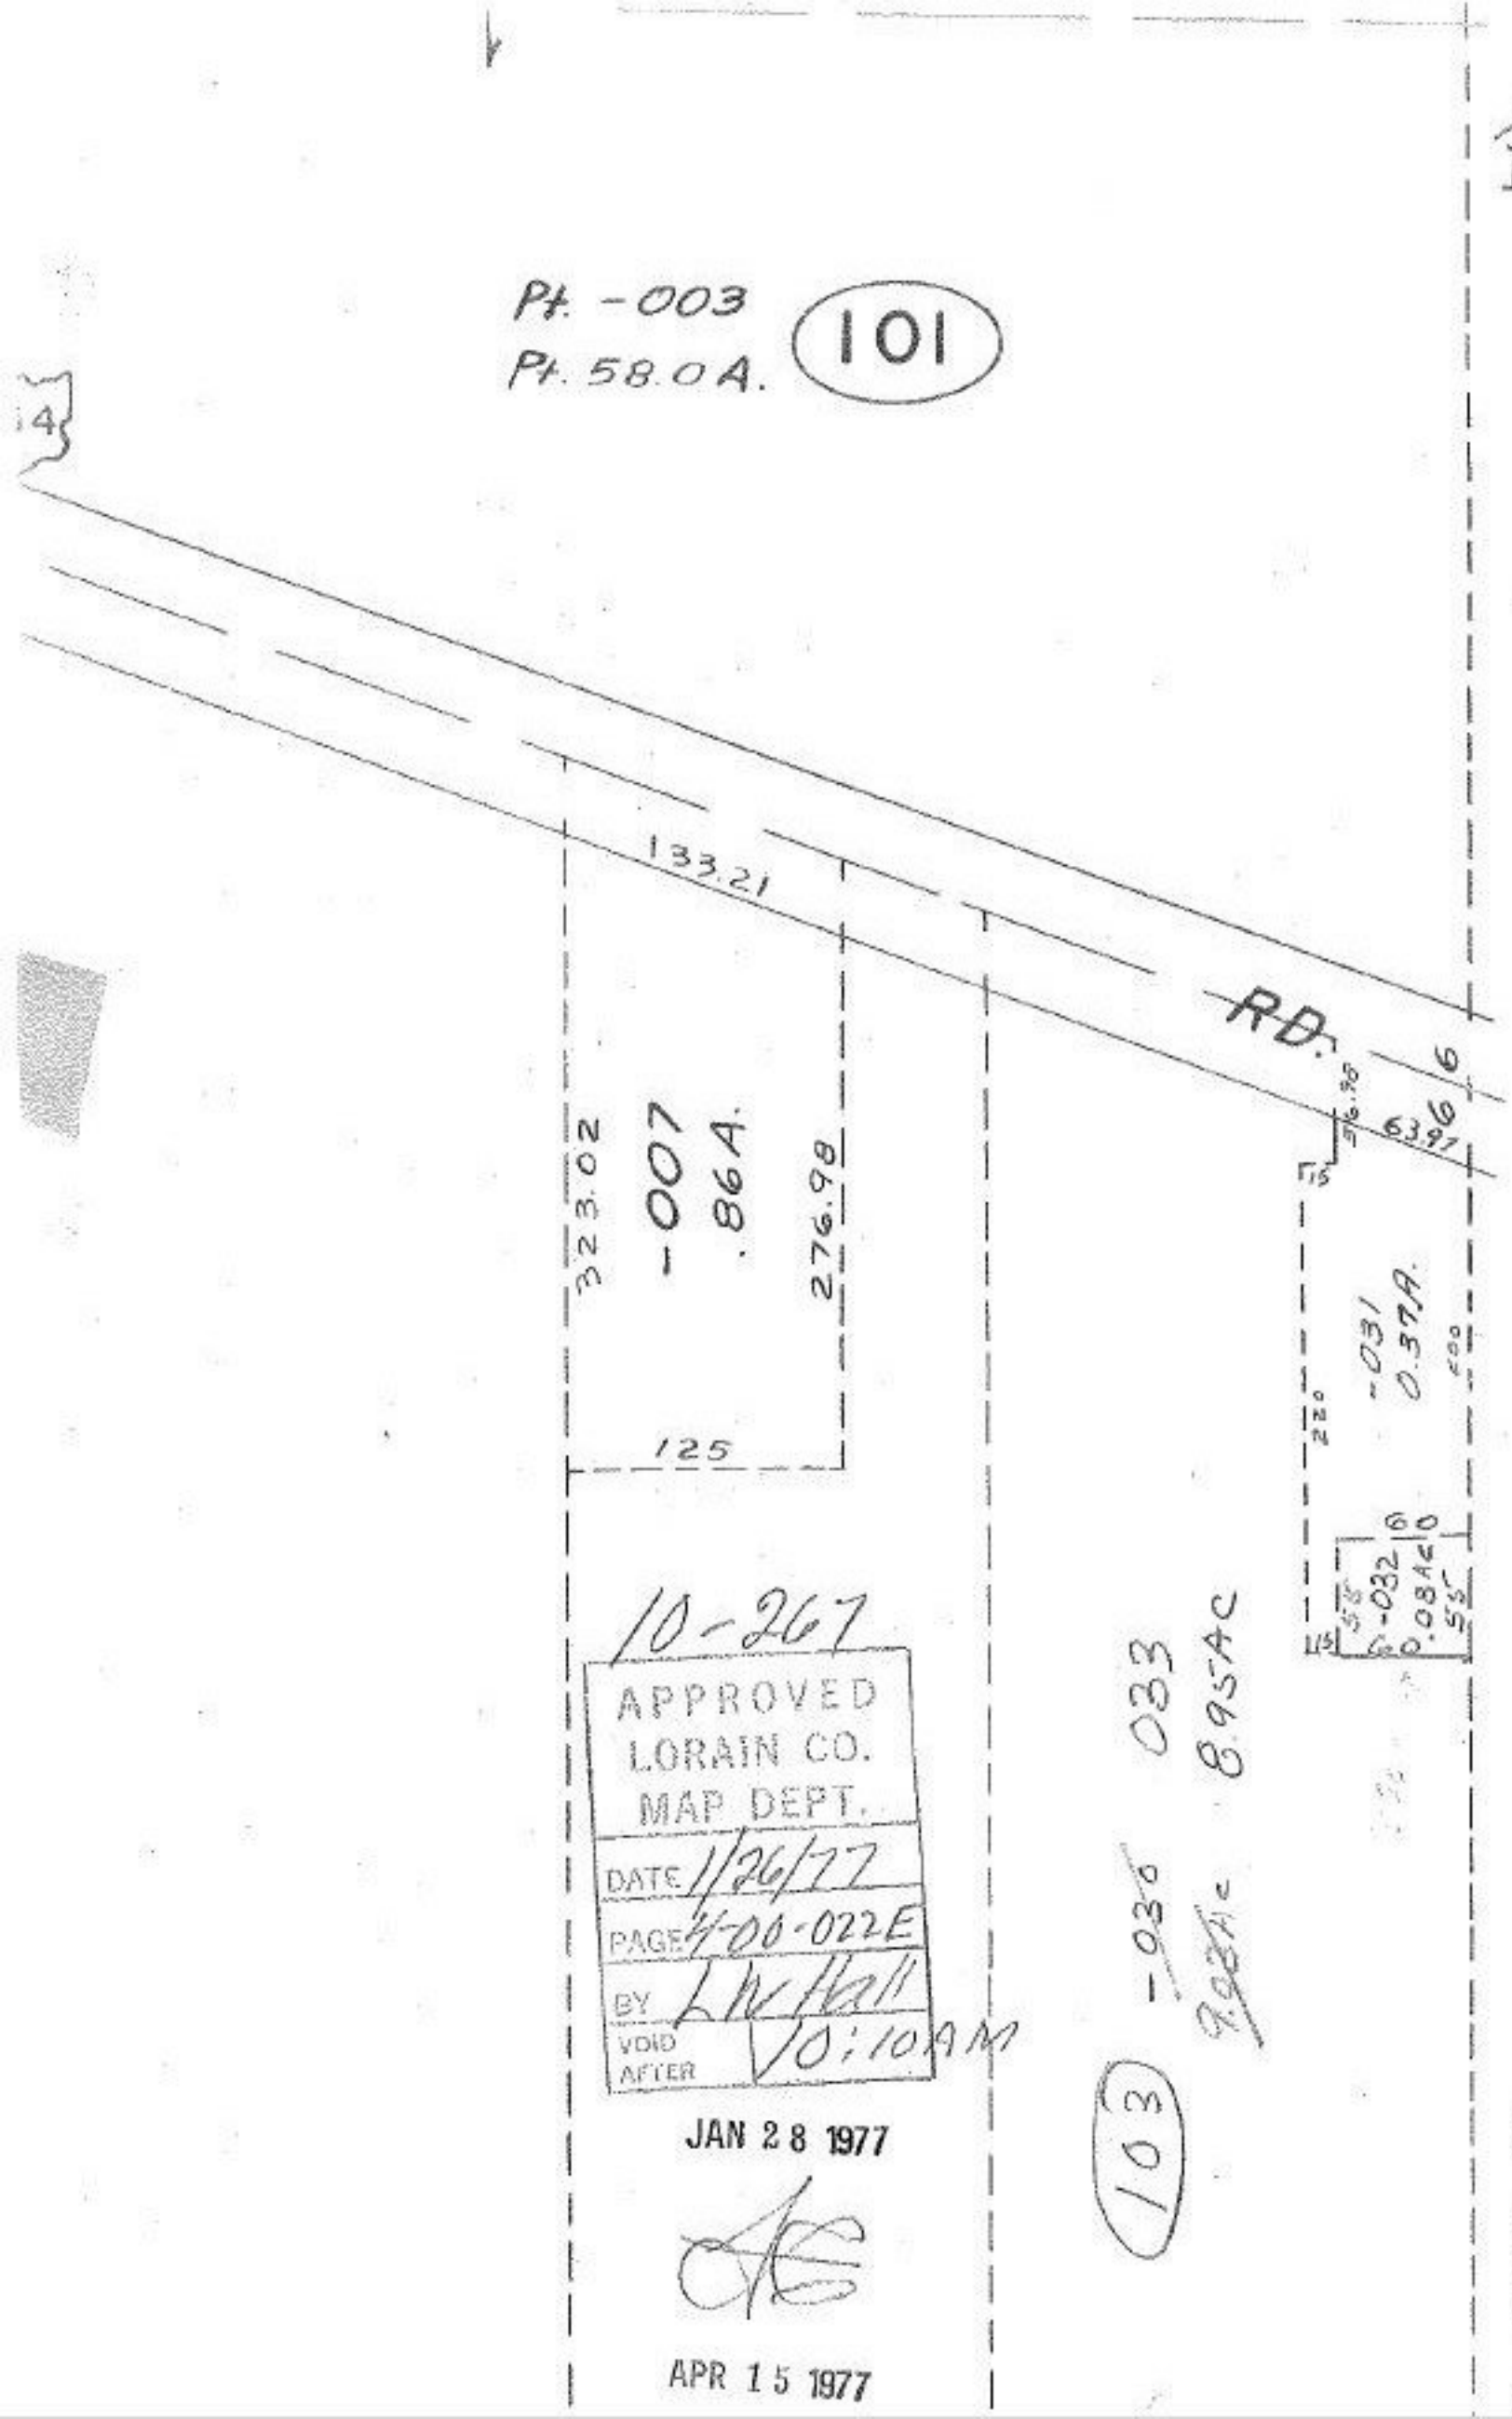

10-267

APPROVED
LORAIN CO.
MAP DEPT.
DATE 1/26/77
PAGE 4-00-022E
BY L.W. Hall
VOID AFTER 10:10AM

JAN 28 1977

APR 15 1977

0-022-F