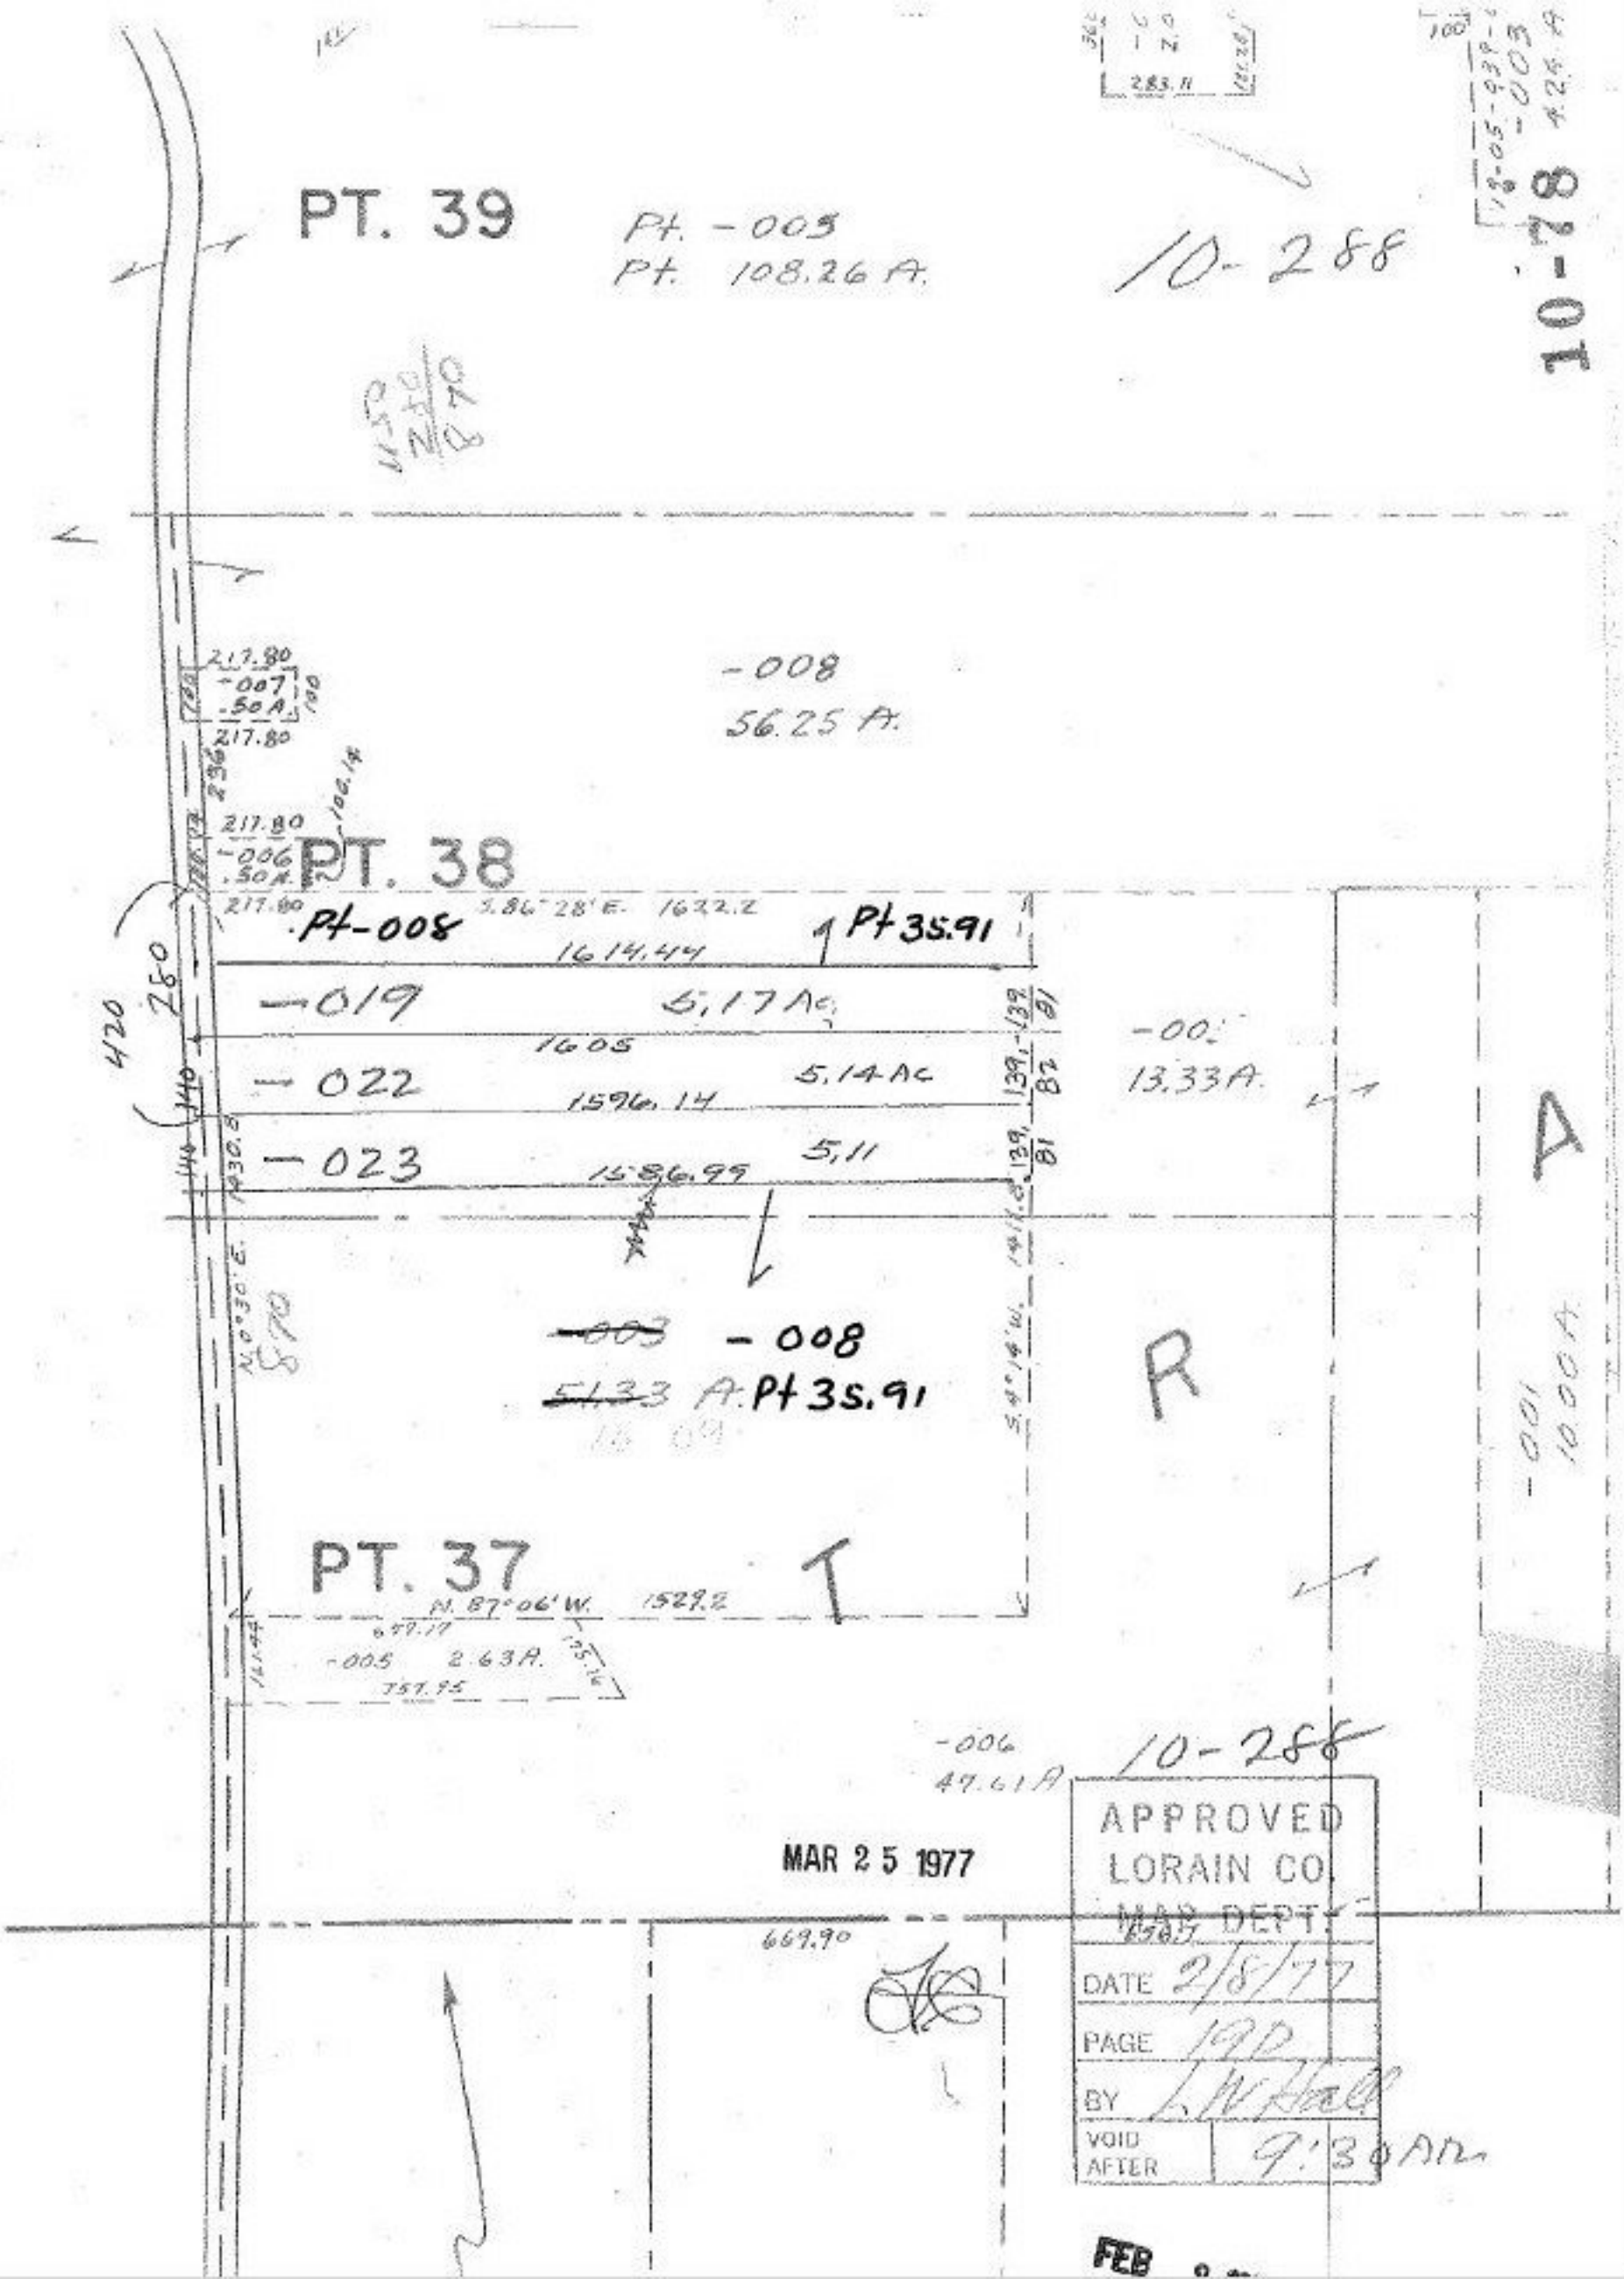

PT. 39
Pt. -003
Pt. 108.26 A.
10-288
10-78
-008
56.25 A.
217.80
-007
.50 A.
217.80
217.80
-006
.50 A.
217.80
PT. 38
Pt-008
S.86°28'E. 1622.2
Pt 35.91
1614.44
-019
5.17 Ac.
1605
-022
5.14 Ac
1596.14
-023
5.11
1586.99
-00
13.33 A.
A
-003 -008
51.33 A. Pt 35.91
R
PT. 37
T
N. 87°06'W. 1529.2
-005 2.63 A.
757.95
-006
47.61 A
10-288
MAR 25 1977
APPROVED
LORAIN CO.
MAP DEPT.
DATE 2/8/77
PAGE 190
BY L.W. Hall
VOID AFTER 9:30 AM
669.90
FEB