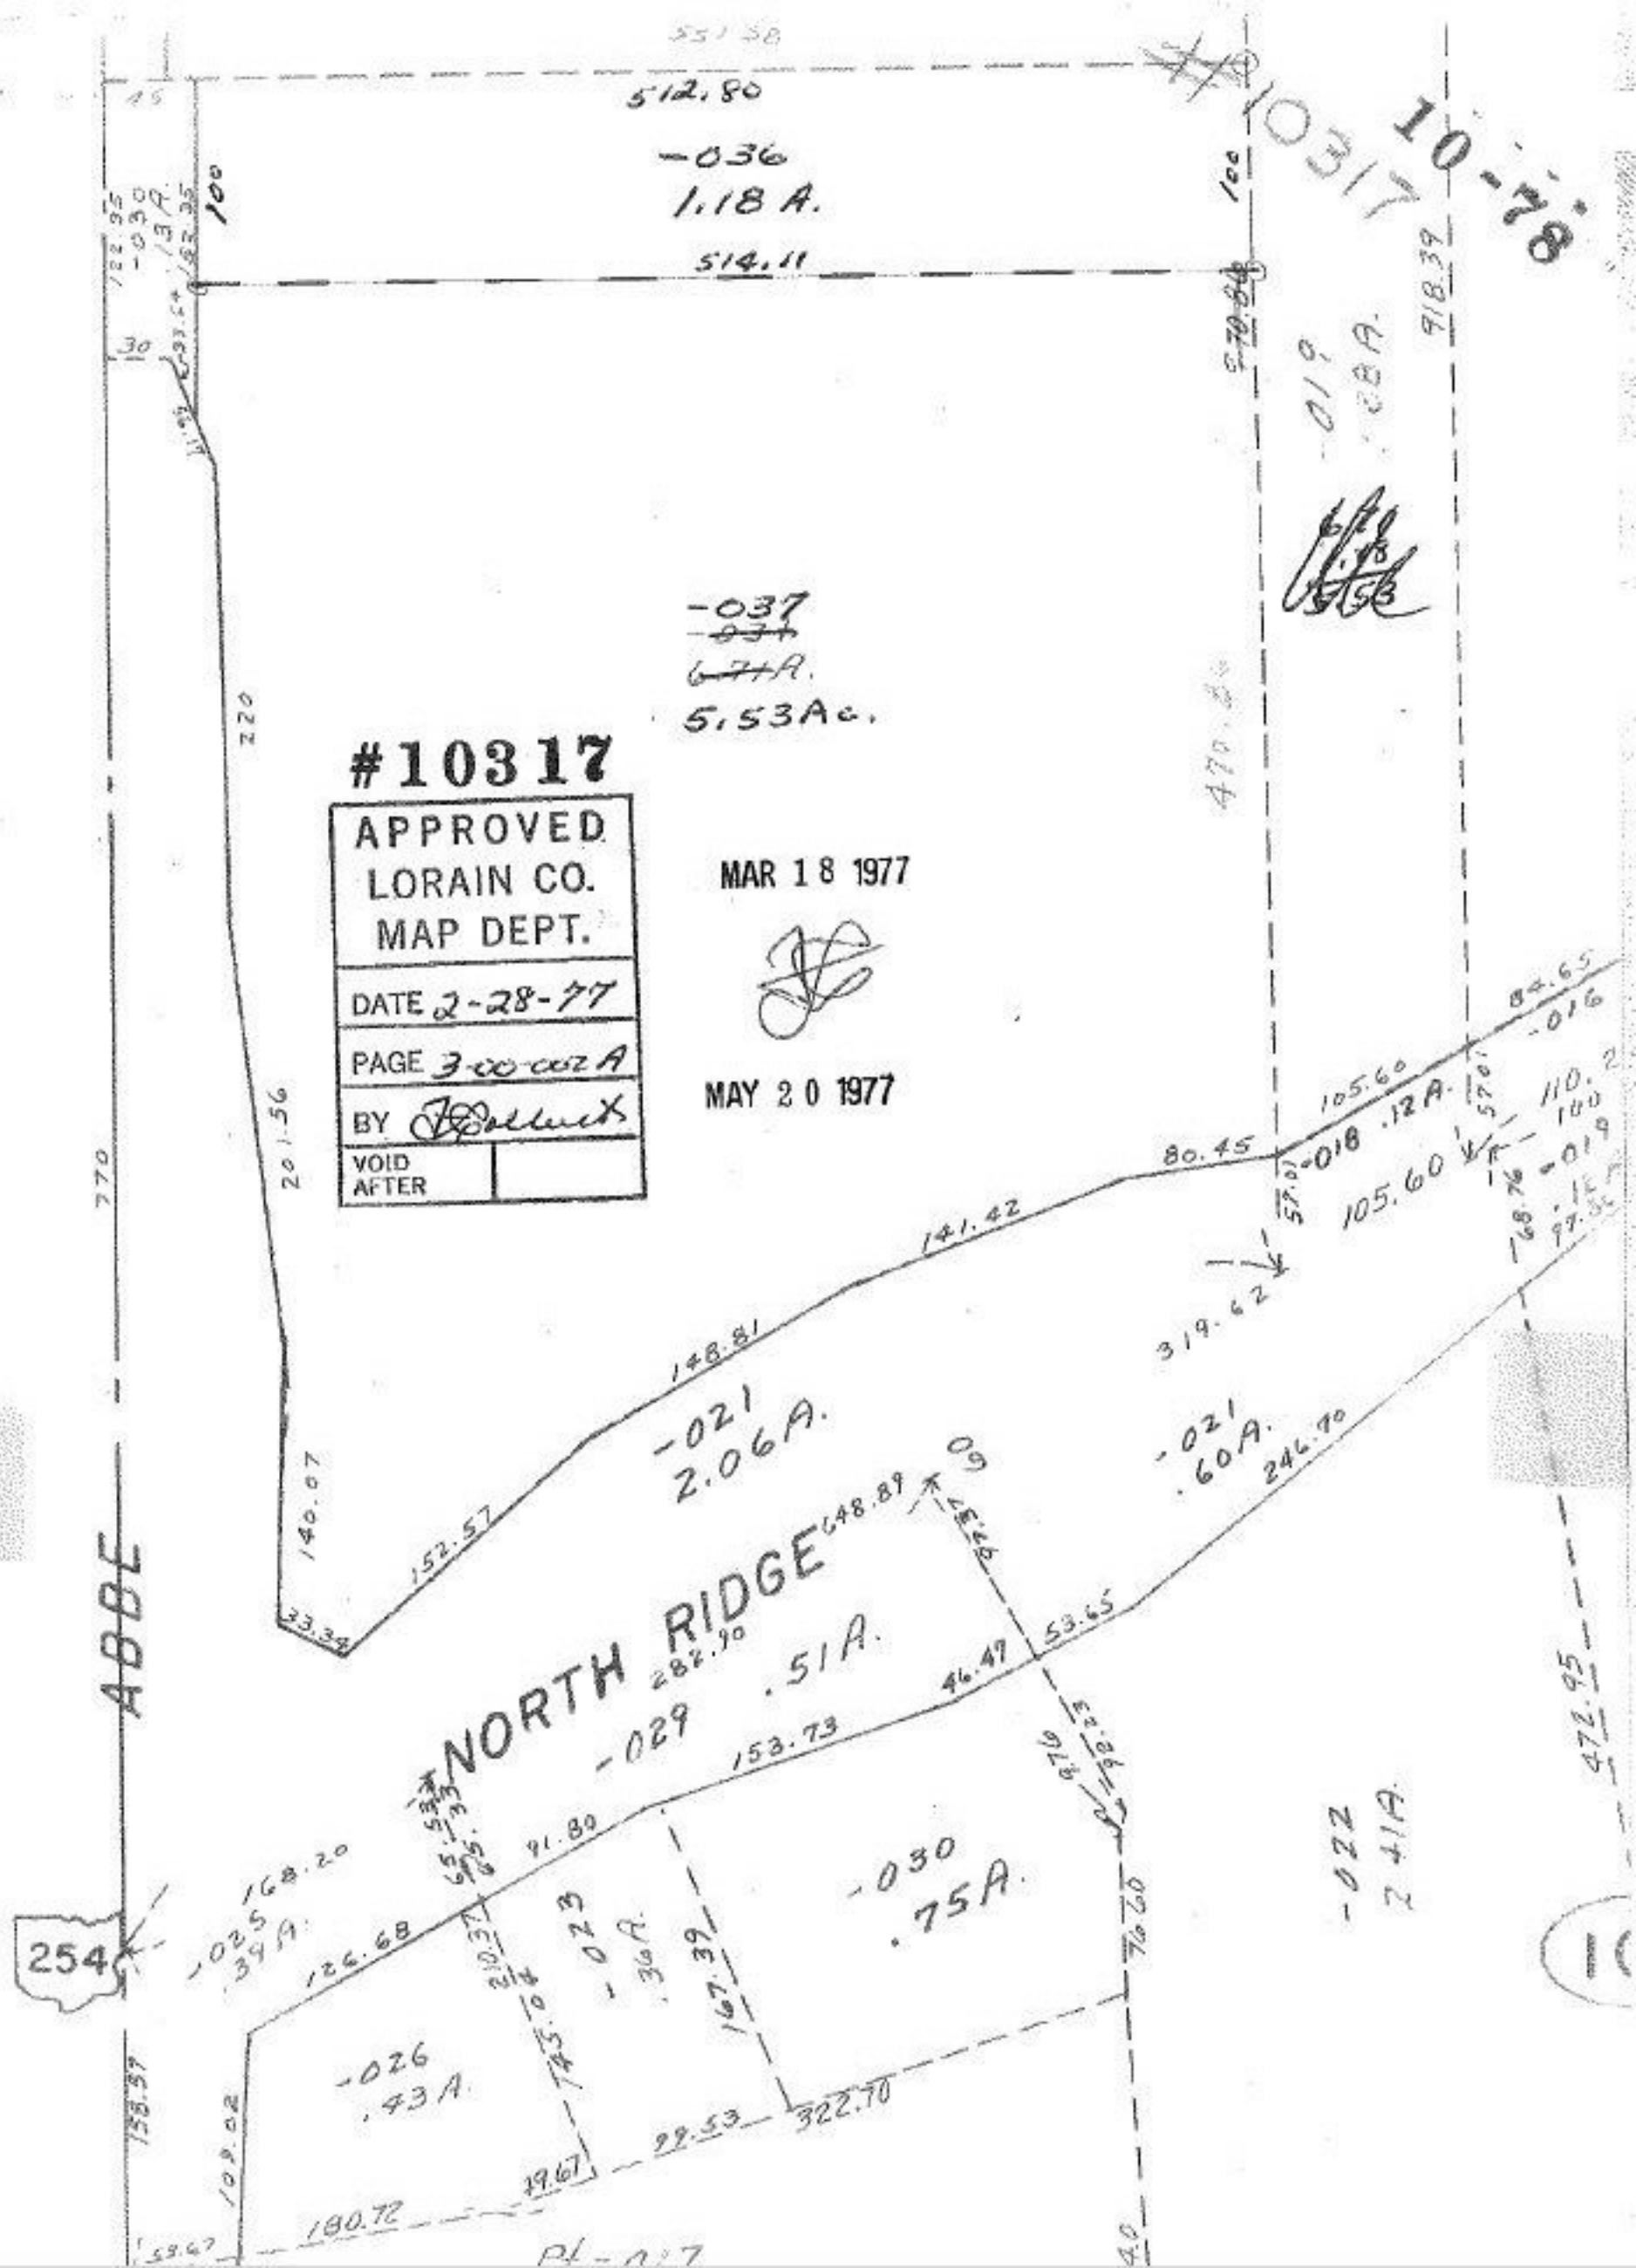

#10317
APPROVED
LORAIN CO.
MAP DEPT.
DATE 2-28-77
PAGE 3-00-002 A
BY
VOID AFTER
MAR 18 1977
MAY 20 1977
10-78
512.80
-036
1.18 A.
514.11
-037
5.53Ac.
-021
2.06A.
-021
.60A.
NORTH RIDGE
-029
.51A.
-030
.75A.
-022
2.41A.
-026
.43A.
-025
.39A.
-023
.36A.
-018
.12A.
ABBE
254