10323

10-78

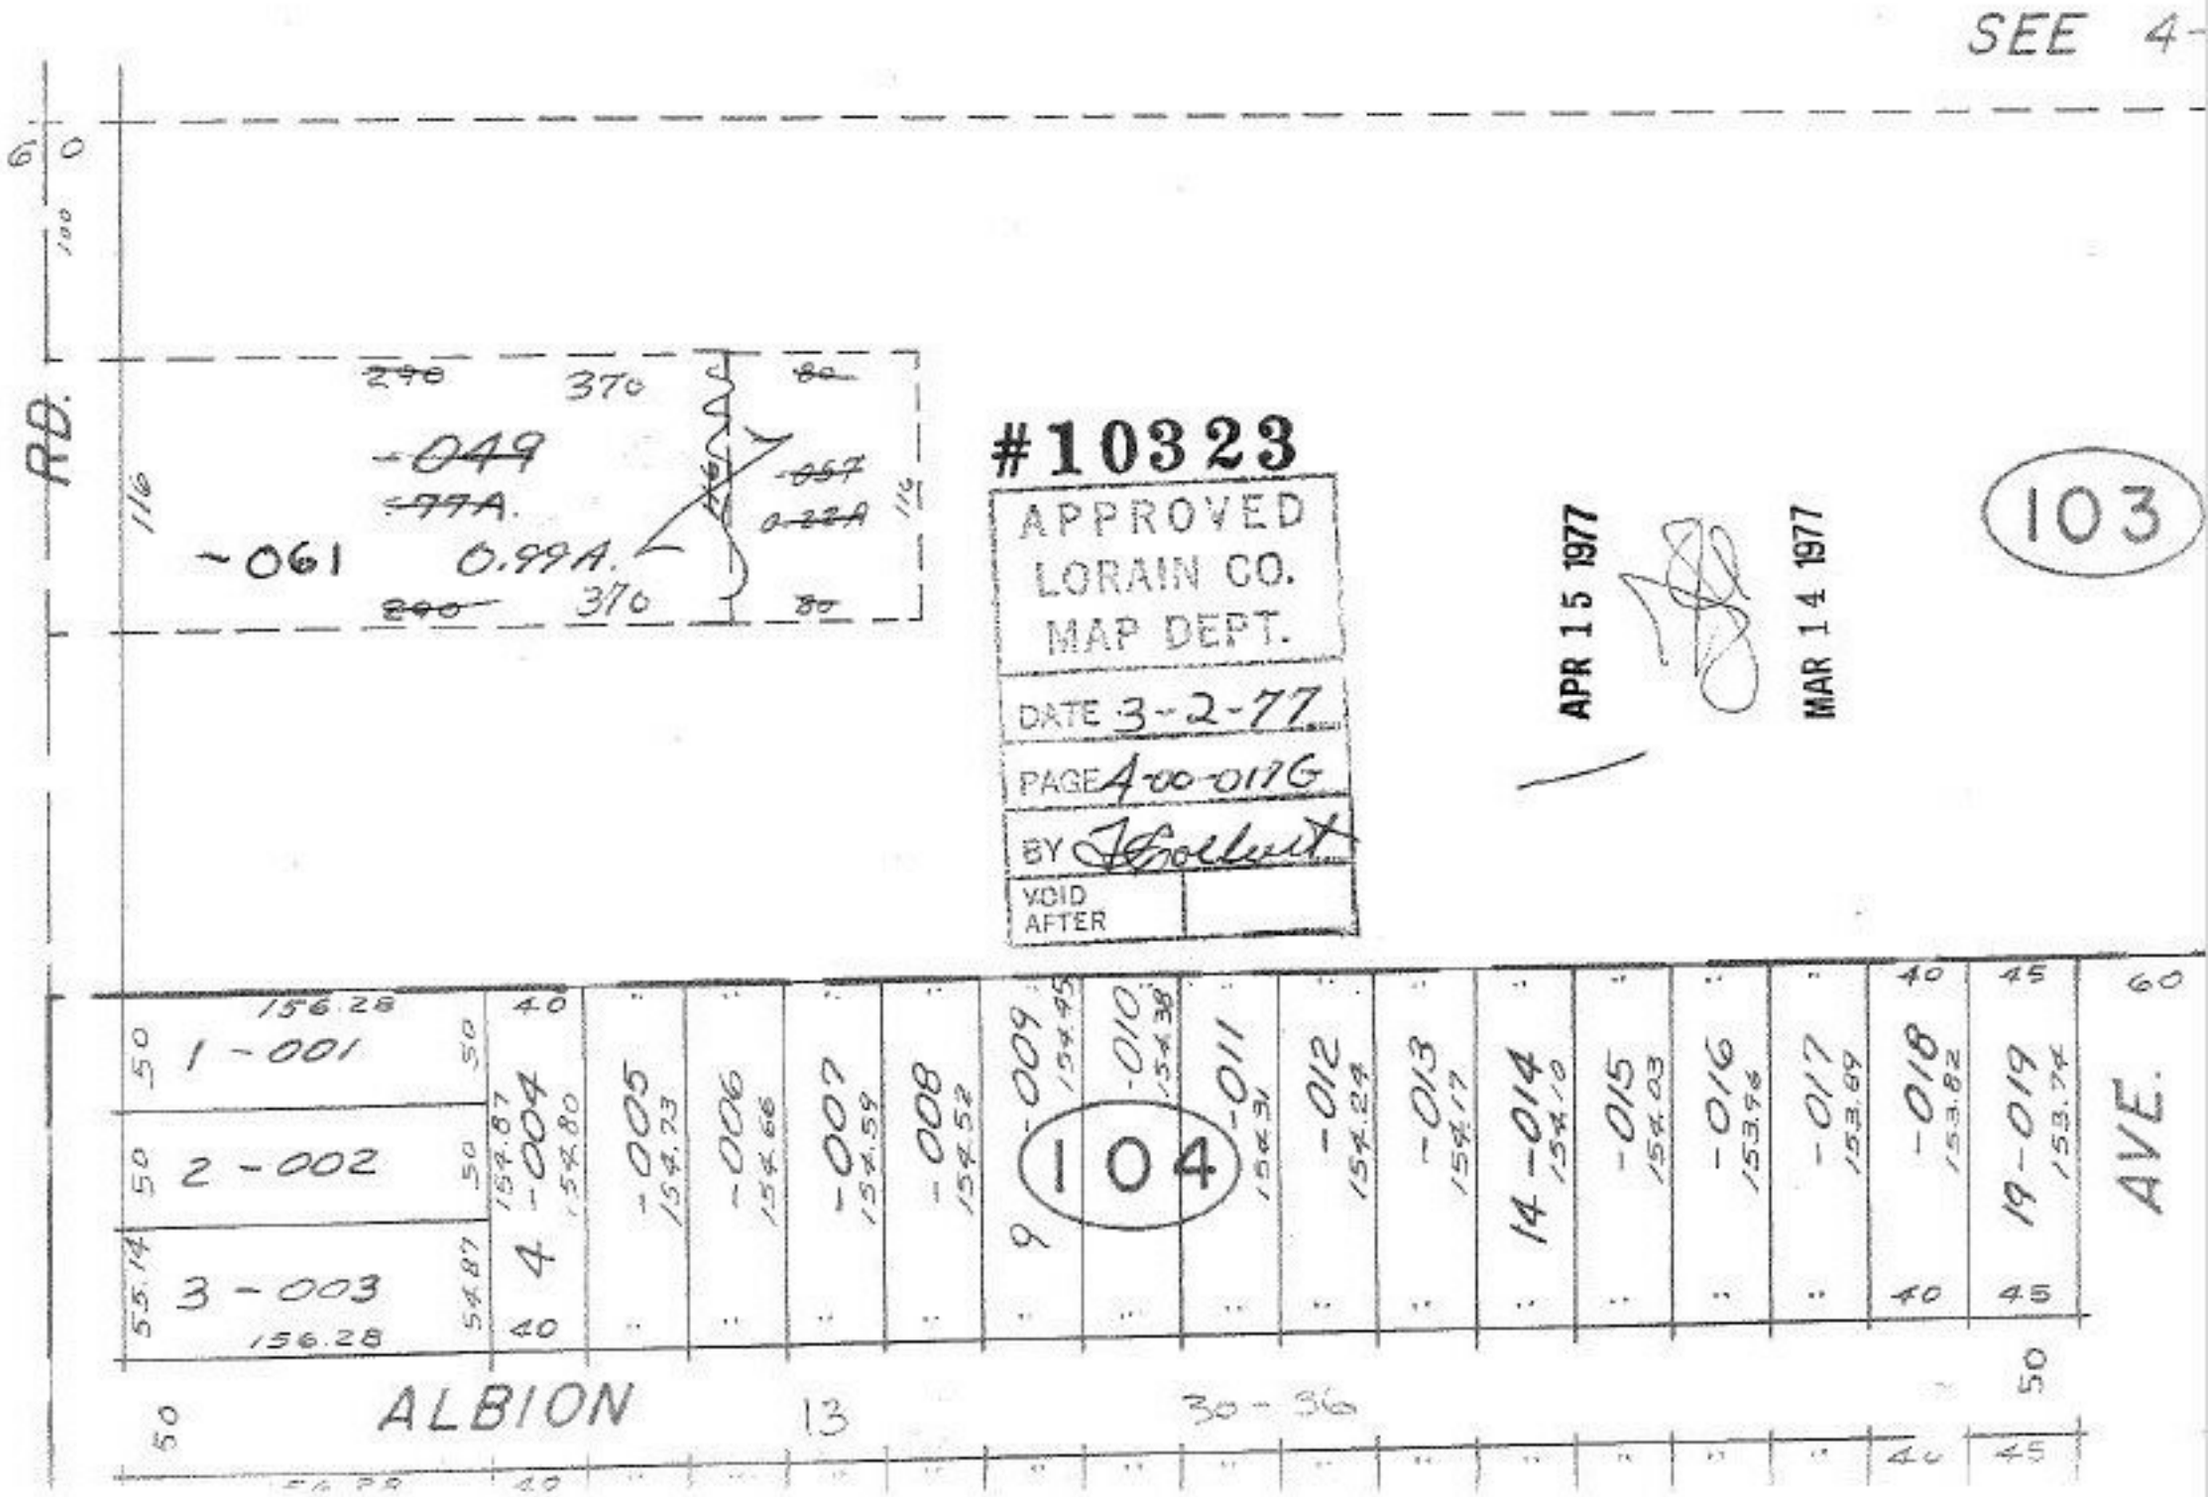

SEE 4-
RD.
60
100
116
~049
~77A.
~061
0.99A.
~290
370
80
~057
0.22A
#10323
APPROVED
LORAIN CO.
MAP DEPT.
DATE 3-2-77
PAGE 4-00-017G
BY
VOID AFTER
APR 15 1977
MAR 14 1977
103
1-001
2-002
3-003
4-004
-005
-006
-007
-008
9
-009
-010
-011
-012
-013
14-014
-015
-016
-017
-018
19-019
104
156.28
154.87
154.80
154.73
154.66
154.59
154.52
154.45
154.38
154.31
154.24
154.17
154.10
154.03
153.96
153.89
153.82
153.74
55.14
54.87
40
45
50
60
AVE.
ALBION
13
30-36