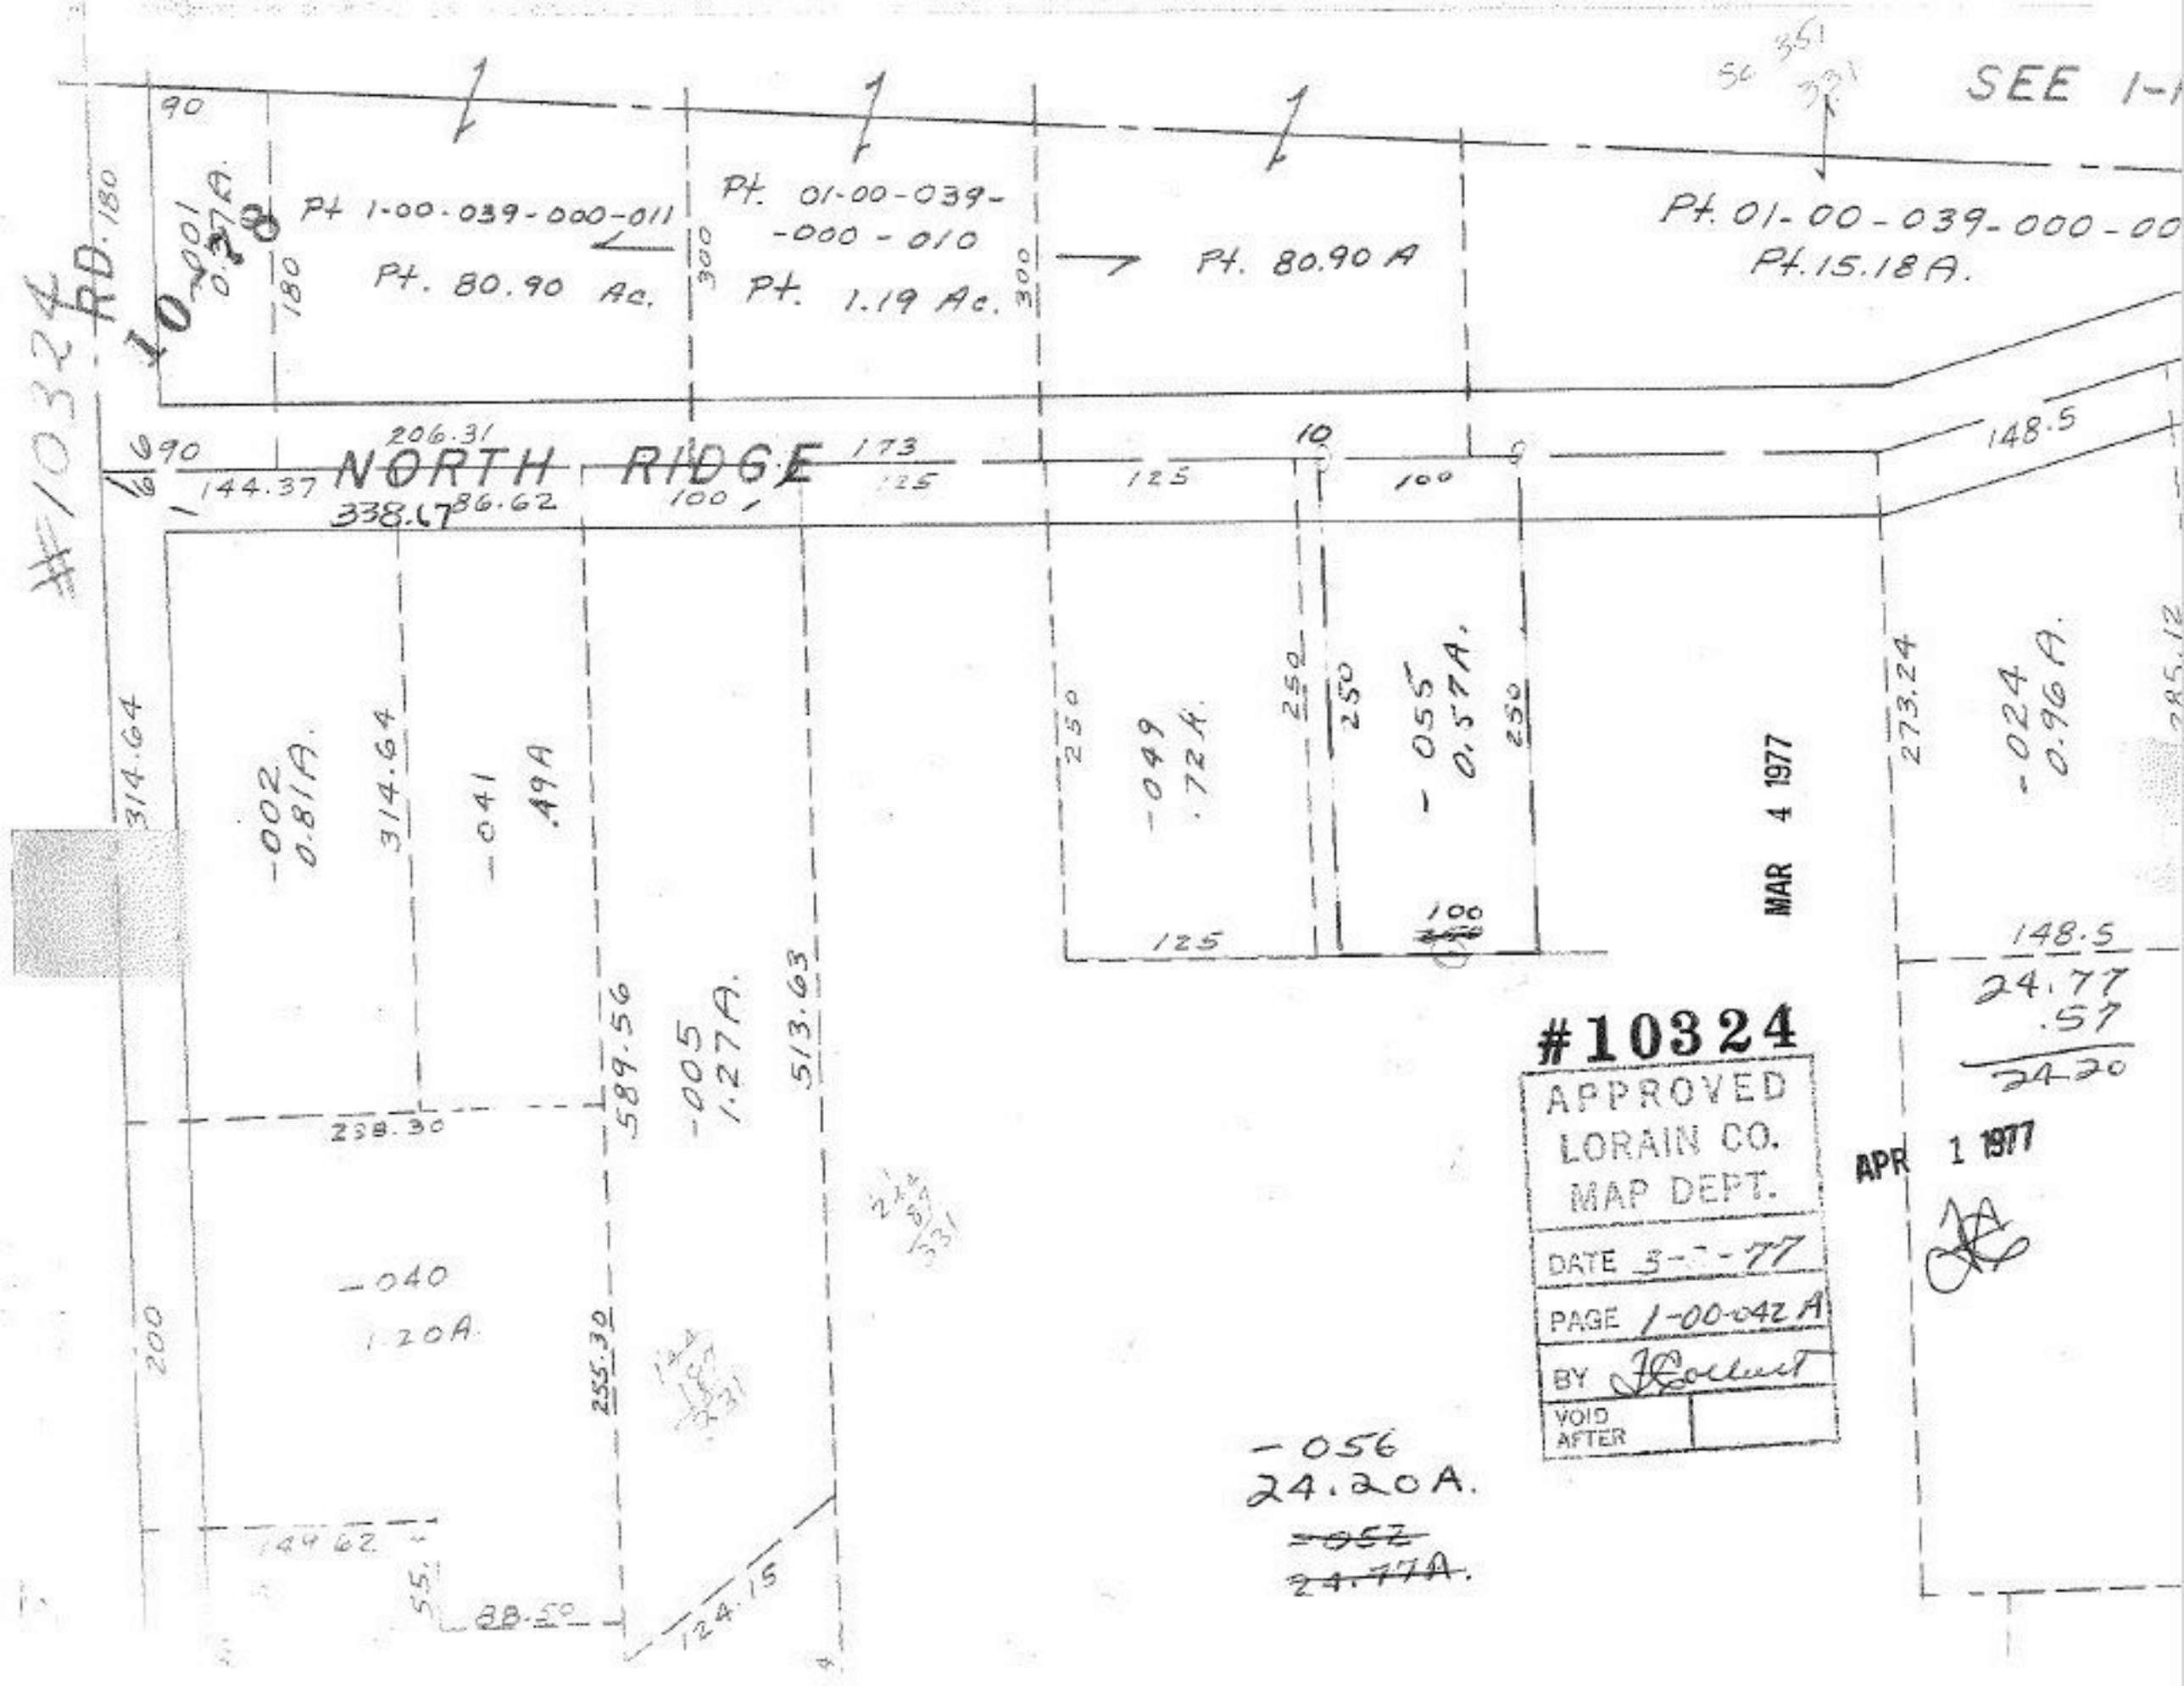

SEE 1-
Pt 1-00-039-000-011
Pt. 80.90 Ac.
Pt. 01-00-039-
-000-010
Pt. 1.19 Ac.
Pt. 80.90 A
Pt. 01-00-039-000-00
Pt. 15.18 A.
NORTH RIDGE
RD.
#10324
-002
0.81A.
-041
.49A
-049
.72A.
-055
0.57A.
-024
0.96A.
-040
1.20A.
-056
24.20A.
~~-052~~
~~24.77A.~~
-005
1.27A.
MAR 4 1977
APR 1 1977
#10324
APPROVED
LORAIN CO.
MAP DEPT.
DATE 3-7-77
PAGE 1-00-042 A
BY
VOID AFTER