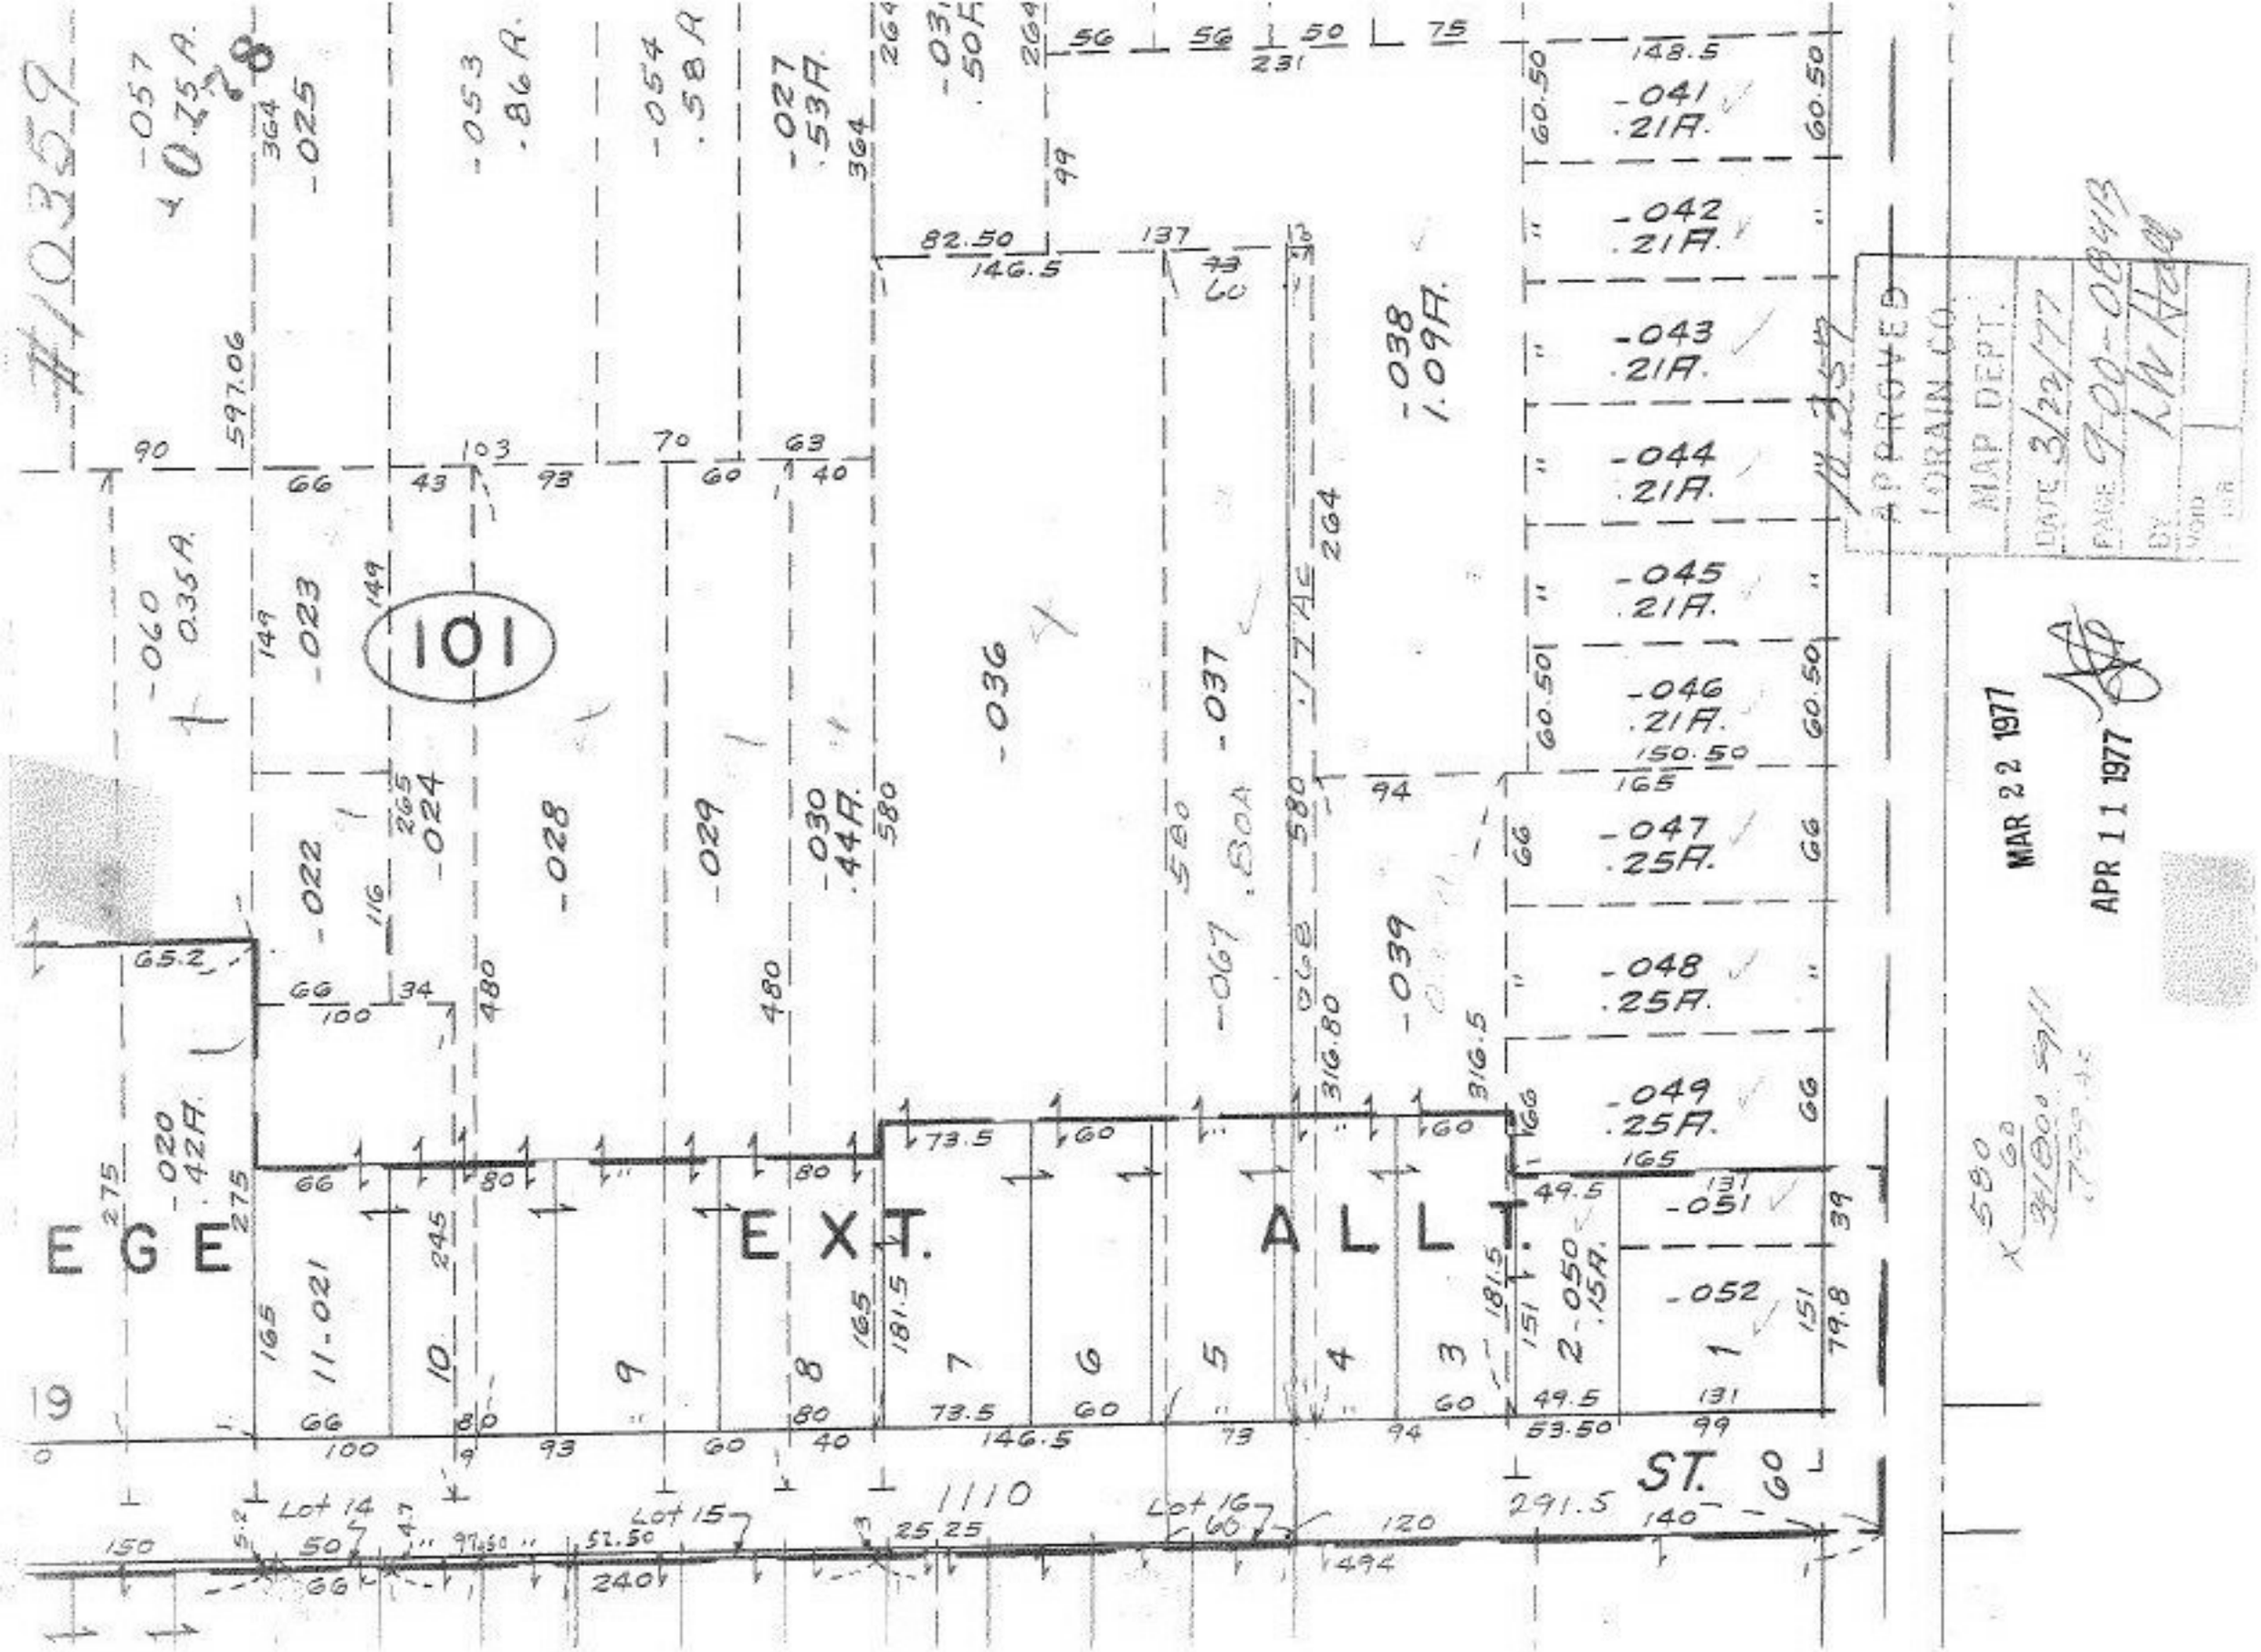

#10359
101
EGE
EXT.
ALLT.
ST.
APPROVED
LORAIN CO.
MAP DEPT.
DATE 3/22/77
PAGE 9-00-084B
MAR 22 1977
APR 11 1977