


10 363

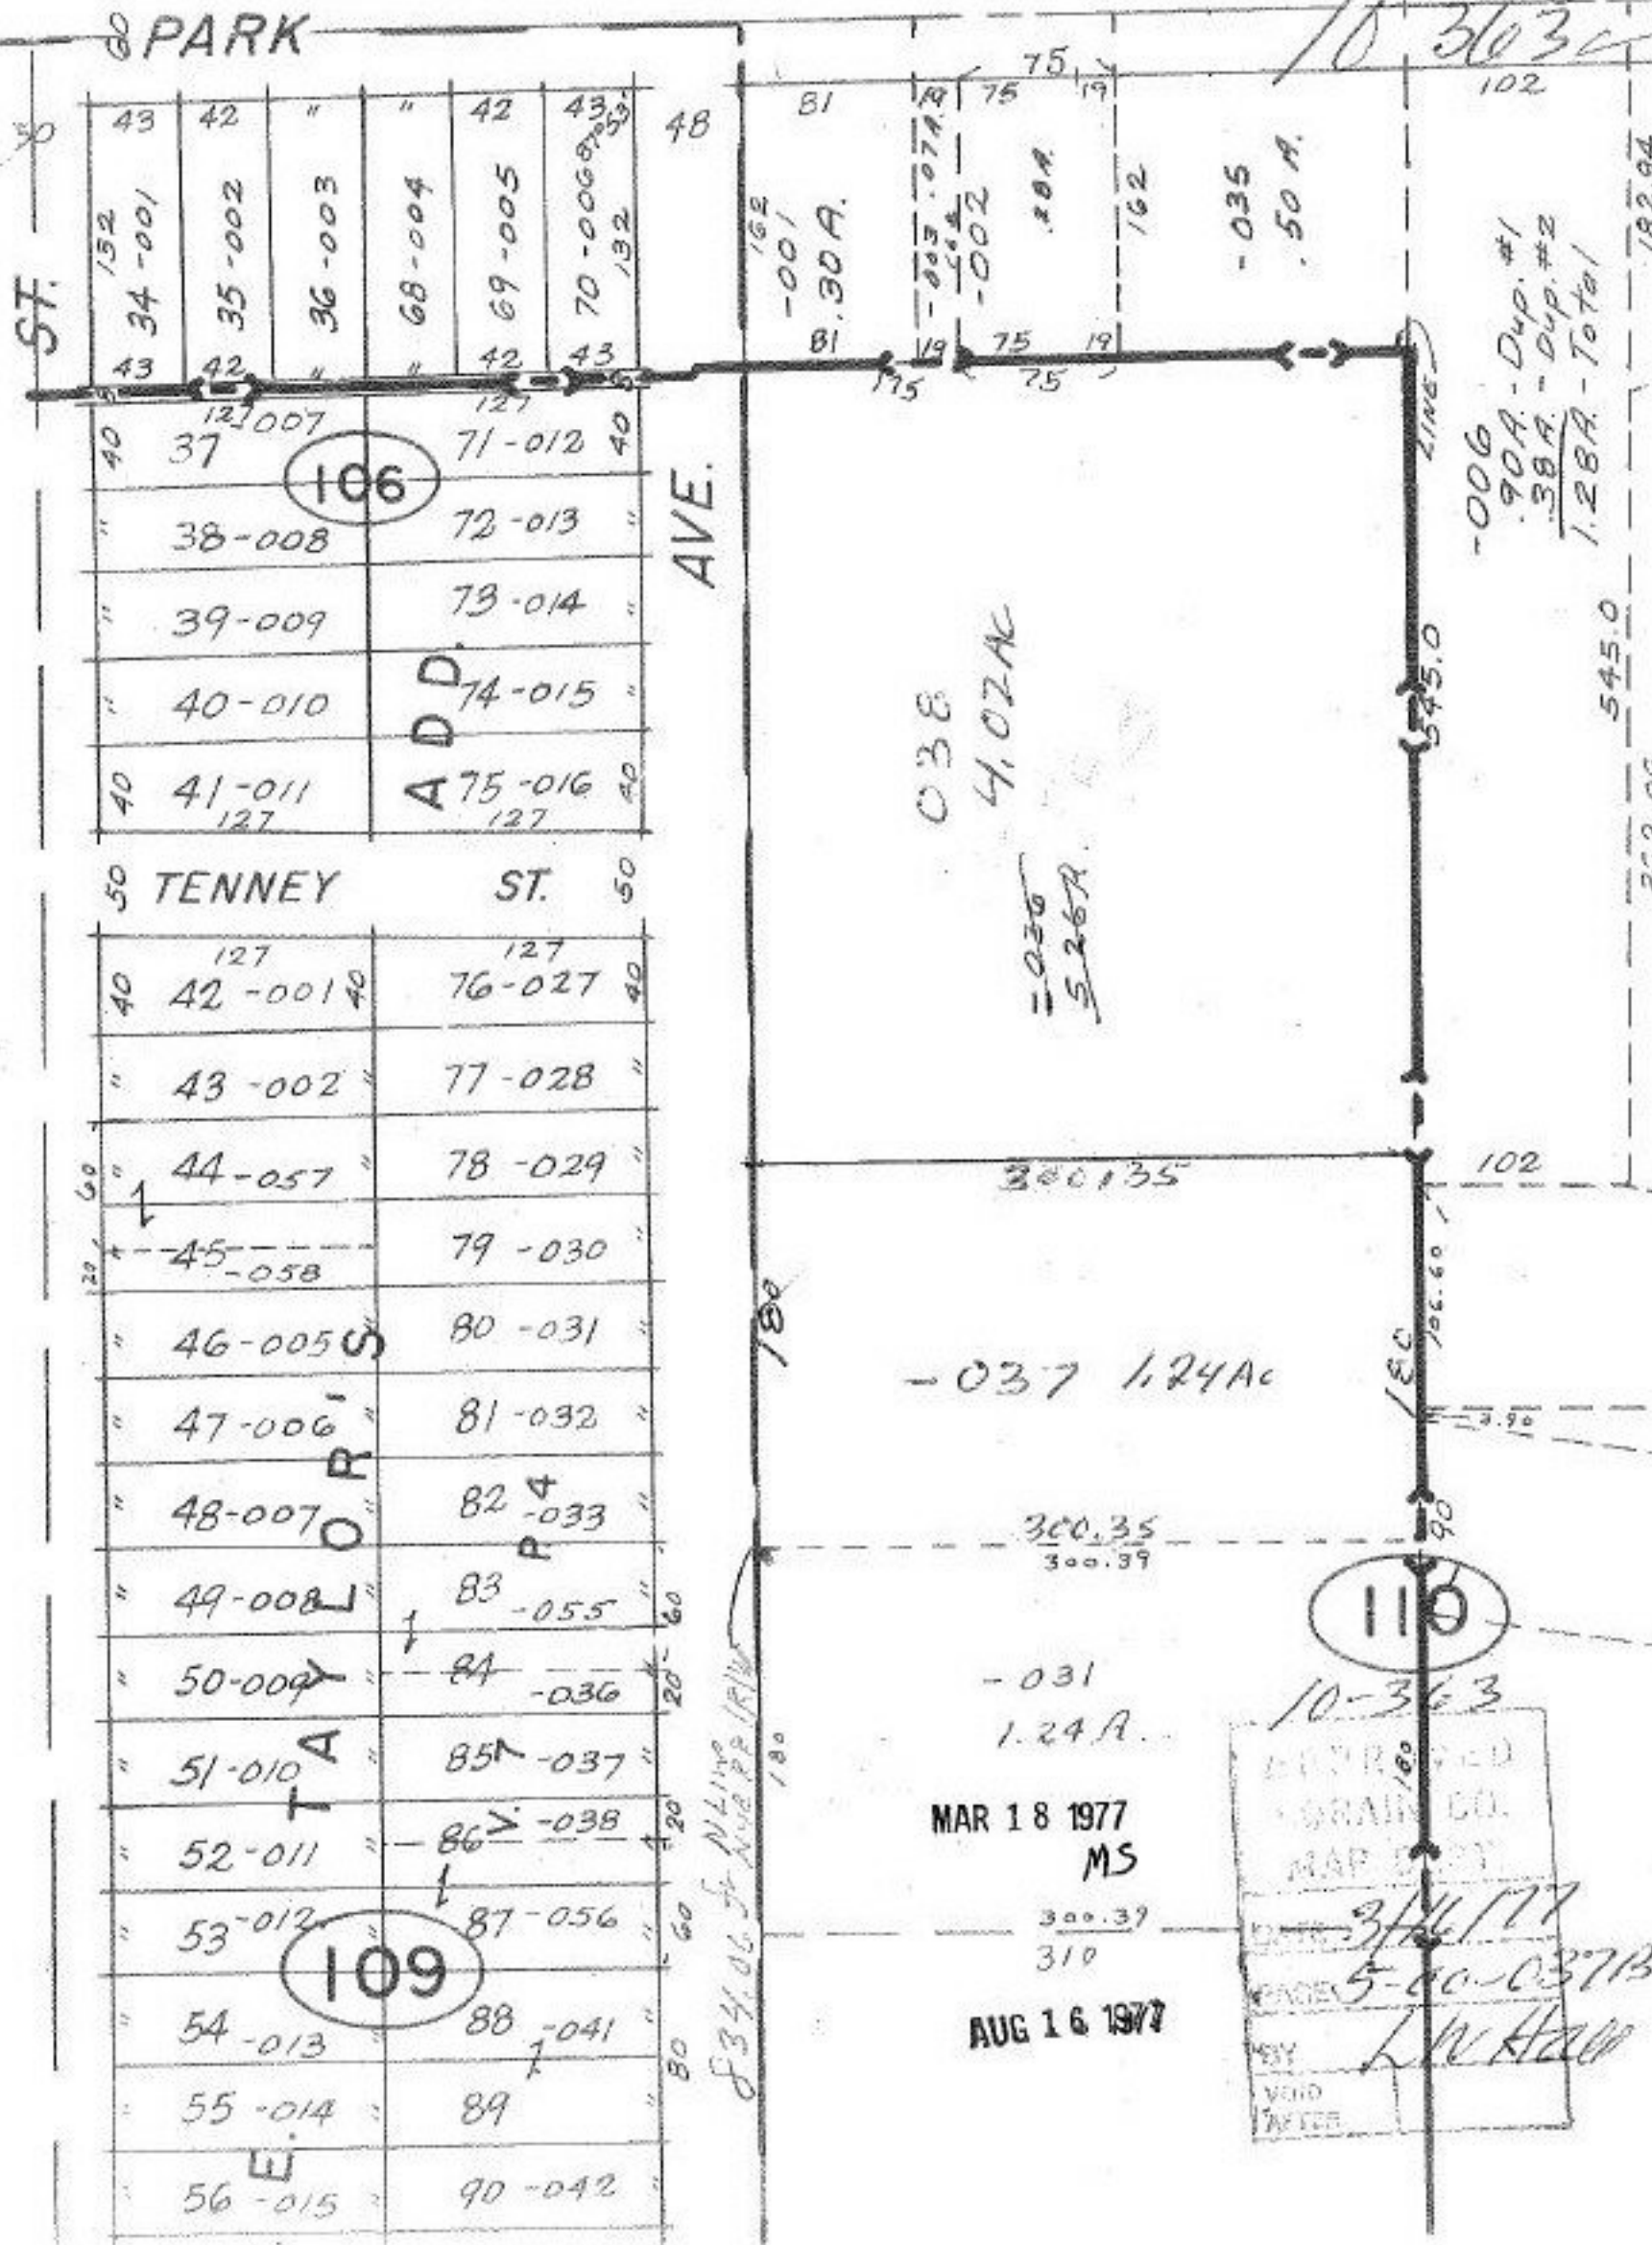

-006
 .90A - Dup. #1
 .38A - Dup. #2
 1.28A - Total

182.94
 545.0
 352.06

834.06 ft N Line Ave. P.P. 1/11/77

U-037-A