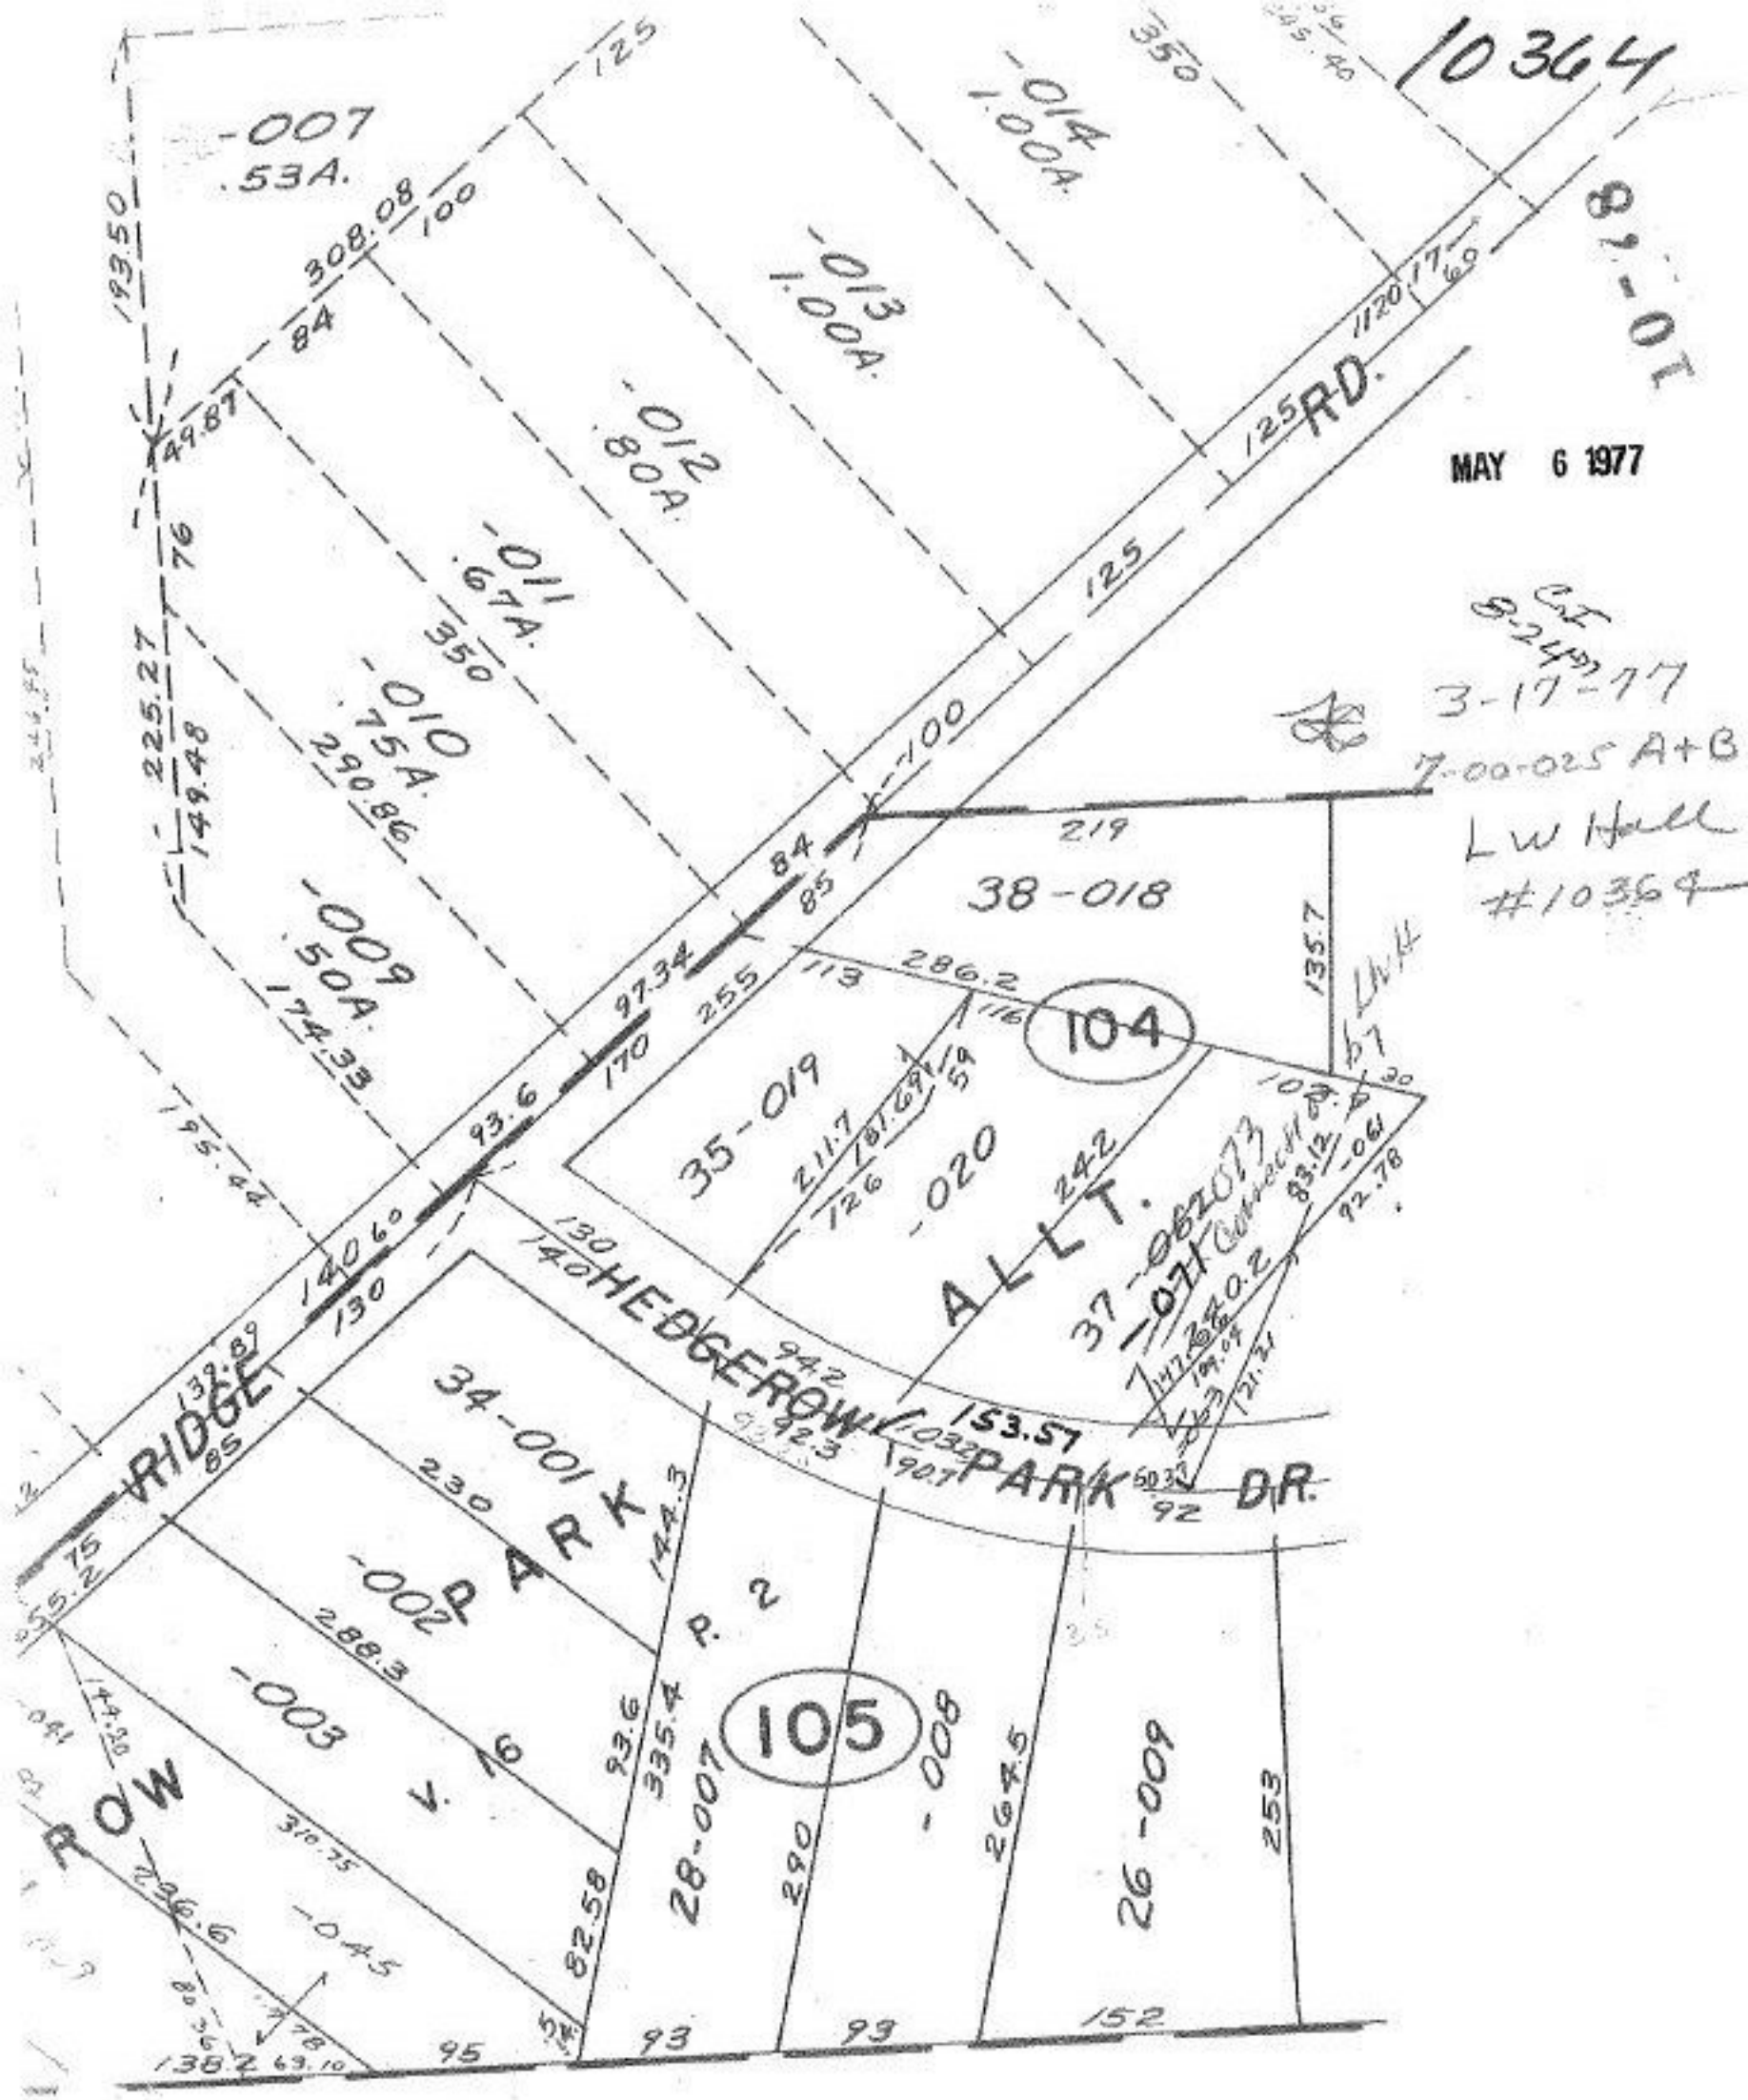
10364
MAY 6 1977
3-17-77
7-00-025 A+B
LW Hall
#10364
-007
.53A.
-014
1.00A.
-013
1.00A.
-012
.80A.
-011
.67A.
-010
.75A.
-009
.50A.
38-018
104
35-019
-020
ALLY.
37-071
34-001
-002
-003
-045
28-007
-008
26-009
105
RD.
HEDGEROW
PARK
DR.
RIDGE
ROW
PARK
V. 16
P. 2