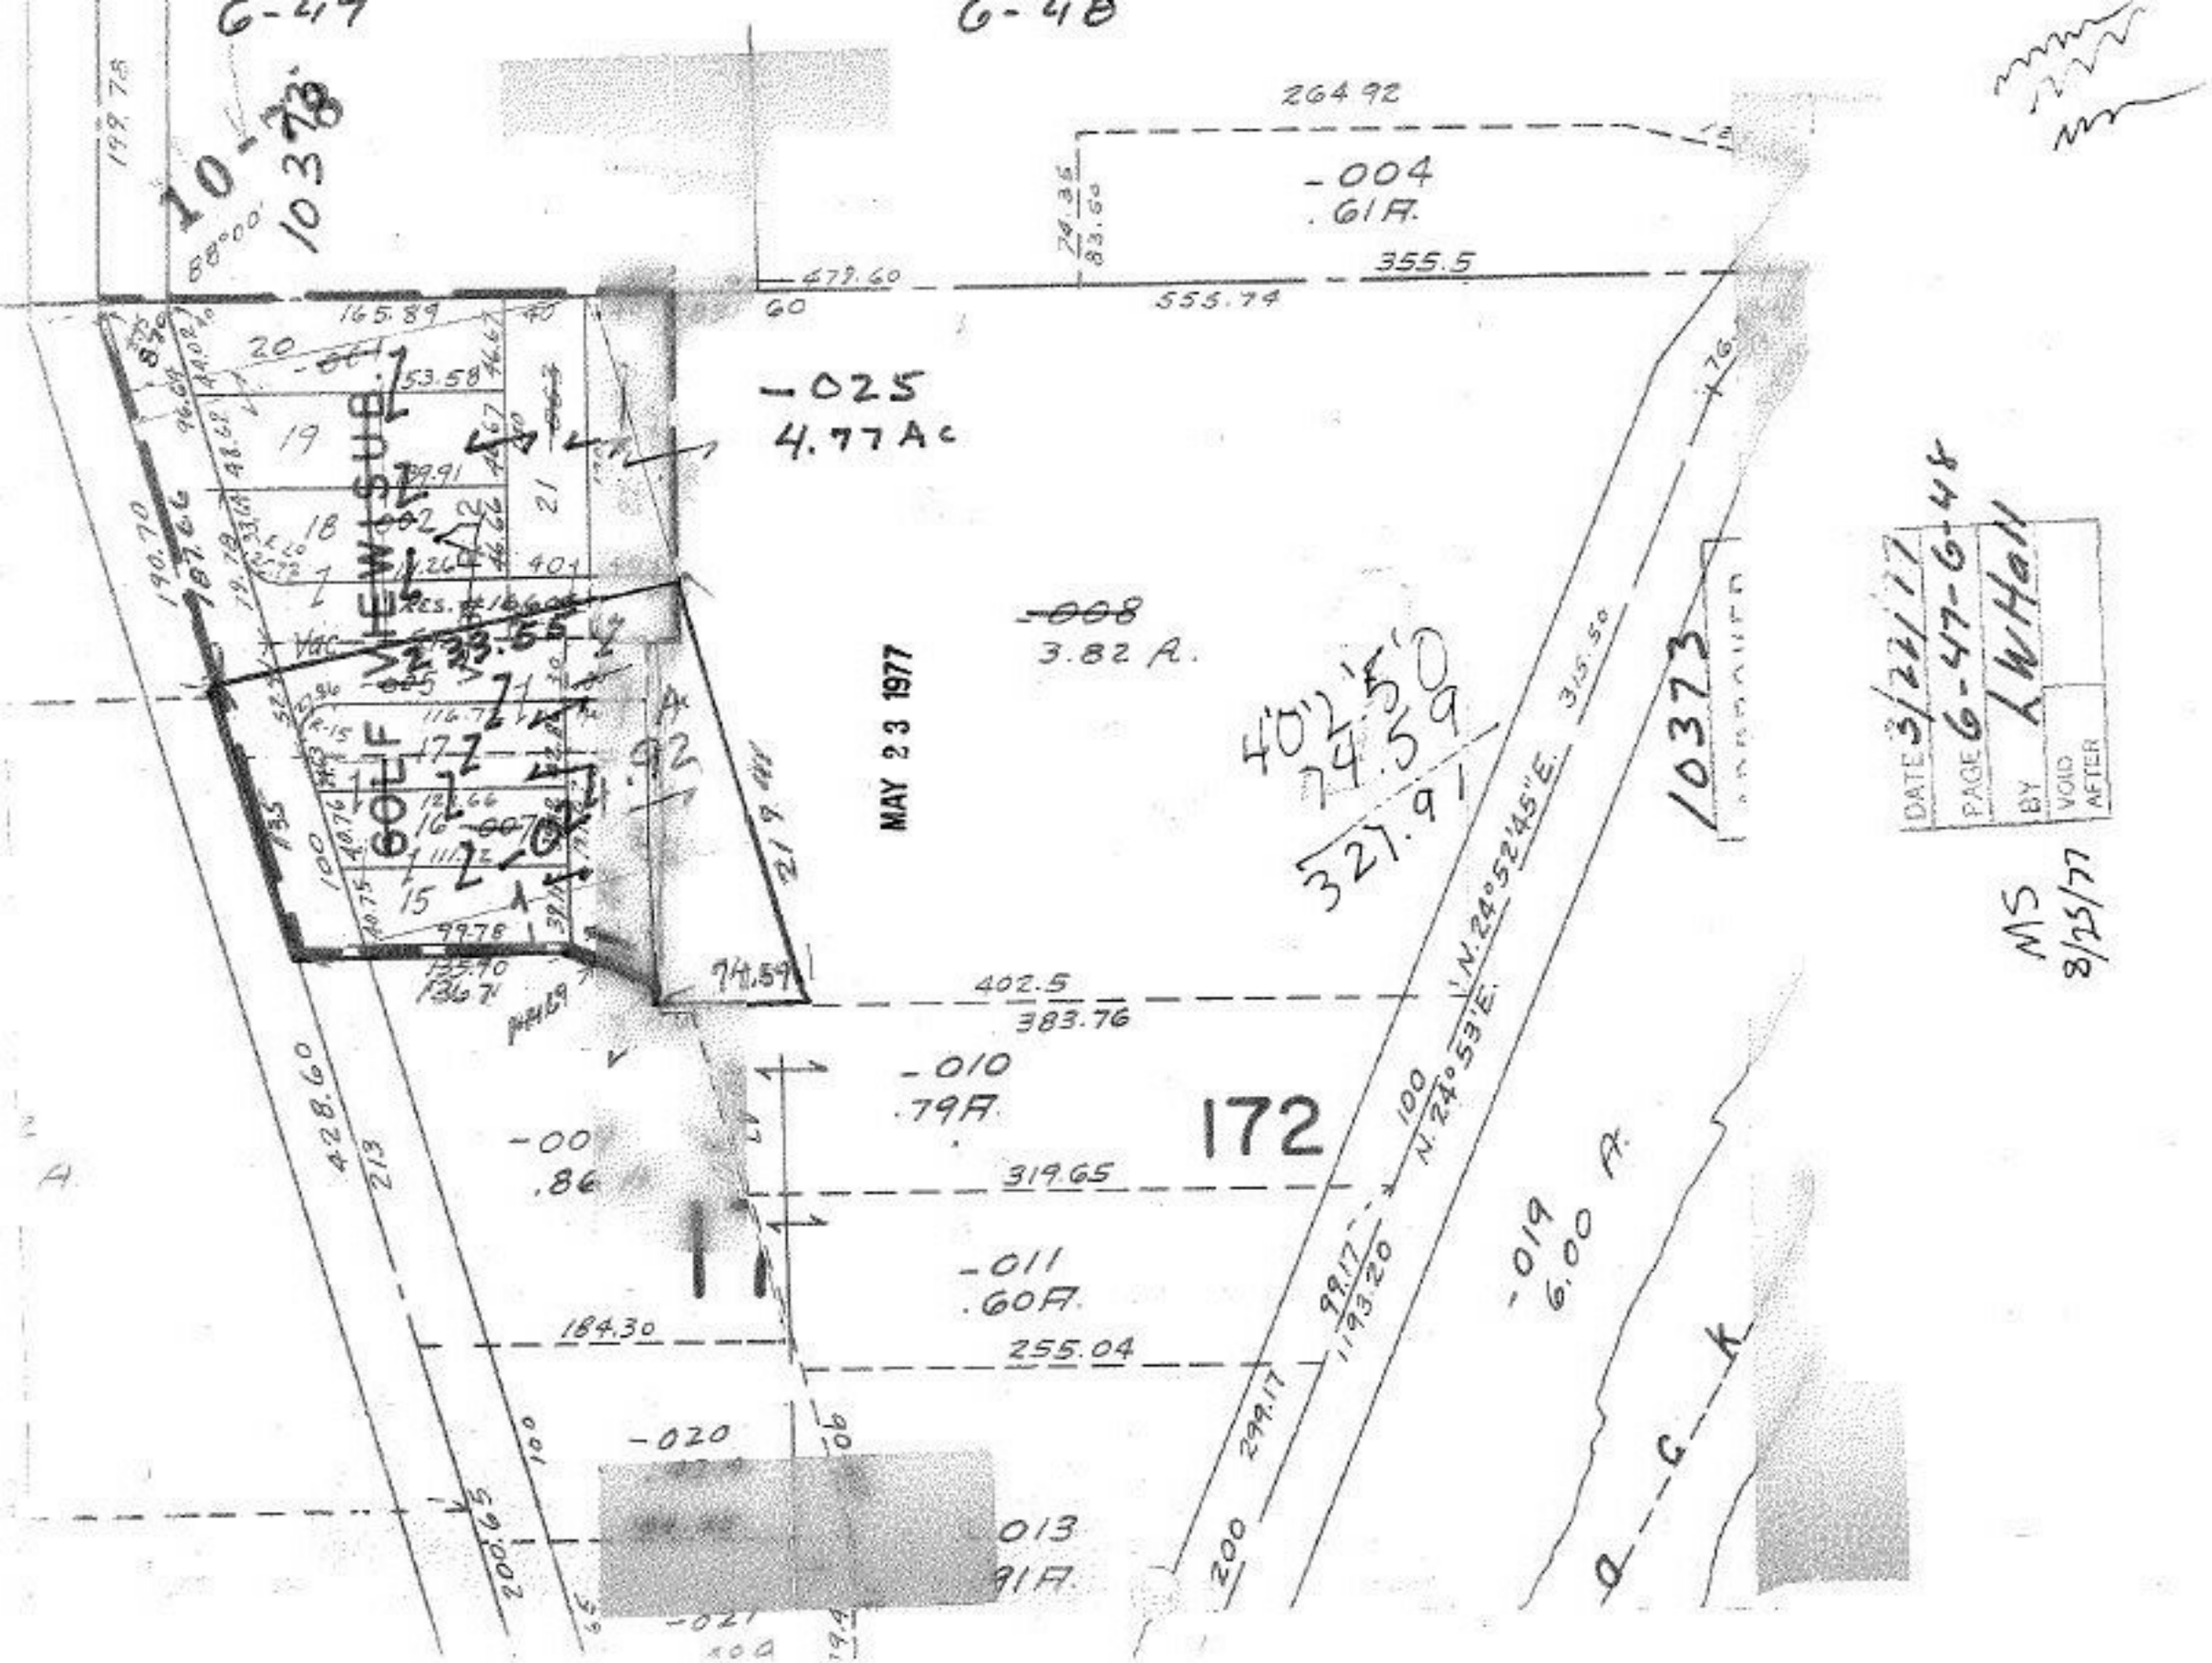

6-47
6-48
10-73
10378
264.92
-004
.61A.
355.5
555.74
479.60
-025
4.77Ac
-008
3.82 A.
MAY 23 1977
GOLF VIEW SUB.
233.55
402.5
383.76
-010
.79A.
172
319.65
-011
.60A.
184.30
255.04
-020
-013
.91A.
-019
6.00 A.
10373
N.24°52'45"E.
N.24°53'E.
315.50
299.17
1193.20
99.17
200
100
428.60
213
200.65
74.59
327.91
DATE 3/22/77
PAGE 6-47-6-48
BY LWHall
VOID AFTER
MS
8/25/77