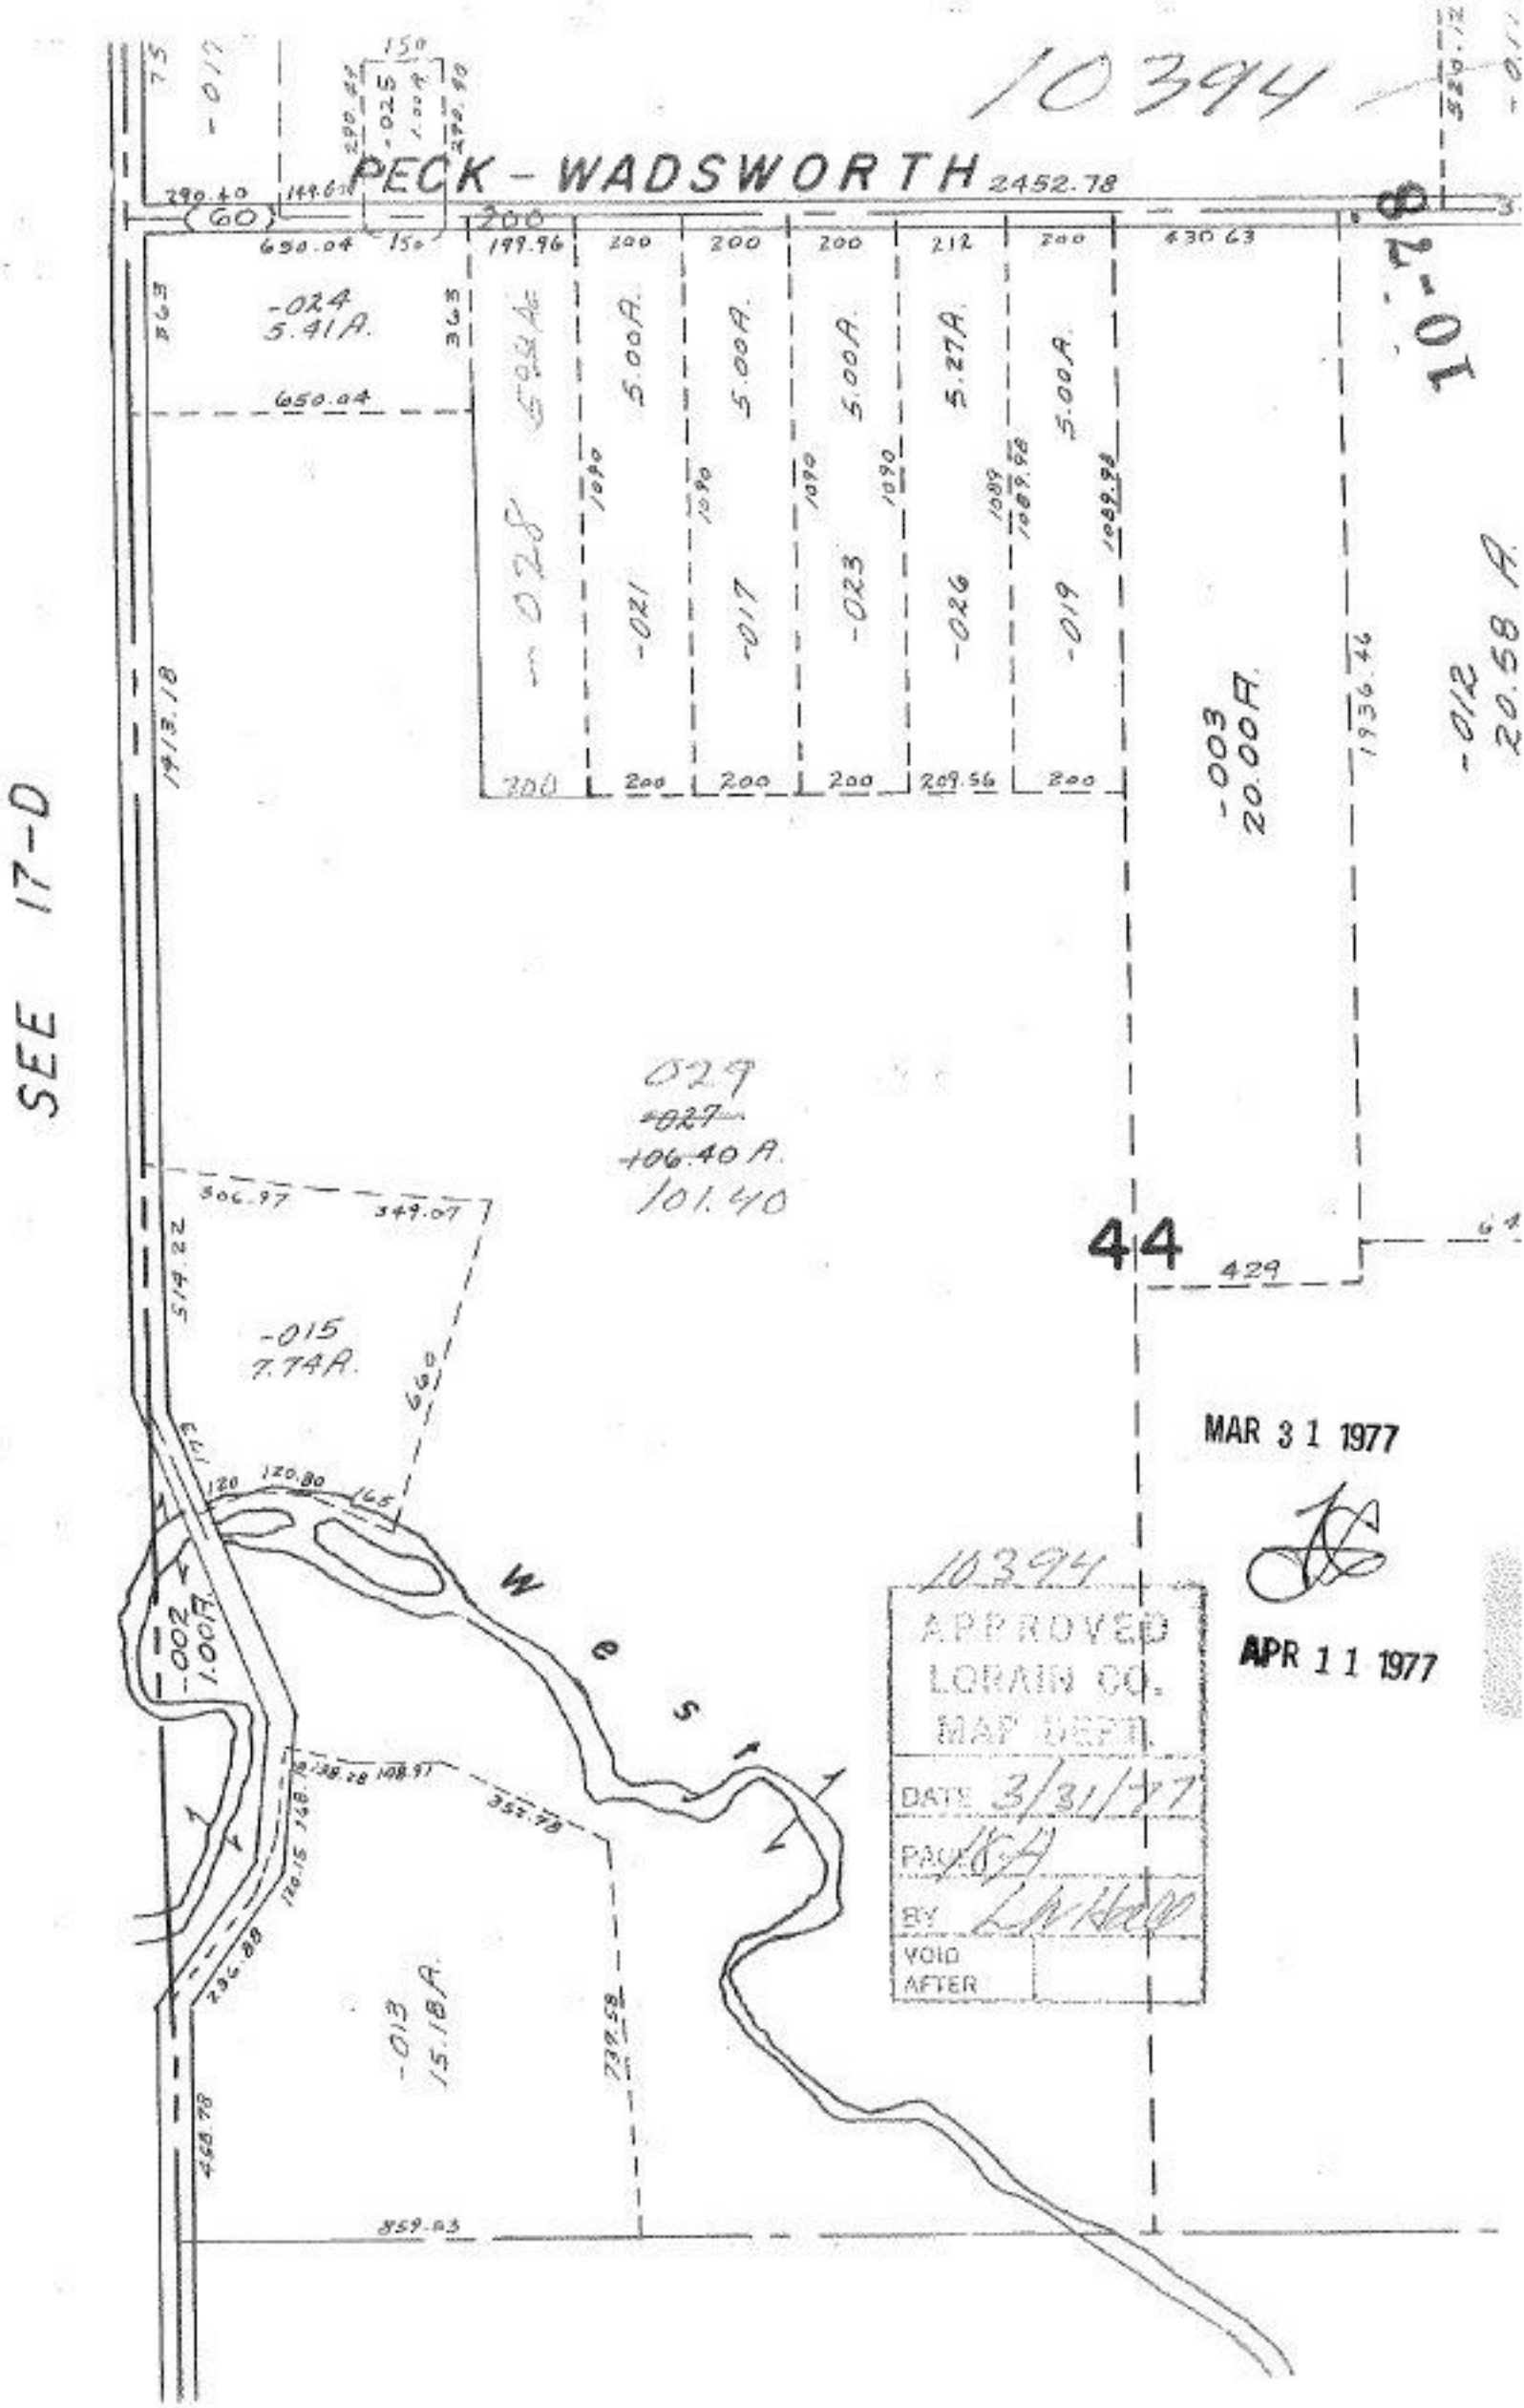
10394
PECK - WADSWORTH 2452.78
SEE 17-D
10-78
-024
5.41A.
-028
5.00A.
-021
5.00A.
-017
5.00A.
-023
5.27A.
-026
5.00A.
-019
-003
20.00A.
-012
20.58 A.
029
~~-027~~
~~106.40 A.~~
101.40
-015
7.74A.
-002
1.00A.
-013
15.18A.
West
44
MAR 31 1977
APR 11 1977
10394
APPROVED
LORAIN CO.
MAP DEPT.
DATE 3/31/77
PAGE 18A
BY
VOID
AFTER